

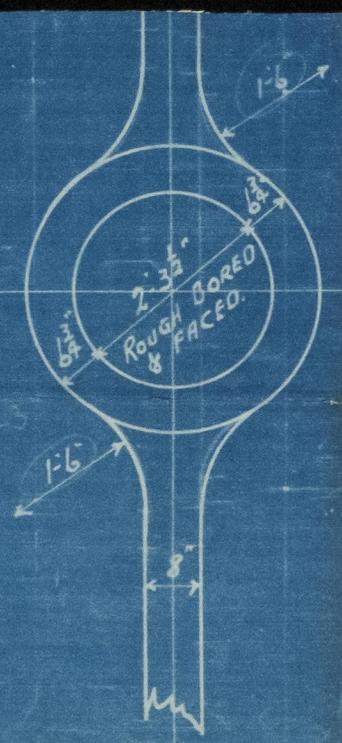
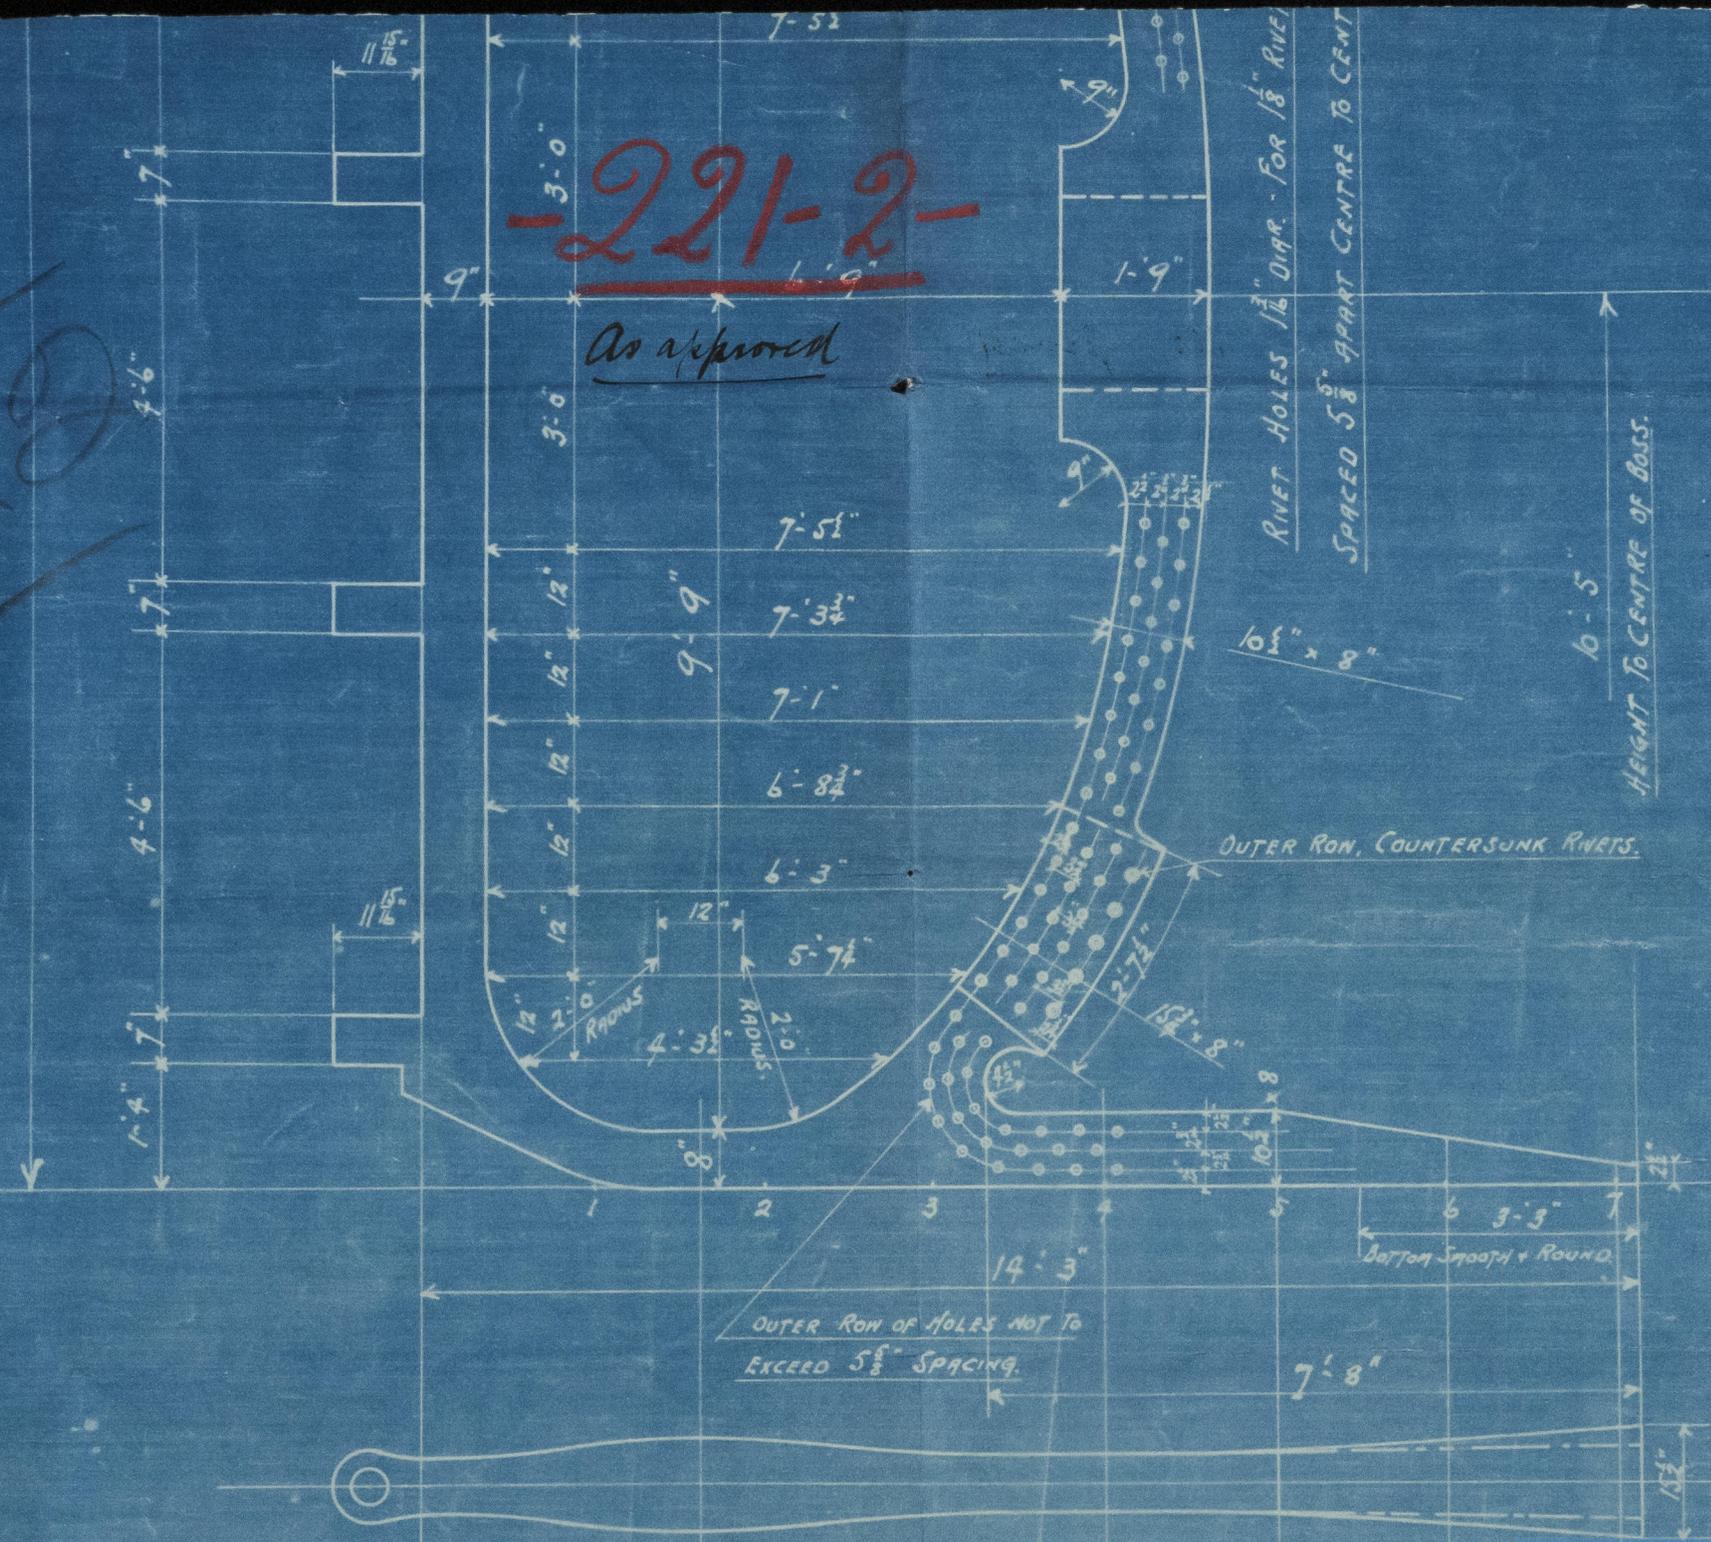


**-221-2-**

As approved

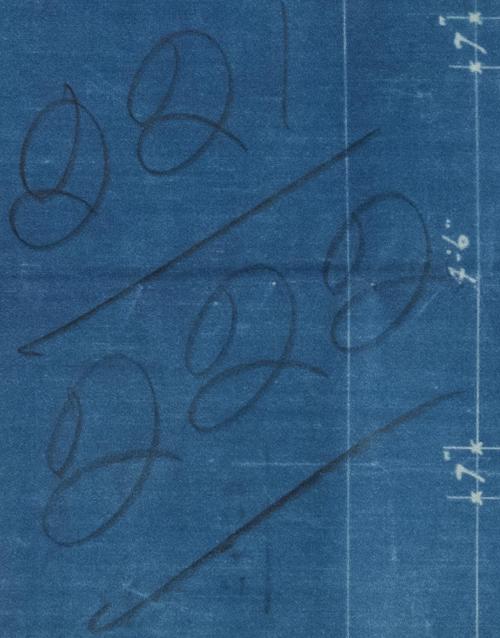

ROBERT NIMBERLAND SHIPBUILDING COMPANY LIMITED  
Date 15.11.14  
No. 1500  
HOWDON-ON-TYNE

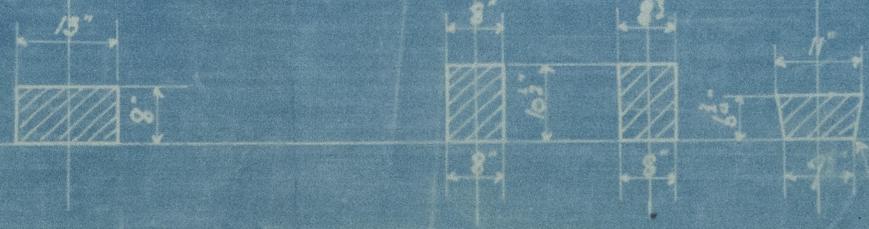

© 2021  
Lloyd's Register  
Foundation  
008648-008655-0286

SS. "MONTCALM"

NEWCASTLE ON TY

Report No. 70257.

LLOYDS REGISTER OF SHIPPING  
RECEIVED  
21 SEP 1914  
LONDON

"TEIRYU MARU"

Mitsubishi Line AB.C.

Lower part of stem frame  
as approved.

See 221+2

s.s. "Northwestern Miller"  
NEWCASTLE-ON-TYNE.

Report No 67264.

LLOYDS REGISTER OF SHIPPING  
RECEIVED  
17 APR 1914  
LONDON

LLOYDS REGISTER OF SHIPPING  
RECEIVED  
25 JUN 1915  
LONDON

LLOYDS REGISTER OF SHIPPING  
RECEIVED  
- 7 AUG 1914  
LONDON

LLOYDS REGISTER OF SHIPPING  
RECEIVED  
13 MAR 1915  
LONDON

LLOYDS REGISTER OF SHIPPING  
RECEIVED  
17 NOV 1914  
LONDON

008648-008655-0286



© 2021

Lloyd's Register  
Foundation