


VESSEL Nos 894, 895 & 896.

STERN FRAME


SCALES $\frac{1}{2}'' = 1 \text{ FT}$ & $3'' = 1 \text{ FT}$

Lloyd's Register

CASTING TO BE OF BEST QUALITY STEEL TO ~~ENTER CONTRACT~~ OWNER'S APPROVAL.
RIVET HOLES 17/16" DIA UNLESS NOTED OTHERWISE TO BE
APPROVED BY OUR REPRESENTATIVE & DRILLED BY CONTRACTORS.
GUDGEONS BORED BY CONTRACTORS AS SHOWN ON PLAN.
TEMPLATE Mould WILL BE SUPPLIED GIVING FULL SIZE SECTIONS
NO RIVET HOLES TO BE DRILLED IN WAY OF BOSS
FACES OF BOSS TO BE SQUARE TO SHAFT CENTRE.

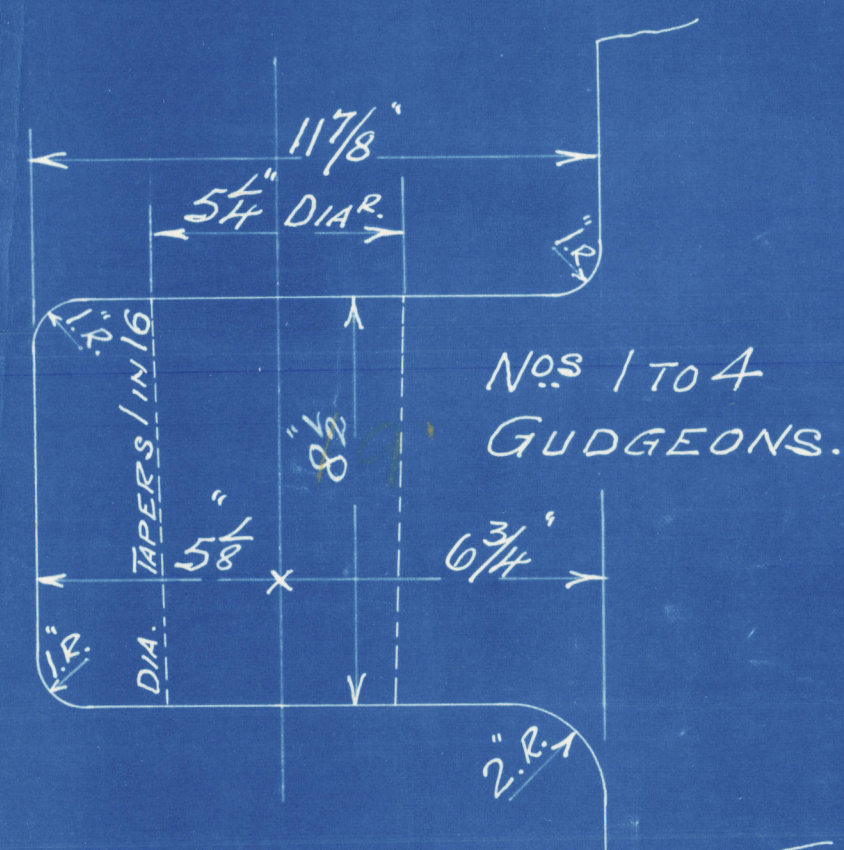

Nos 1 to 4
GUDGEONS.

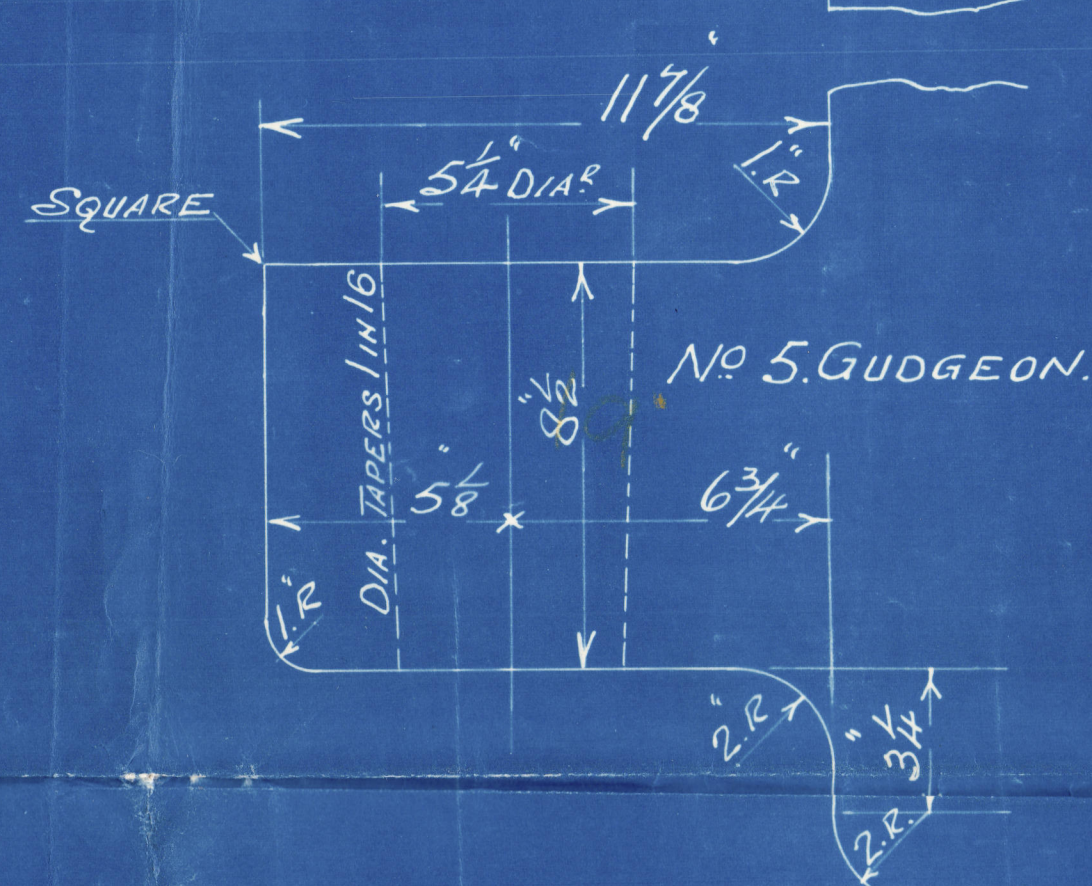

No 5. GUDGEON.

FORWARD SIDE OF BOSS.

LOOKING AFT.

T. N^o 7

Co

15/8/22

Steufrane

Cammell Laird

No 894-5.6.

S. S.

La Playa

LIVERPOOL

Report No.

86378

S. S.

La Marea

LIVERPOOL

Report No.

86683

S. S.

La Perla

LIVERPOOL

Report No.

88806



© 2021

Lloyd's Register
Foundation

008656-008668-0066


26.

Stern Frame.

I.

894-5-6.

(Lloyds)

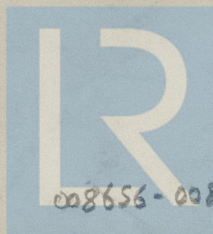

© 2021

Lloyd's Register
Foundation

008656-008668-0066