

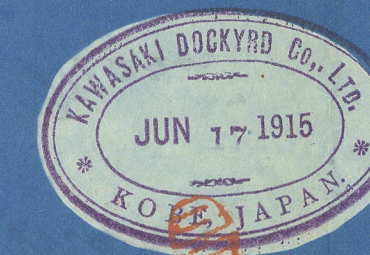


N° 380-2  
 ALTERATION OF STERN FRAME  
 & SHAFT BRACKET  
 SCALE  $\frac{1}{2}$  TO A FOOT  
 FOR DETAIL OF GUIDEONS

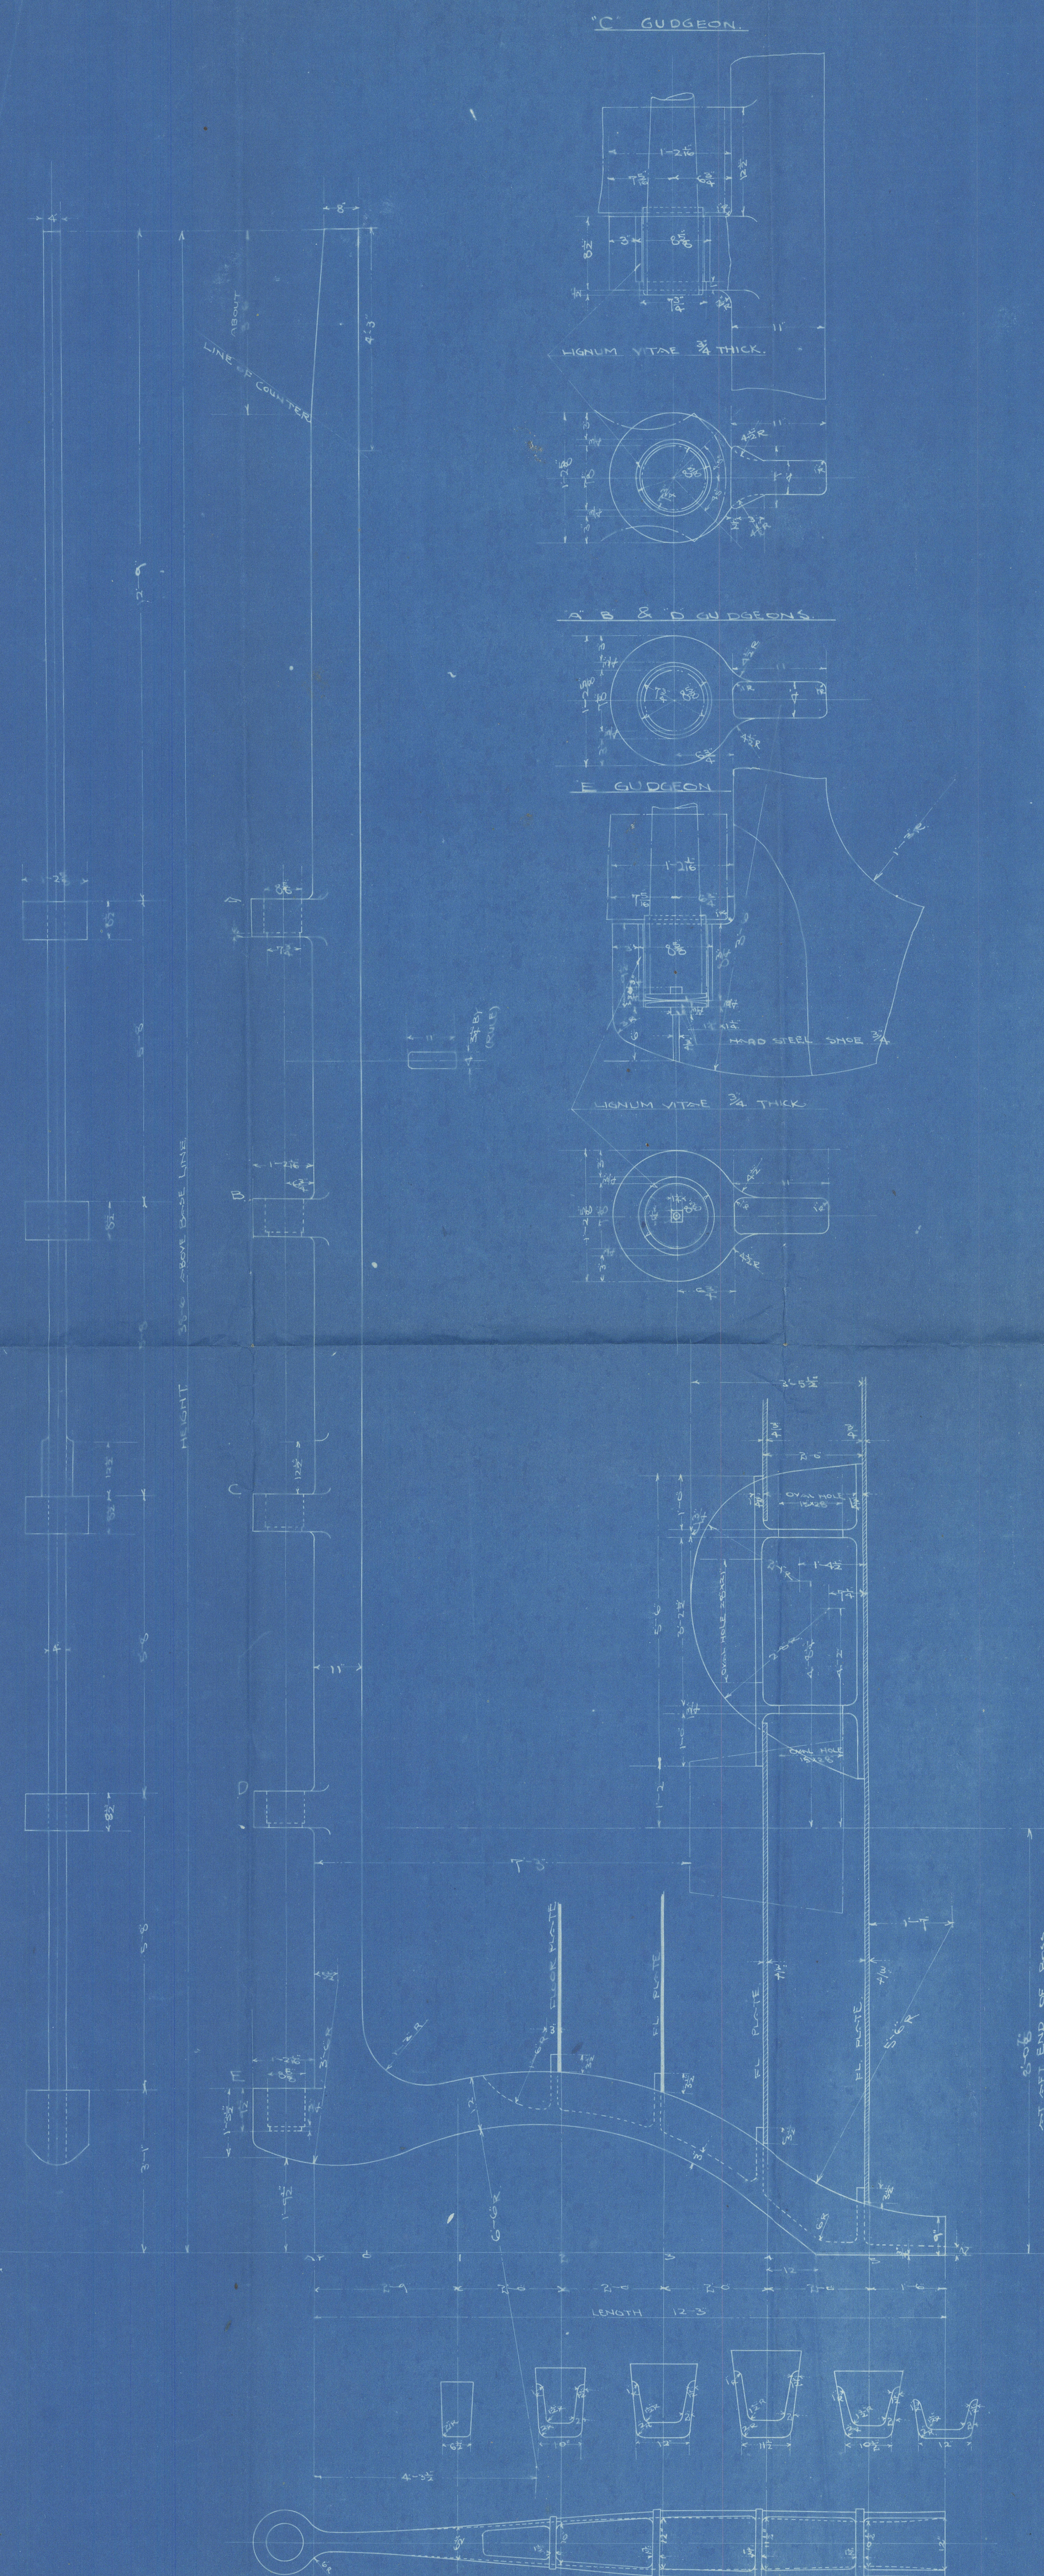

MATERIAL:- CAST STEEL.

SHAFT BRACKET LOOKING FORWARD

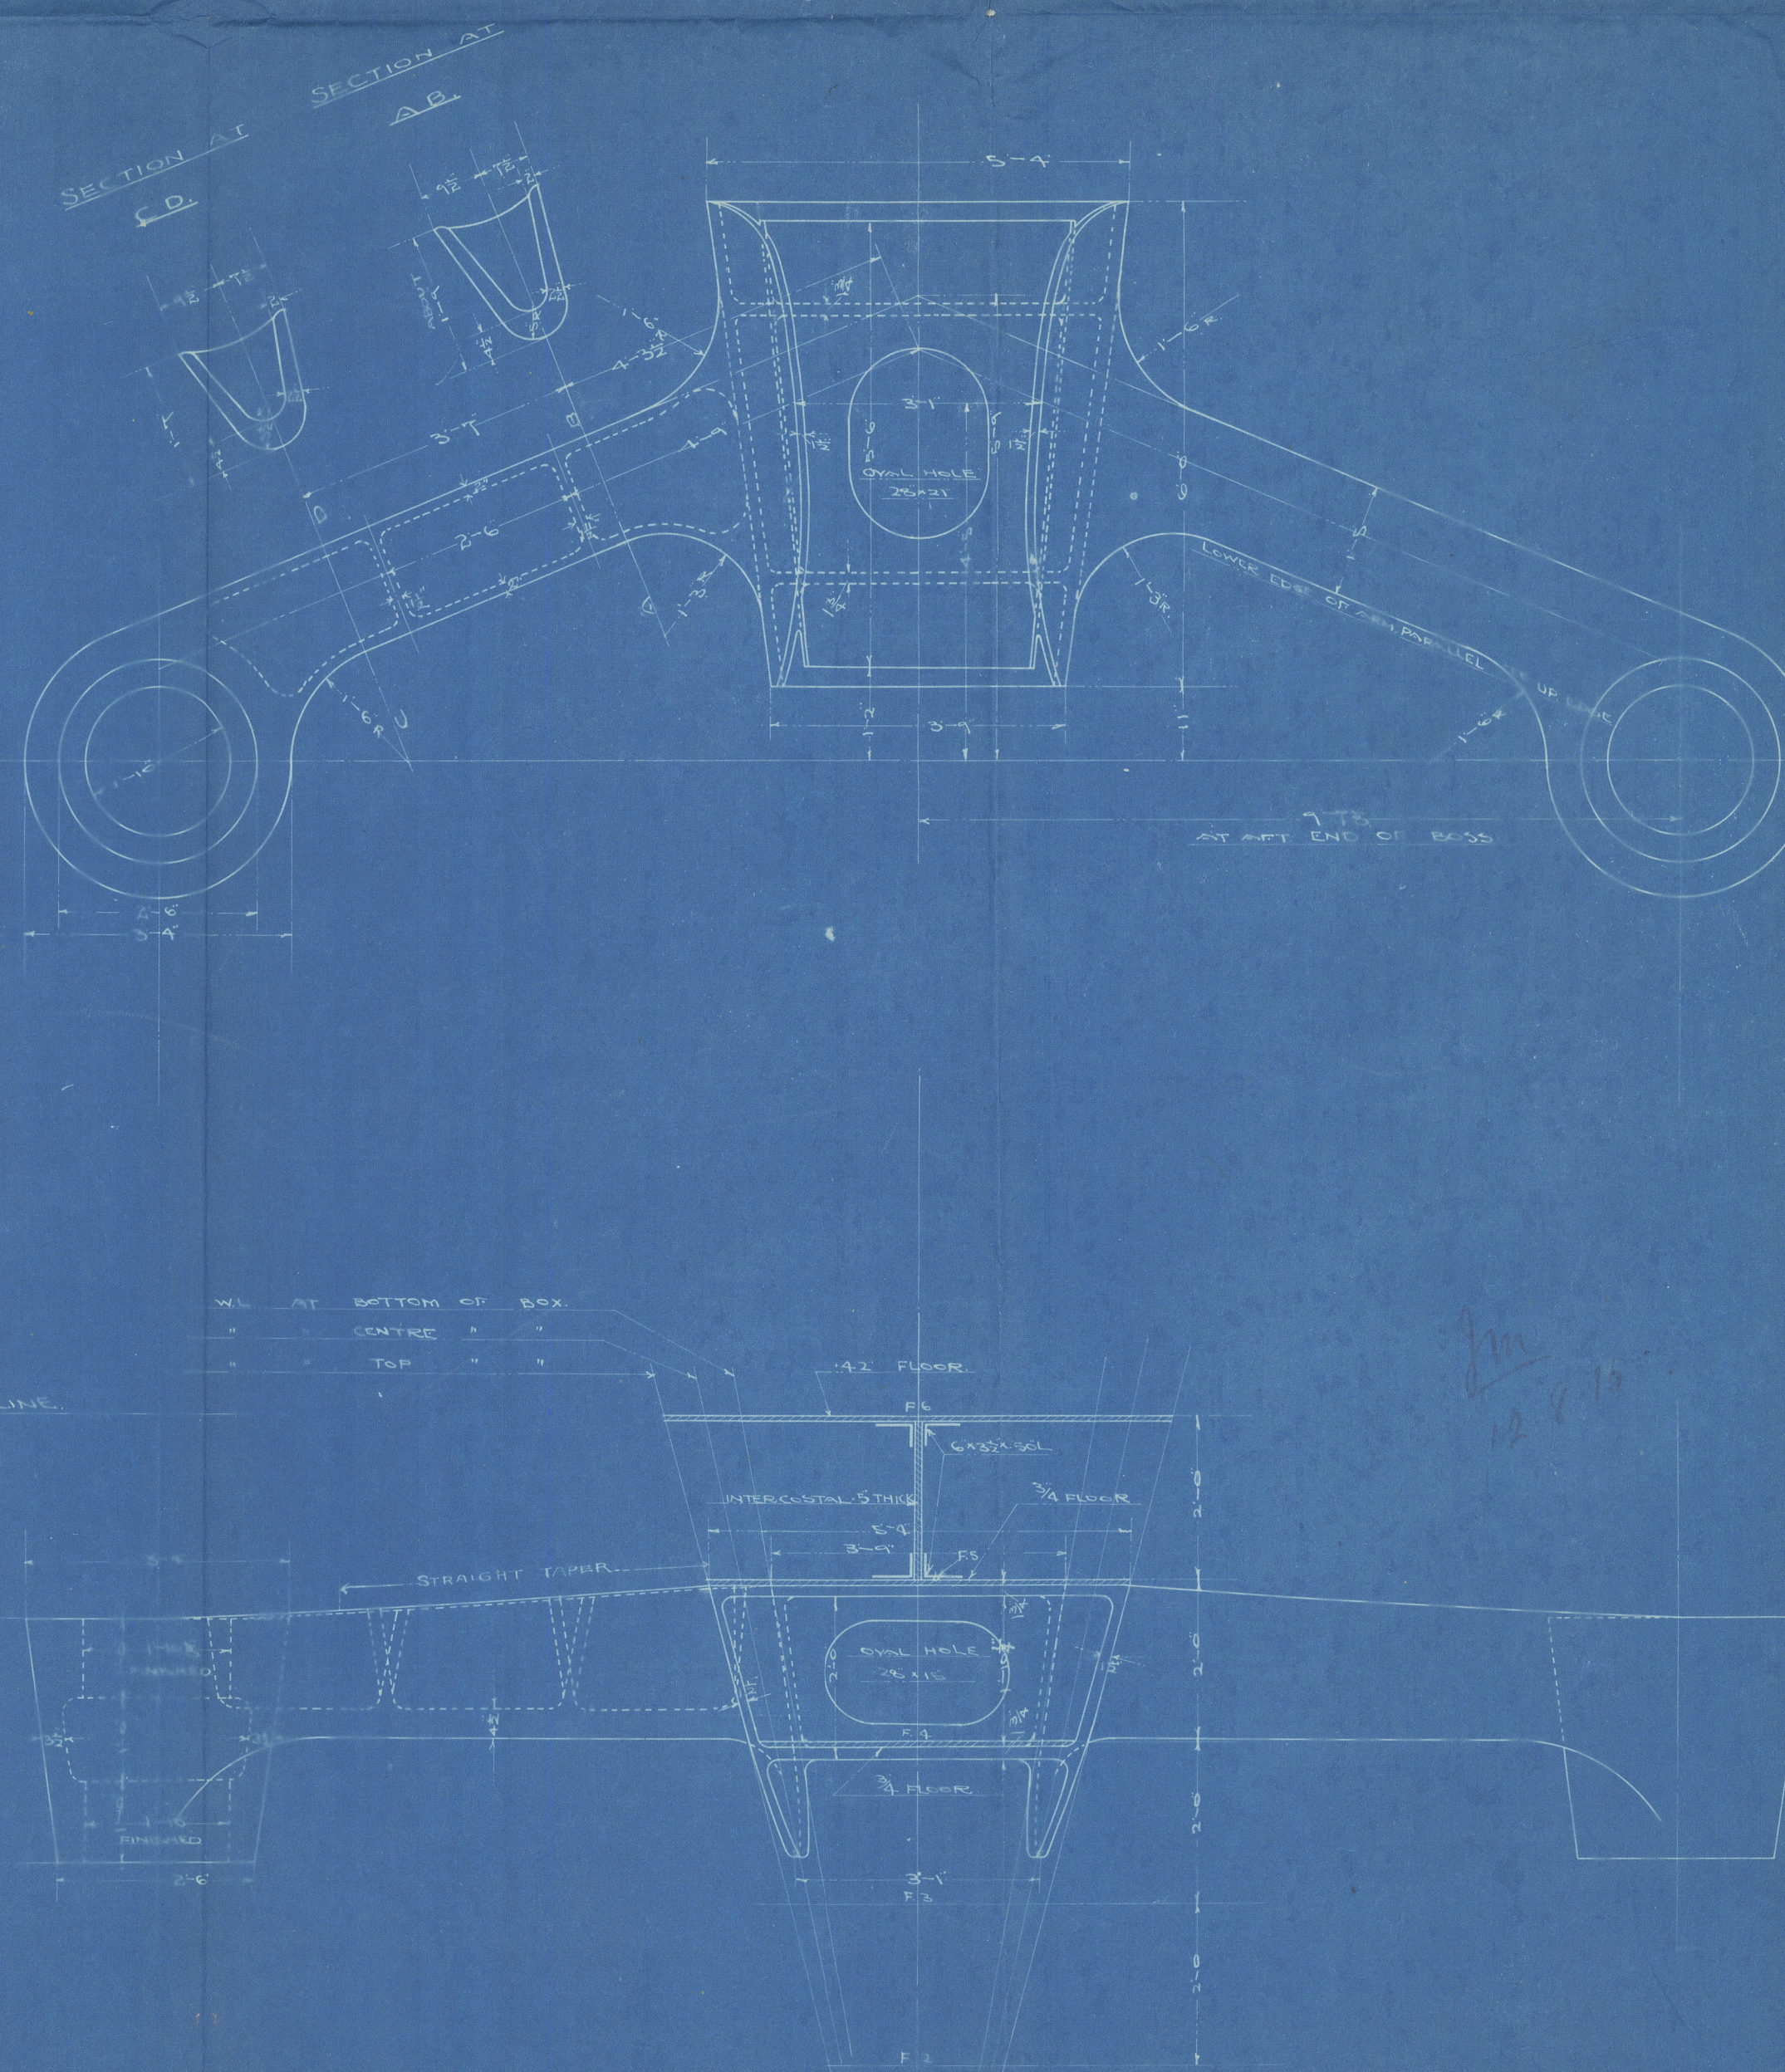

© 2020  
 Lloyd's Register  
 Foundation

008728-00733-0014



Kawasaki No 380 - 2.

Alteration of Stern Frame  
and Shaft Bracket



*Gen. Doc 2091*

*"Tajima Maru"*

*ex*

*S.S. "Tajima Maru"*



© 2020

Lloyd's Register  
Foundation

008728-008733-0014