






S. S. ZAHRA.

PROFILE & DECKS PLAN.

DIMENSIONS: 180'-0" x 33'-9" x 14'-0" MLD.

SCALE $\frac{1}{8}$ " = 1 FOOT.

TO CLASS LLOYDS 100 A.1. CARRYING PETROLEUM IN BULK.

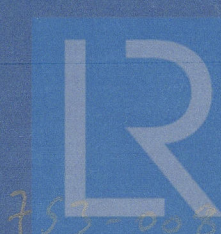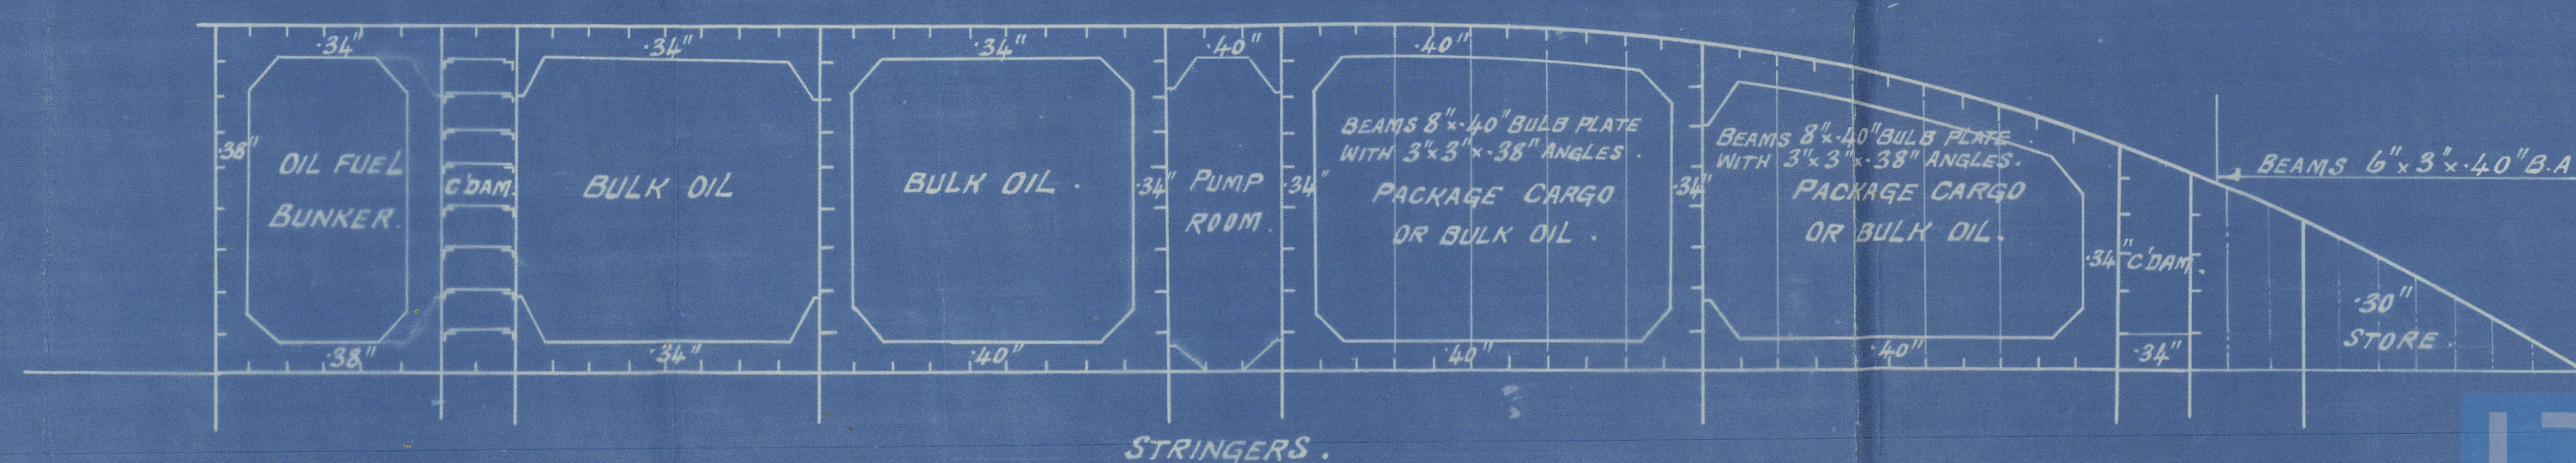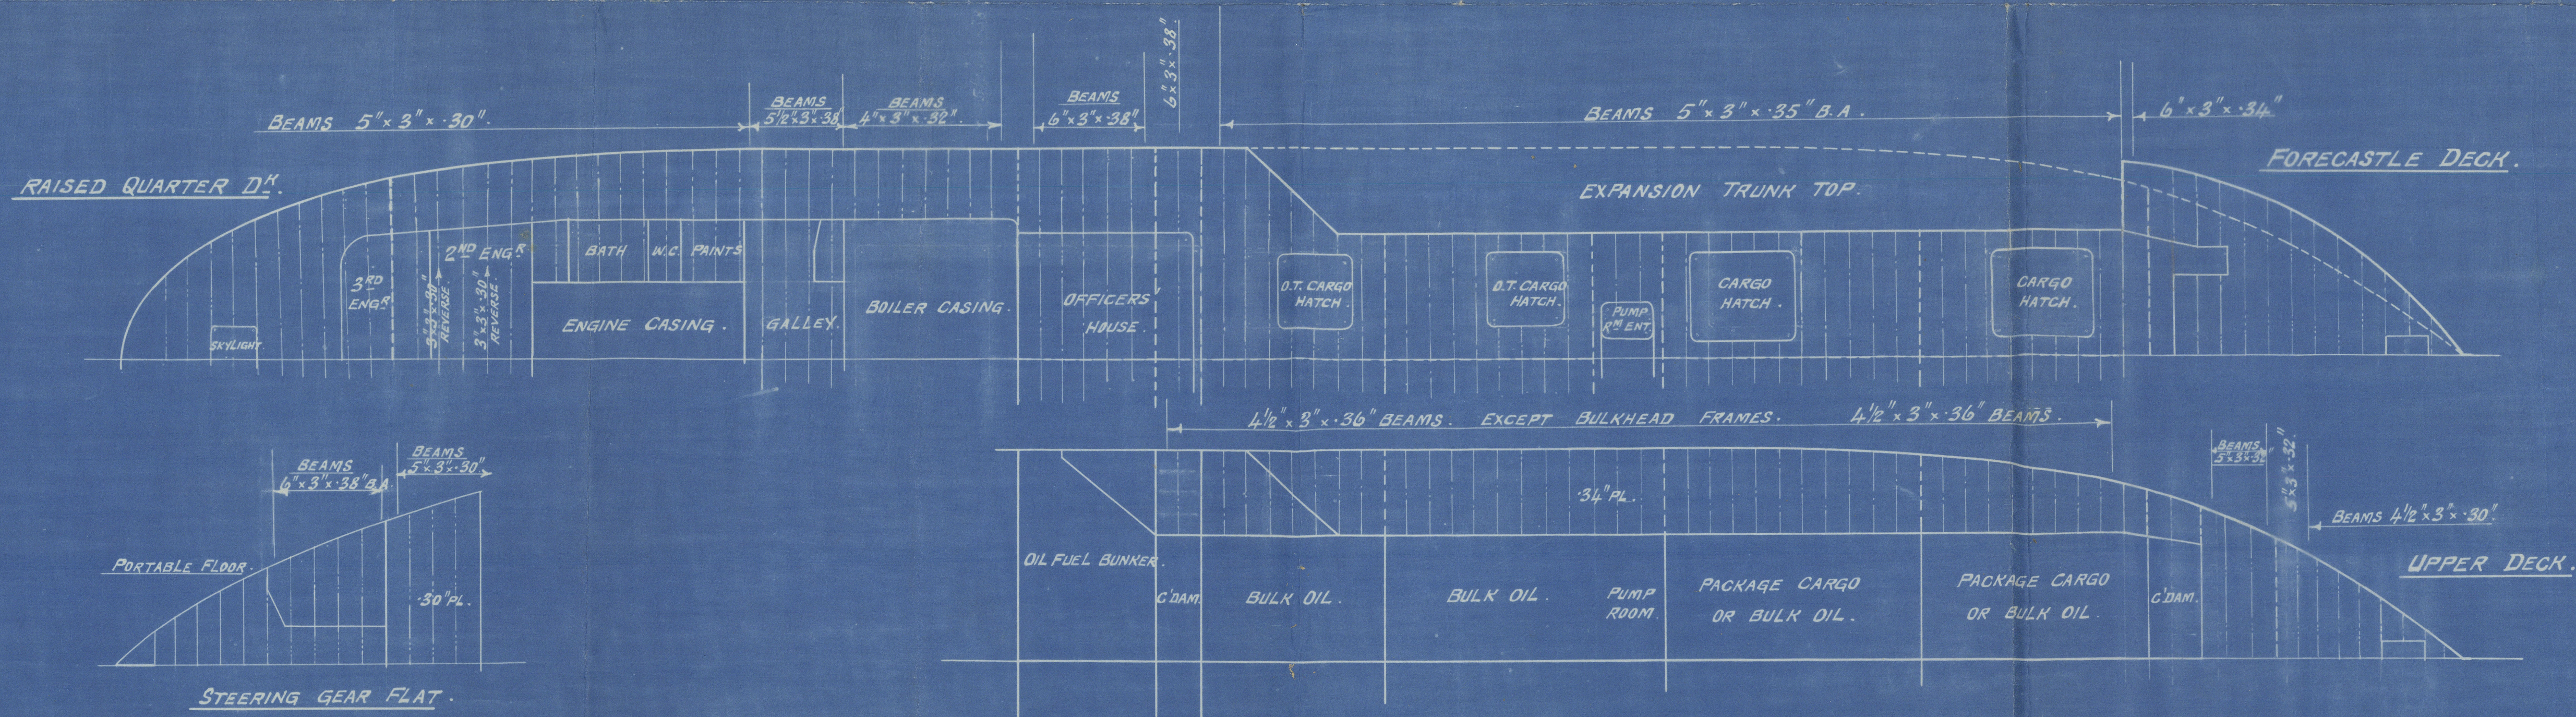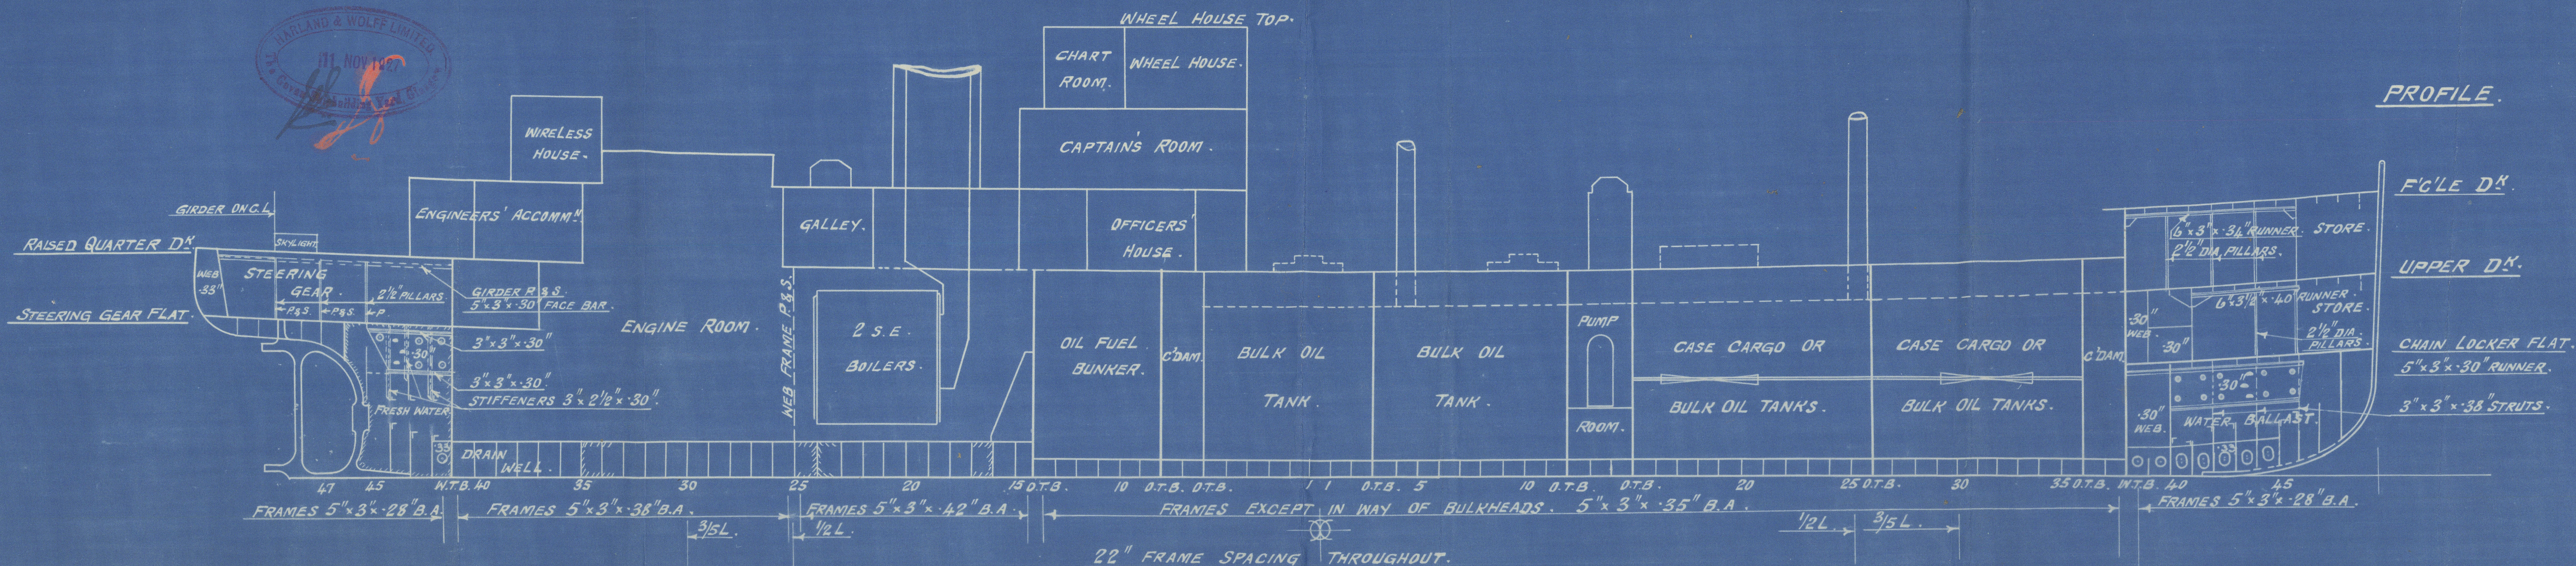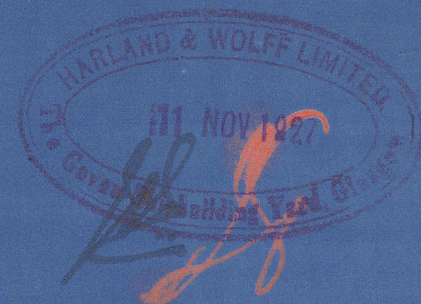

© 2021 Lloyd's Register Foundation

Messrs Harland & Wolff Ltd

No 811 G

Profile & Decks of Vessel as built-

No 19

Zahra

GLASGOW REPORT No 47318



© 2021

Lloyd's Register
Foundation

008753 - 008758 - 0184