

RECORDS DEPT.
LONDON

4

Kenya Marn ★


Construction Profiles Bottom

LONDON

AS APPROVED

12/1/57

ADDITIONS AND
MODIFICATIONS
INDICATED IN
BLUE

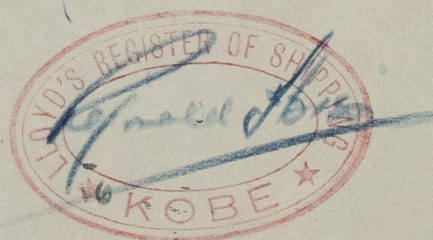

A



© 2021
Lloyd's Register
Foundation
008773-008777-0048