

NOTE
 MATERIAL --- STEEL CASTING
 ESTIMATED WEIGHT (ABOUT) 11,700
 LLOYD'S REGISTER OF SHIPPING & KAIJI-KYOKAIS
 CERTIFICATES OF TESTS TO BE SUPPLIED

DEGREE OF FINISHING	
~	SMOOTH SURFACE
V	ROUGH FINISH
W	MEDIUM FINISH
WV	FINE FINISH


SNO 25 LR
 KENRYU MARU


STERN FRAME
 AS FITTED
 船尾杖

SCALE 1/20
 FUJINAGATA
 SHIPBUILDING CO. LTD.
 SHIPBUILDING DEPT.
 ENGINEERING SECTION
 SHIP DESIGN SECTION
 CHIEF DESIGNER K. Yamano
 CHECKED BY M. Miyachi
 DRAWN BY M. Miyachi
 DATE JAN 21 1951
 DRAWING NO. H-6

00773-00777-0050


TO
LLOYD'S REGISTER OF SHIPPING

RECORDS DEPT.,
LONDON

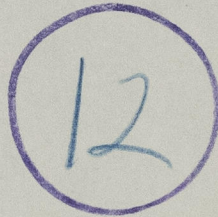


Kenya Marin

Stemframe
AS BUILT.

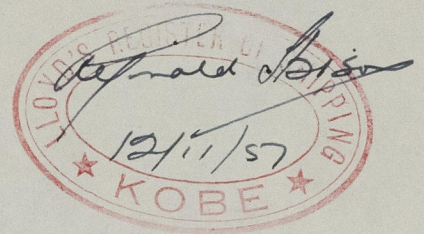

008773-008777-0050

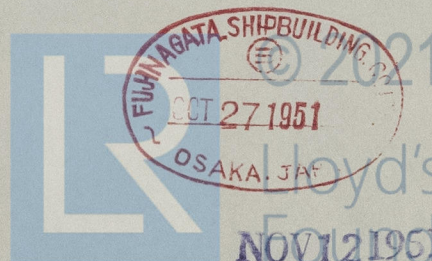

Lloyd's Register
Foundation