

MIDSHIP SECTION.

STEEL SCREW VESSELS OF FAST TRAWLER TYPE.

SCALE 2" = 1 FOOT

A.I. FOR GOVERNMENT SERVICE
TO CLASS ~~11.0.11~~ ~~11.0.11~~ ~~11.0.11~~


DIMENSIONS: 170'-0" B.P. x 29'-10" MLD x 16'-6" MLD.

RIVETING.

ALL SHELL SEAMS, BUTTS & OR KEEL SON
3/4" RIVETS; REMAINDER OF WORK GENERALLY
7/8" RIVETS. *And Flat Keel*
SHEERSTRAKE BUTTS TREBLE RIVETED, 2" LENGTH.
REMAINDER OF SHELL BUTTS DOUBLE RIVETED.
JOINTERS TO FRAMES & SEAMS.
DOUBLE

EQUIPMENT.

2 BOWER ANCHORS	12 1/2 CWTs. STOCKLESS.
STREAM	10 1/2 " EX. STOCK
KEEL	2 " "
135 FATHS OF 1 7/16"	STEEL LINK CABLE.
60 " 2 3/4"	STEEL WIRE STREAM.
75 " "	TOWLINE
90 " 2 1/2"	WARP

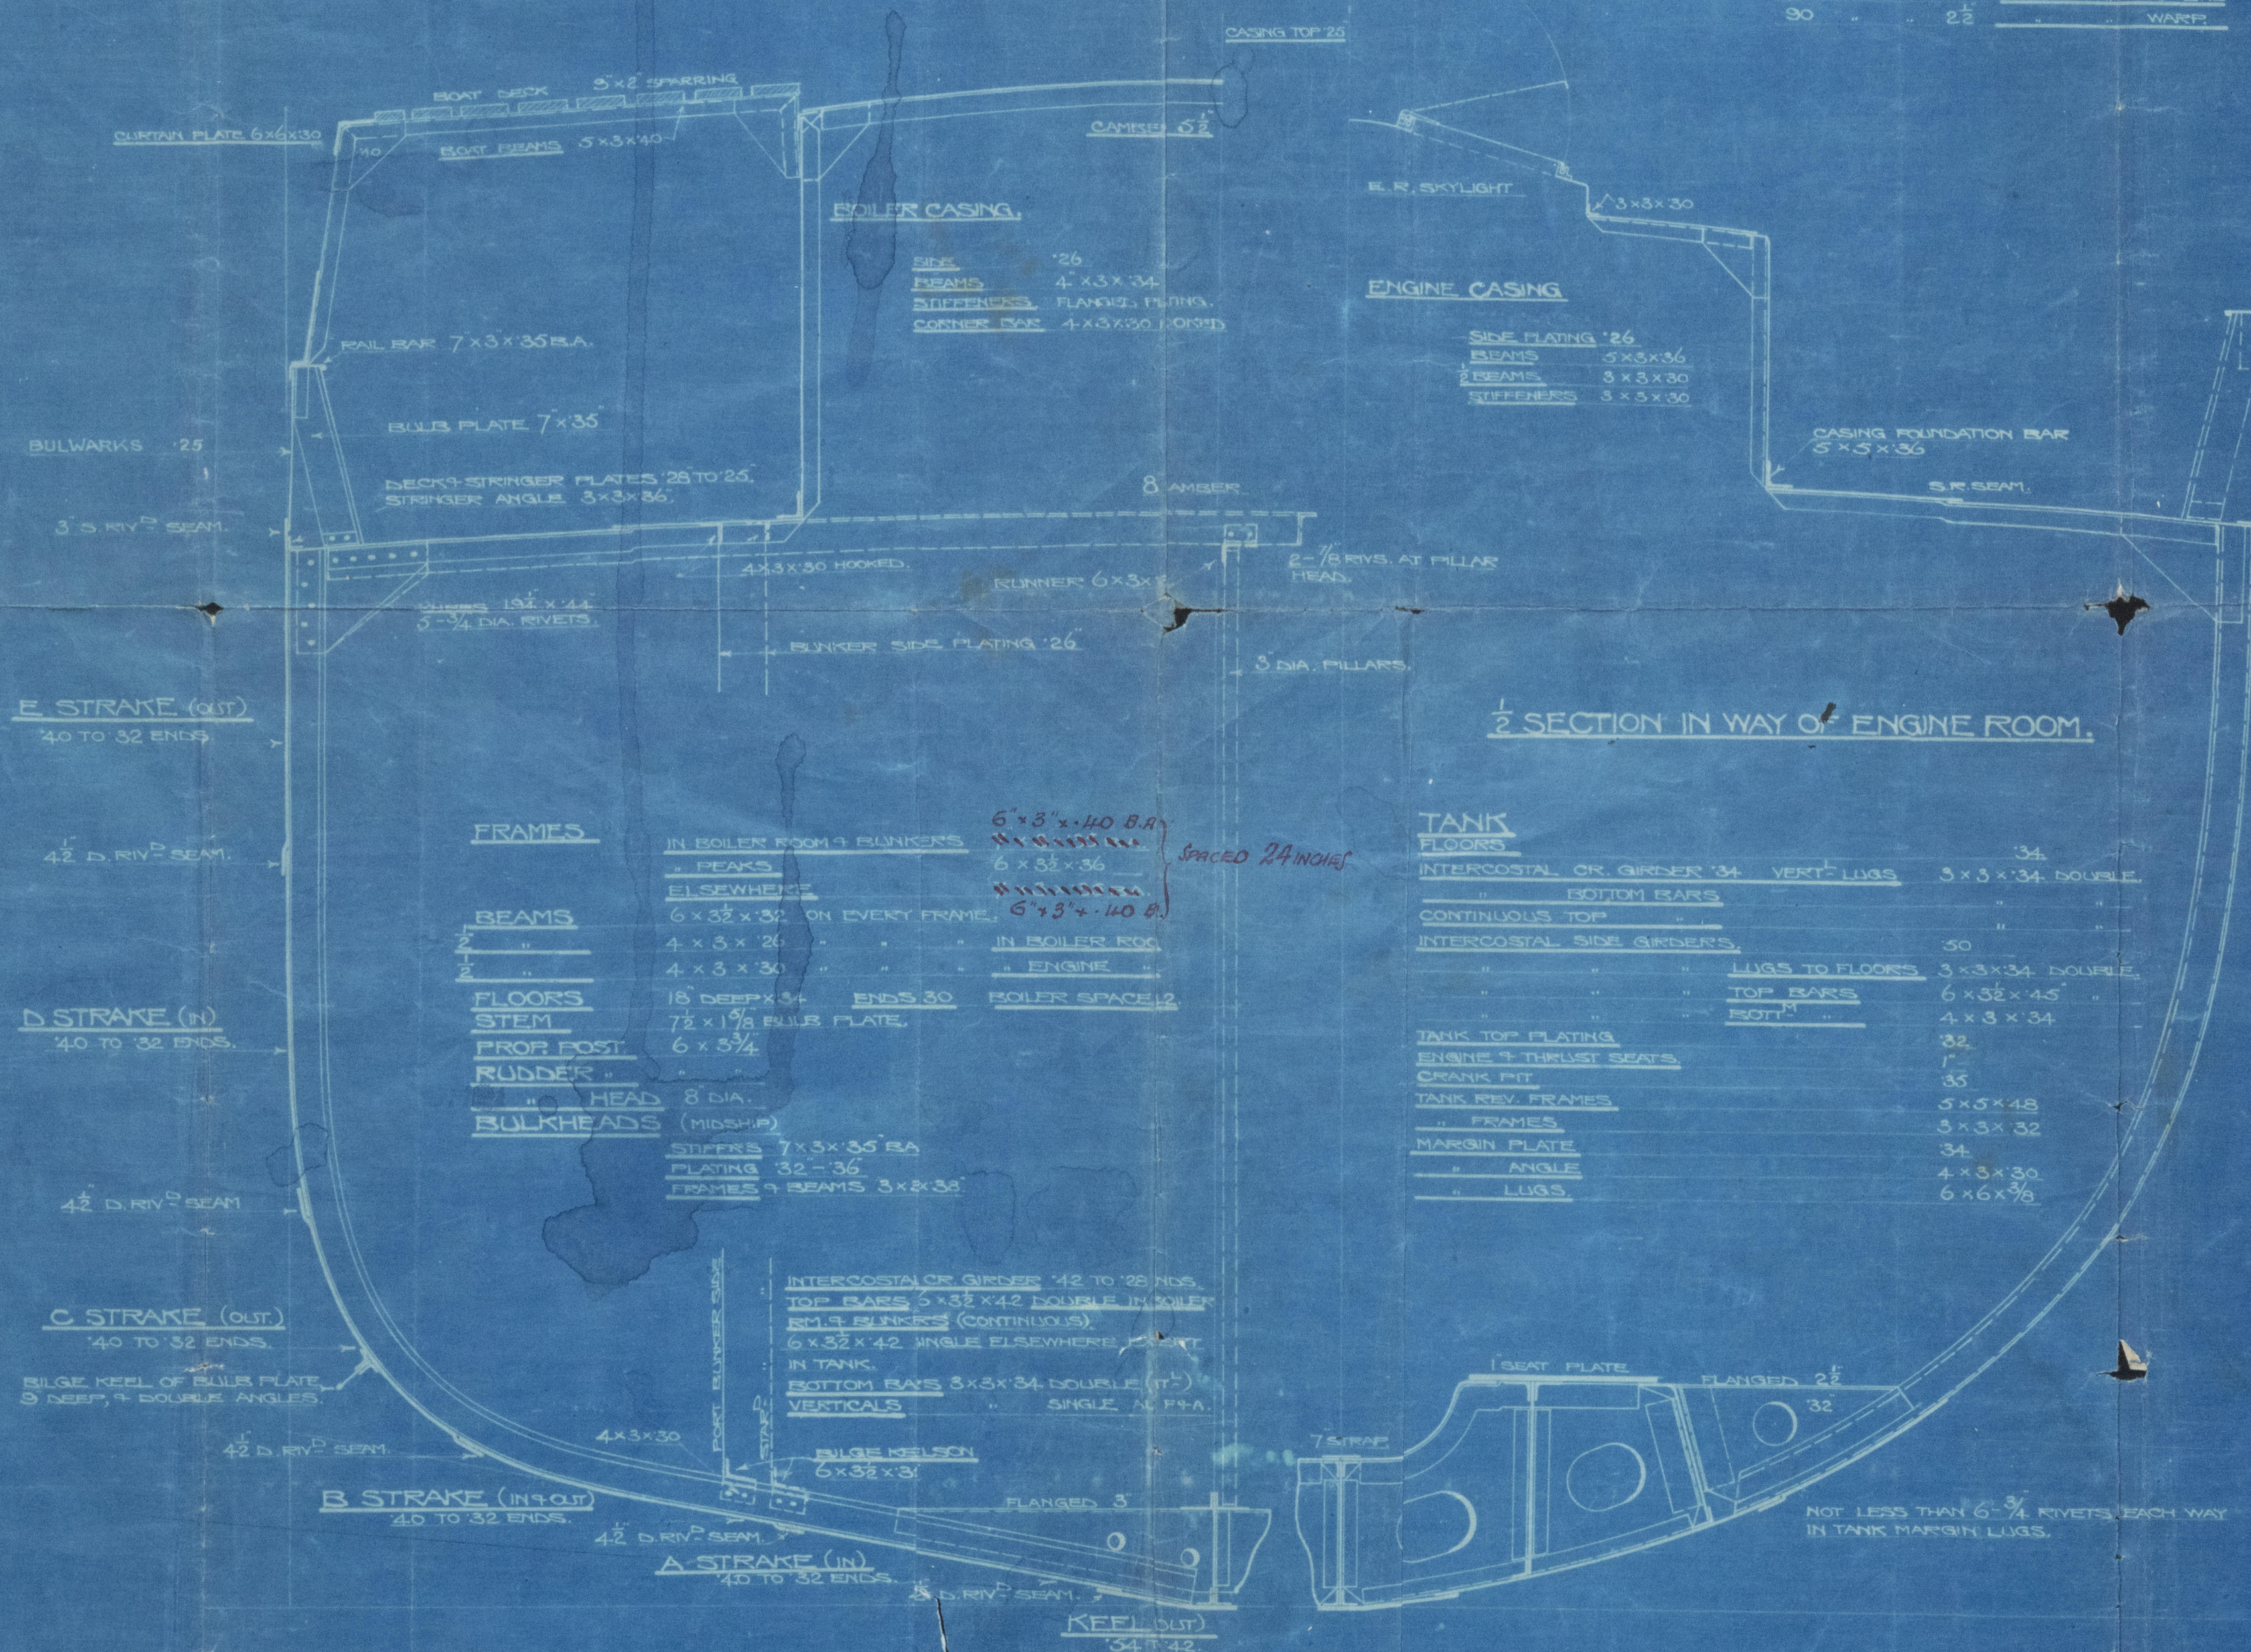

SMITHS DOCK CO. LTD.,
SHIPBUILDERS & ENGINEERS,
SOUTH BANK ON THE
ENGLAND.

64443
16-8-17

64
R

FTA 645

Midship Section
Smiths Dock Co. Ltd.

008784-008795-0053

108


Patrol Gunboats.

Midship Section

170'-0" x 29'-10" x 16'-6" Wd.

S. "Seaside" &
"Kildarvin"

Sou 11041

"Galata" 

D. 5216



© 2021

008789-008795-005 Boyd's Register
Foundation

Mr. Treddon

Patrol Gunboat.

0 Midships Section.

008789-008795-0053



© 2021

Lloyd's Register
Foundation