

CARDIFF

44839

19 JAN 1929

Index No.

(For London Office only.)

Lloyd's Register of Shipping.

SURVEYS FOR FREEBOARD.—STEAM SHIPS.

PARTICULARS RELATING TO ALL STEAM SHIPS EITHER FLUSH DECKED, OR WITH TOP GALLANT FORECASTLES, SHORT POOPS AND BRIDGE HOUSES DISCONNECTED, OR WITH TOP GALLANT FORECASTLES HAVING LONG POOPS, OR RAISED QUARTER DECKS CONNECTED WITH BRIDGE HOUSES, OR OTHERWISE.

Port of Survey Cardiff
Date of Survey 18th January, 1929
Name of Surveyor E. J. Grimblecombe

Ship's Name. "GEDDINGTON COURT"	Port of Registry and Nationality. <u>London</u> <u>British</u>	Official Number. <u>160564</u>	Gross Tonnage. <u>9 mo</u>	Date of Build. <u>1928</u>	Particulars of Classification. <u>+100 A1 with freeboard</u>
Number in Register Book <u>90270 Supp.</u>					

Registered dimensions from Ship's Register.	LENGTH. <u>420.1</u>	BREADTH. <u>56.5</u>	DEPTH. <u>33.8</u>	UNDER DECK TONNAGE. <u>6562.20</u>
Length on LOADLINE.	<u>420.1</u>	Frame Depth Rule $\frac{1}{2}$ " <u>2.10</u>	Ceiling $\frac{1}{2}$ " <u>+20</u> Sheer $\frac{1}{2}$ " <u>+38</u>	Peak Tanks } Incl'd <u>Rise of D.B. aft +5 Tons</u>
CORRECTED DIMENSIONS.	<u>420.1</u>	<u>55.6</u>	<u>34.38</u>	<u>6567.20</u>

Red from Boatrade by phone 2/1/29
Moulded Depth as measured..... 36.4 1/2
Rule wood dk less Str. 3 1/2
36.1 to me

Addition for Keel below base line for draught record.....inches.

NOTE.— If the depth is measure when vessel is afloat, the details of measurement should be reported.

CORRECTION FOR LENGTH.

Length of Ship on Loadline.....	<u>420.1</u>
Length in Table	<u>433.0</u>
Difference	<u>12.9</u>
Correction for 10ft., Table A.	<u>1.4</u> Table C.
× Difference divided by 10	<u>2.19</u> (if required.)
If 1/10ths length covered divide by 2	<u>- 2 1/4</u>

CORRECTION FOR IRON DECK.

Proportion covered, if less than 1/10ths length covered
Thickness of usual wood deck, less stringer In med. depth

CORRECTION FOR ROUND OF BEAM.

Breadth at Gunwale amidships.....	<u>56.0</u>
Round of Beam	<u>14</u>
Normal round.....	<u>14</u>
Difference	<u>✓ ÷ 2 =</u>
Proportion of Deck uncovered (Para. 19)	<u>✓</u>

NOTE.— The round of beam should be reported on the full breadth of vessel at the gunwale.

Co-efficient of fineness..... .819
Any modification necessary } C.D.B.
[Para. 4 (a) to (e)]* }
Co-efficient as corrected80

Sheer { Stem..... 46 } 144 ÷ 2 = 72 ...Mean
at { Sternpost ... 48 }

Sheer at 1/3 of the length from { Stem 48.38 } 42.38 ÷ 2 = 36.19..Mean
{ Sternpost 24.00 }

Gradual mean Sheer 65.80
Standard mean Sheer [Table, Para. 18] 52.01 Correction
Difference..... 13.79 ÷ 4 = 3.45
§ If limited as Para. 18 (f) - 3 1/2

Rise in Sheer { At front of bridge house..... ✓
from amidships }
[Para. 18 (e)] { At after end of forecastle ✓

Fall in Sheer }
Para. 18 (d) } ✓ ÷ 2 =
Length uncovered Correction

ALLOWANCE FOR DECK ERECTIONS:—

Freeboard, Table C.....
Correction for Length, if required (Para. 12, 13, and 14)

Freeboard by Table A, corrected for sheer, and for length, if required (Para. 12, 13, and 14)

Difference

Percentage as below.....

Correction for R. Q. Dk. if engine and boiler openings not covered by bridge house (Para. 11) }
Allowance for Deck Erections

	Length.	Length allowed.	Height.
Forecastle.....	<u>41.7</u>	—	<u>7-6</u>
Bridge House	—	—	—
† Raised Qr. Dk.....	—	—	—
Peop.....	—	—	—
Total	—	—	—

Length of Ship
Corresponding percentage }
(Para. 11, 12, 13, or 14)

FREEBOARD recommended amidships from centre of Disc to top of Statutory Deck Line, ~~Wood~~ (Steel) Deck:—

Fresh Water Line	above centre of Disc
Indian Summer Line	" " "
Winter Line	below " "
Winter North Atlantic Line	" " "

21 JAN 1929

⊙ If the frames, skin planking, or ceiling are of unusual thickness the breadth of vessel to inside of ceiling should be reported if possible.
† In vessels obtaining an allowance for deck erections under Para. 11 where the sheer drops abaft amidships the height of the R.Q.D. is to be taken from the level of the top of the amidship beam.
§ In flush-decked vessels the total standard mean sheer means the sheer measured at the stem and stern-post. In vessels having poops and forecastles, it means the sheer measured at points distant one-eighth of the vessel's length from stem and stern-post.

† State dimensions of freeing port area on back of this form.
‡ The Surveyor should state whether the fall in sheer as reported is measured relatively to the straight line of keel or to the water line. If measured relatively to water line the vessel's draft at time of survey, and also the usual load draft forward and aft should be reported.

Freeboard, Table A	<u>10 - 2 1/2</u>
Correction for Sheer	<u>- 3 1/2</u>
Correction for Length	<u>9 - 11</u>
Allowance for Deck Erections	<u>- 2 1/4</u>
Correction for Round of Beam.....	<u>9 - 8 3/4</u>
Correction for fall in Sheer (if any).....	✓
Correction for Iron Deck (if required)	<u>allowed in reduced med. depth</u>
Additions for non-compliance with provisions of } Para. 11 (d) and (e) † } ✓	
Other Corrections (if any) <u>For scuttling not to correspond to the approved summer moulded draught of 26-10"</u> } <u>+ 4</u>	<u>10 - 0 3/4</u>
Winter Freeboard	<u>10 - 0 3/4</u> ✓
Summer Freeboard	<u>9 - 6 3/4</u>
Indian Summer Freeboard	<u>9 - 0 3/4</u>
N.A. Winter Freeboard	—
Correction necessary because clearside amidships, measured in accordance with the Statute is not taken at the intersection of the wooden steel deck with side.	<u>+ 1 3/4</u>
Winter Freeboard from deck line	<u>10 - 2 1/2</u>
Summer " " " "	<u>9 - 8 1/2</u>
Indian Summer " " " "	<u>9 - 2 1/2</u>
N.A. Winter " " " "	—
.....	<u>9 - 8 1/2</u>
.....	<u>6 1/2</u>
.....	<u>6</u>
.....	<u>6</u>

008784-008795-0143

© 2021 Lloyd's Register
RECEIVED
23 JAN 1929


Do all the Frames extend to the top height in the Poop? *Yes* ^{Superstructure} Raised Quarter Deck? *Yes* Bridge House? *Yes* Forecastle? *Yes*
 To what height do the Reverse Frames extend? *Bulb angle Frames*
 Has the Poop or Raised Quarter Deck an efficient Iron Bulkhead at the fore end? *Yes*
 Give particulars of the means for closing the openings in Bulkhead *Yes*
 Is the Poop or Raised Quarter Deck connected with the Bridge House? *Yes* Has the Bridge House an efficient Bulkhead at the fore end? *Yes*
 Give particulars of the means for closing the openings in Bulkhead *Yes*
 What is the thickness of the Bridge Front plating? *1/2"* and Coaming plate? *1/2"*
 Give scantlings and spacing of the Stiffeners *Yes*
 Are bracket plates fitted at each end of the Stiffeners? *Yes* Are hor'l. brackets fitted connecting Bridge Bulk'd. with Bulwarks? *Yes*
 Has the Bridge House an efficient Iron Bulkhead at the after end? *Yes*
 How are the openings closed? *Yes*
 Is the Forecastle at least as high as the main or top-gallant rail? *Yes* Has the Forecastle an efficient ^{Steel} Iron or Wood Bulk'd. at after end? *Yes*
 Are the Engine and Boiler openings covered by a Bridge, Poop, Raised Quarter Deck, or enclosed by a Strong Iron or Steel Deckhouse? *Steel Casings partly surrounded by houses*
 If the openings are not so protected are the exposed parts of the Casings efficiently constructed? *Yes*
 Give thickness of plating; scantlings and spacing of Stiffeners *.34 and .38, Stiffeners 18. 3" 5" x .32 spaced about 30"*
 What is the height of the exposed Casings? *7-6* Are suitable means provided for closing all openings in them in bad weather? *Yes*

Are the Weather Deck Hatchways efficiently constructed and at least equal to the requirements of Section 28 of the Rules for 1904-5? Give particulars below:— *Yes*

Position and Size.	No. 1. 30'-4" x 20'-0"		No. 2. 30'-4" x 20'-0"		No. 3. 14'-0" x 18'-0"		No. 4. 30'-4" x 20'-0"		No. 5. 30'-4" x 20'-0"	
	Ship.	Rule.	Ship.	Rule.	Ship.	Rule.	Ship.	Rule.	Ship.	Rule.
COAMING. Height above top of DECK	30"	18"	31"		31"		31"		31"	31"
Thickness	Sides	.44	.44		.44		.44		.44	.44
	Ends	.45	.44	.44		.44		.44	.44	.44
SHIFTING BEAMS OR WEB PLATES.	Number	One	One	5	5		2		5	5
	Section and Scantlings	Plate 18" x 50"	18" x 36"	18" x 36"	18" x 36"		16" x 34"		20"	20"
Material		Angles	Angles	5.4" x 3" x .44	No. 1.		3.4" x 3" x .44		No. 1.	No. 1.
		4" x 3" x .50	4" x 3" x .44	Steel	Steel		Steel		Steel	Steel
* FORE AND AFTERS.	Number	None	None	NIL	NIL		NIL		NIL	NIL
	Section and Scantlings									
HATCHES Thickness		2 1/2"	2 1/2"	2 1/2"	2 1/2"		2 1/2"		2 1/2"	2 1/2"
	Remarks	2 1/2"	2 1/2"	2 1/2"	2 1/2"		2 1/2"		2 1/2"	2 1/2"

* The depth of Fore and Afters should be stated from the underside of the hatches in all cases.
 (If the sill of the lowest side scuttle will be less than 6 inches above the Indian Summer Load Line if assigned under the tables, state vertical distance from top of deck at side amidships to lower edge of lowest side scuttle.)
 The following information is to be given in all Cases of vessels dealt with under Paras. 11, 12 (under 15 feet Moulded depth) and under Shelter Deck Rules.

What is the thickness of the Bridge Sheerstrake? *Strake between Main and Bridge Sheerstrakes?*
 Delete the words *The Crew are, are not, berthed in the bridge house.*
 that do not apply *The arrangements to enable them to get backwards and forwards from their quarters are, are not satisfactory.*
 Length of Bulwarks in well _____ Sq. ft.
 Area of Freeing Ports required by Para. 11 (e) each side of vessel = _____ Sq. ft.
 Ft. Tenths. Ft. Tenths. No. } Freeing Ports (each side of vessel) = _____ Sq. ft.
 Total deficiency or excess = _____ Sq. ft.

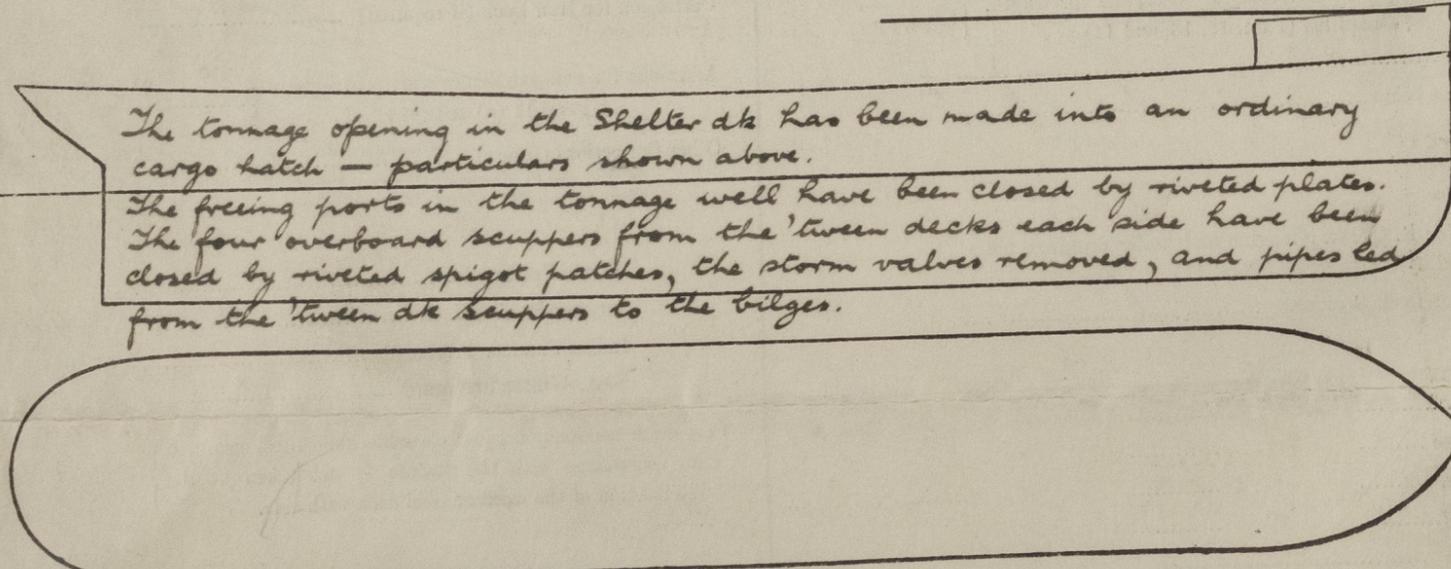

Show hereon line of Floors or Tank Top with position of any Breaks in same; also height of Peak Tank tops, &c., &c.

State any special features in the construction of the Vessel _____
 Builder's name and yard number *Northumberland S. B. Co (1927) Ltd., Newcastle.*
 Names of sister vessels *"Sinnington Court", "Rossington Court", "Yilsington Court", "Quarrington Court".*
 Owners *United British S. S. Co Ltd (Haldin & Co. Ltd. Mgrs)*

Address _____
 Fee £ *4 : 4 : 0* as Received by me *22.1.29*
changed for sister vessel "Rossington Court" — Sect 4 letter M, 13/10/28.

