



15-12-22

EQUIPMENT NO.
L. (B+D) = 15122 18233
BRIDGE 629
HOUSE ART 138
HOUSES & CHIMNEY 488
EQUIPMENT NO. = 15122 18233
3 BOWEN HUGHES STOCKLESS 110 CWTs COLL. WT.
1 STEAM HULLER 10 CWTs COLL. WT.
240 FMS OF 1 1/2" STUP CHAIN CABLE

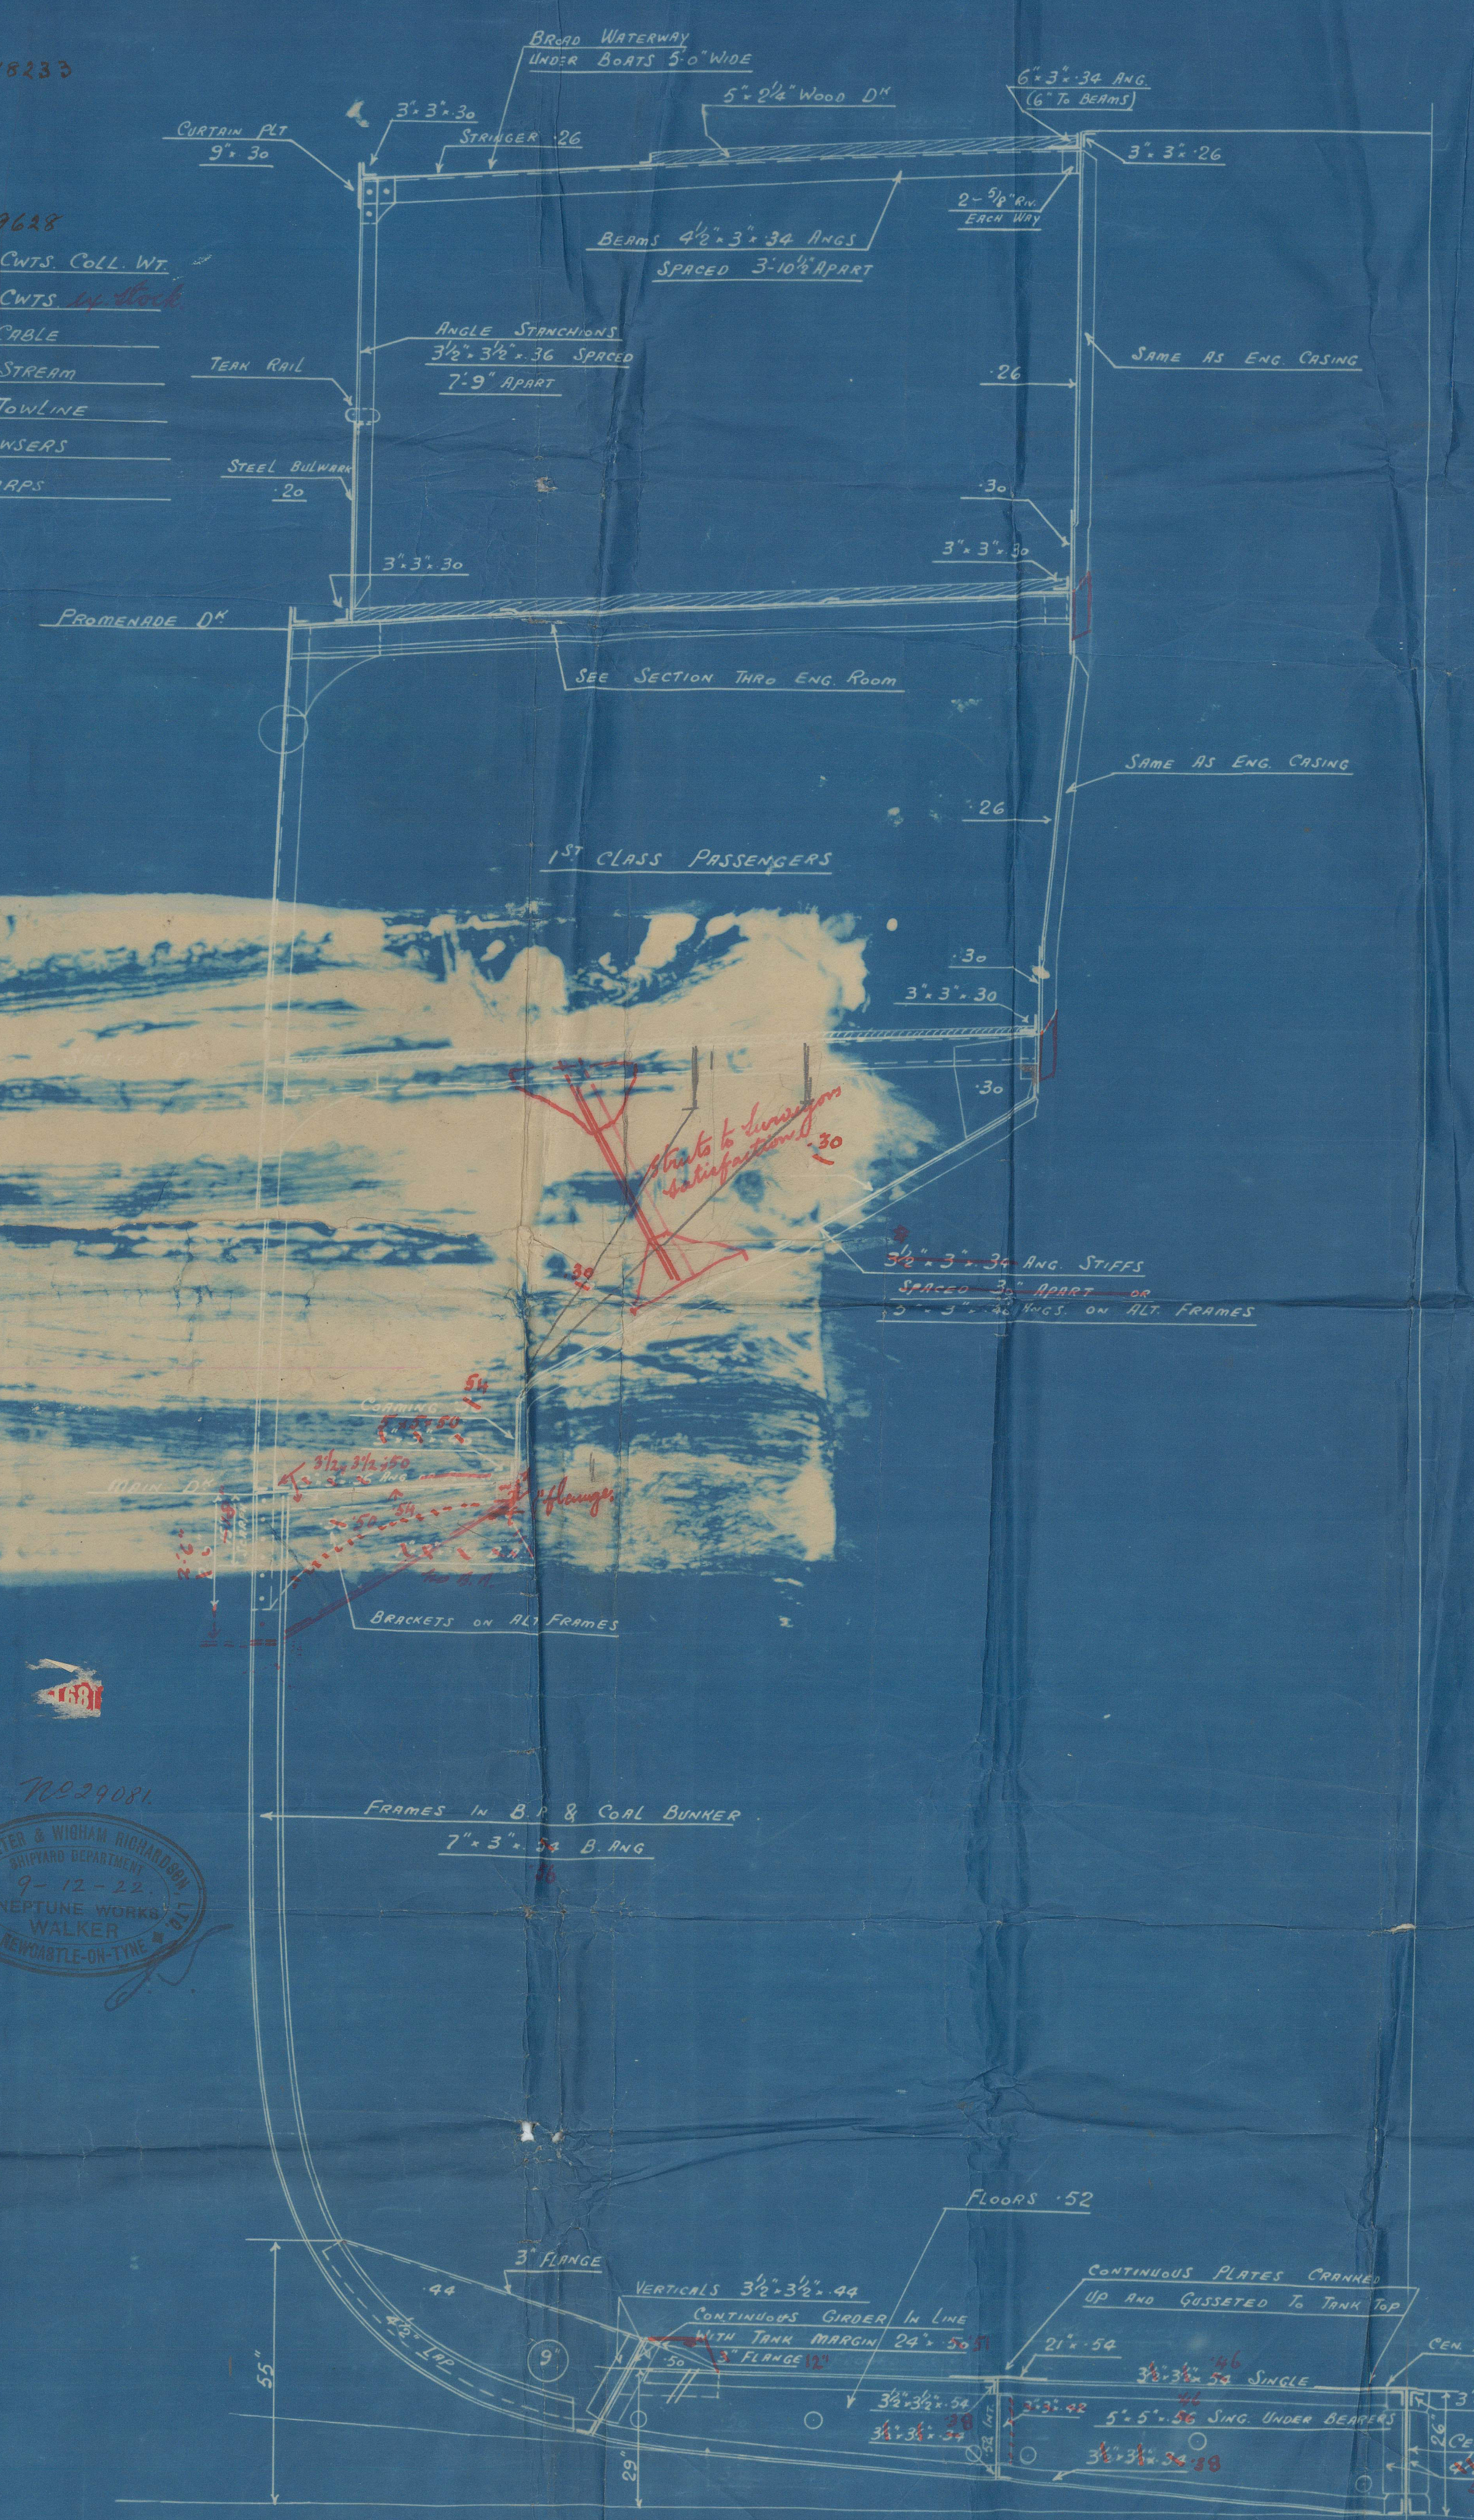

SECTION TWO BOILER ROOM

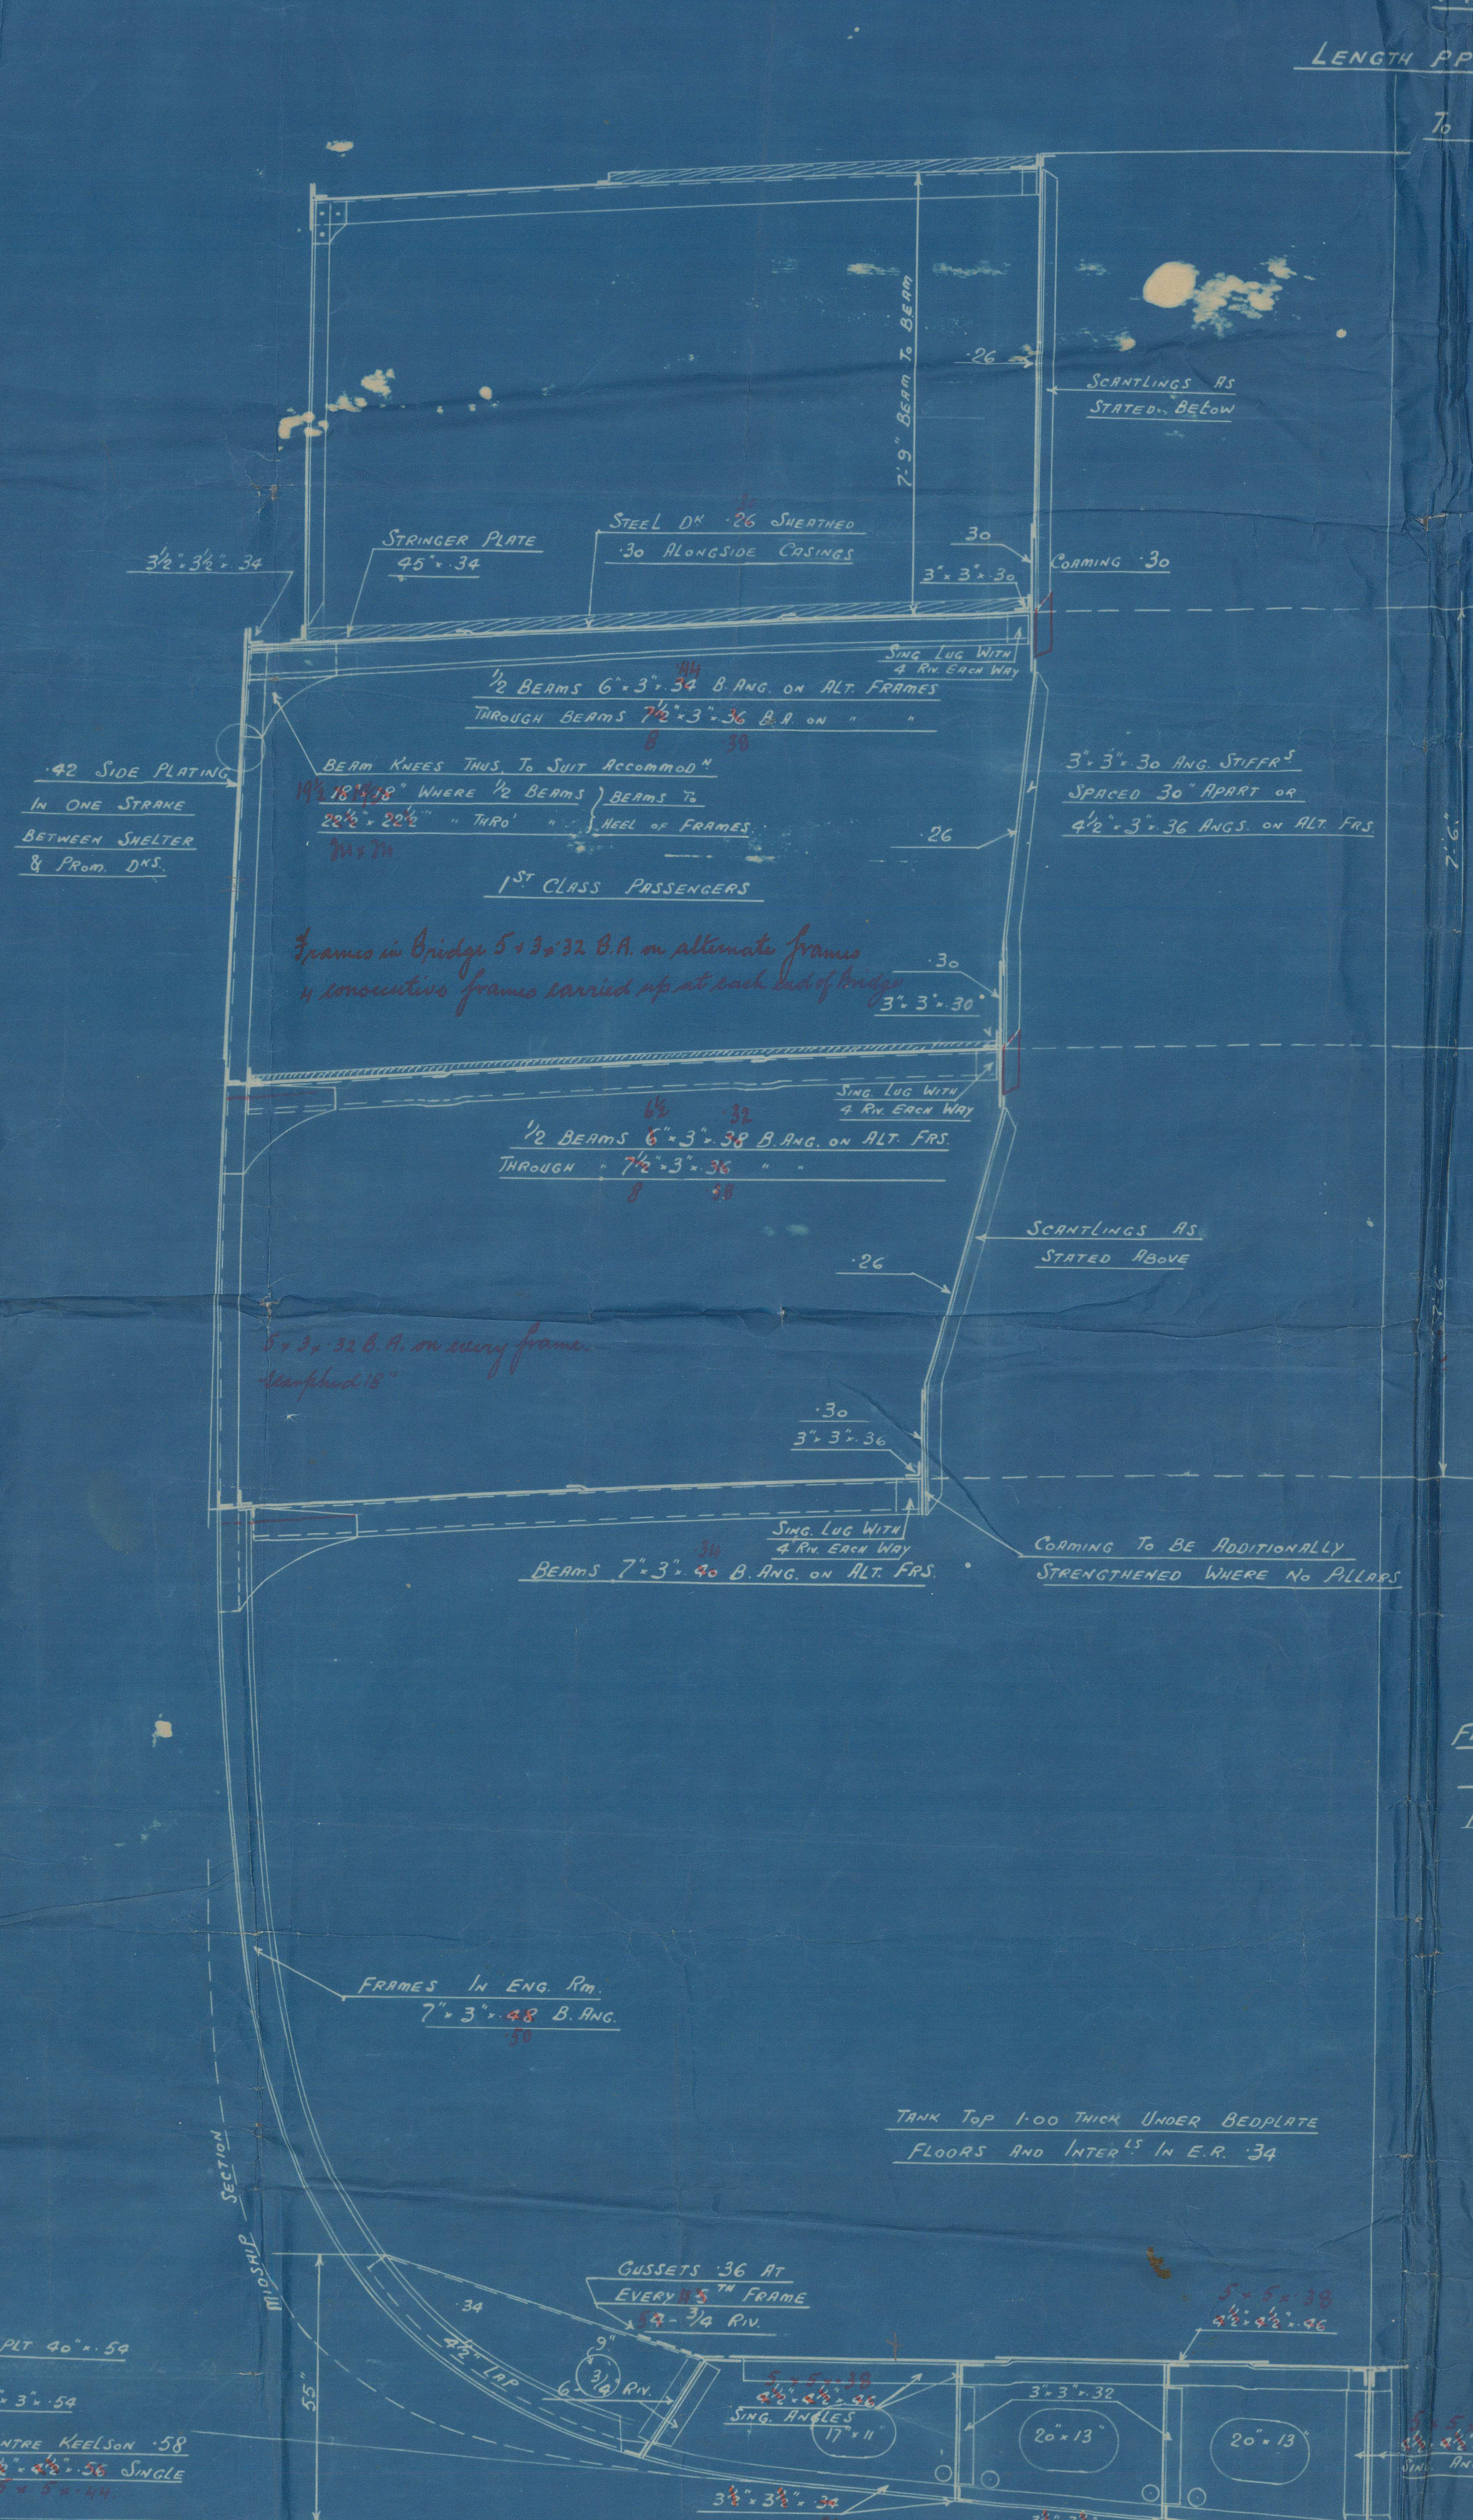

SECTION TWO ENGINE ROOM

Nº 1146


MIDSHIP SECTION

LENGTH A.P. 280'-0" x 39'-10" M.P. x 25'-0" to 34'-0"

To CLASS LLOYDS 100 A.I. WITH FREEBOARD

SCALE 1/2" = 1 FOOT

SECTION TWO HOLDS

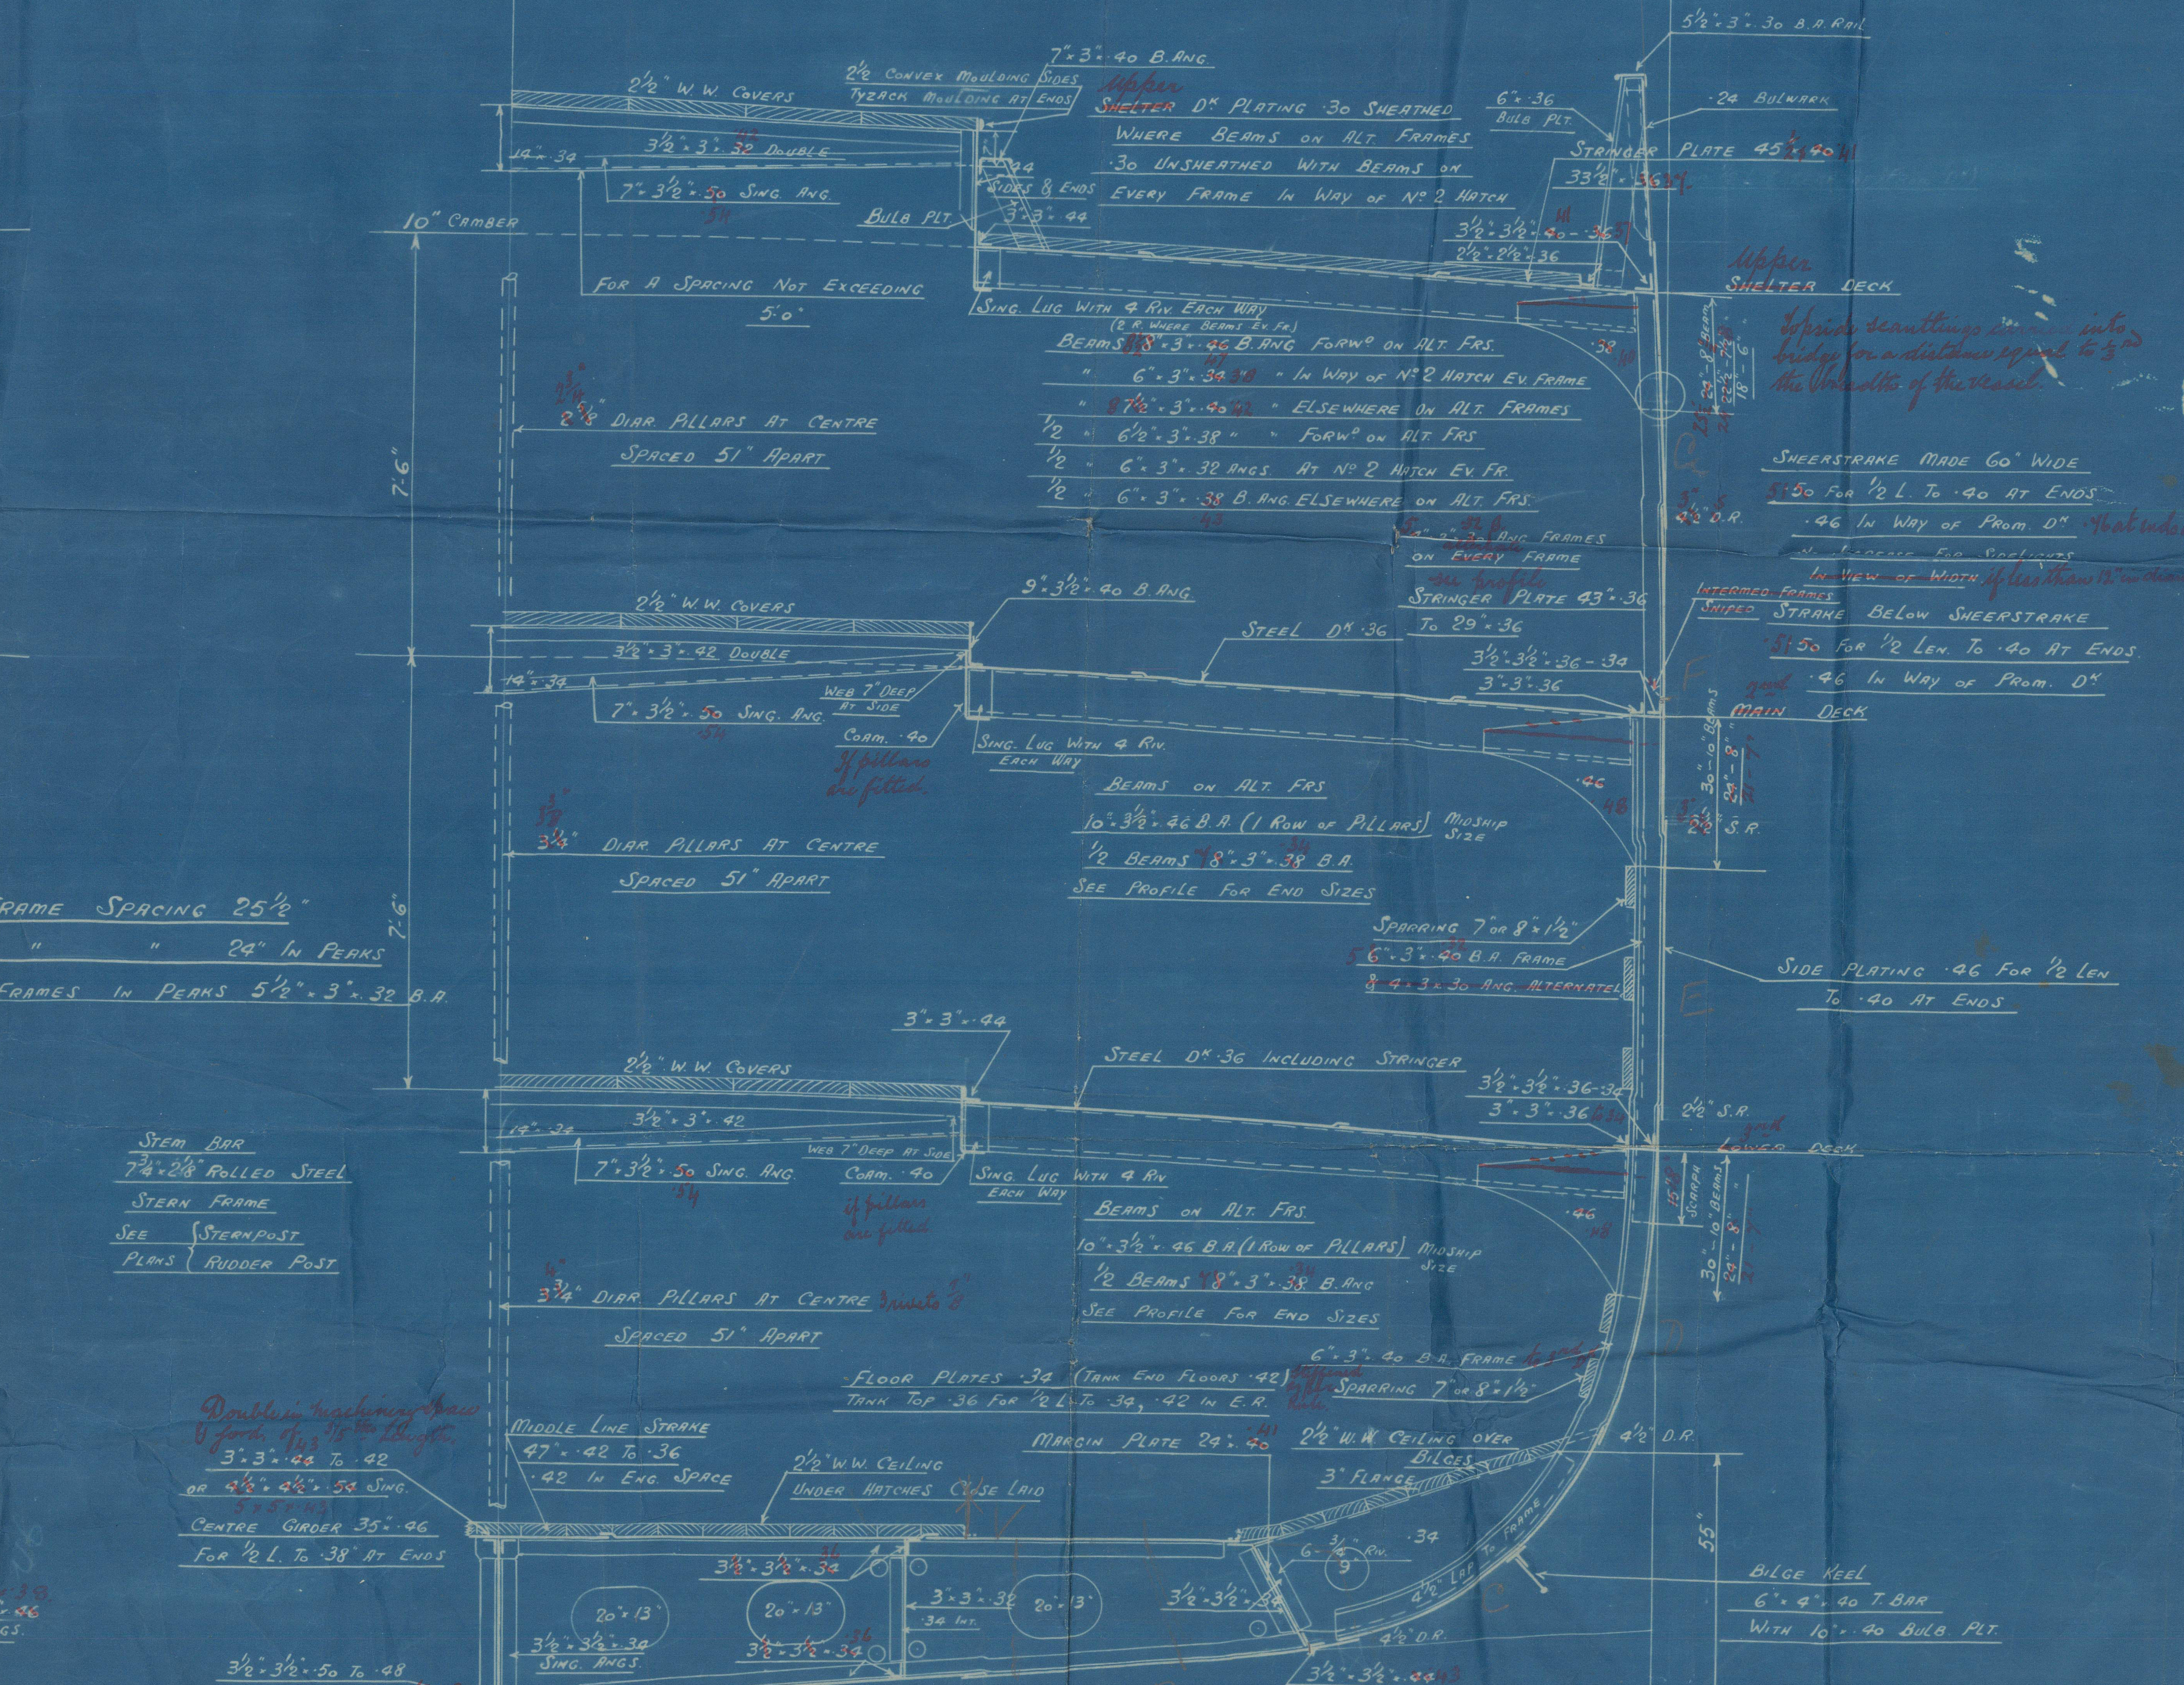

Bottom Plating .40 for 1/2" to .42 at Ends
Midship Thickness of Two Strakes in Bottom
Plating Maintained to Rule Position of Collision and





No 1146

Hunter & Higham Richardson & Co

Plan of Midship Section

No 2


Zonadich

S. S. "HADRIAN."

NEWCASTLE ON TYNE.

Report No. 46839.

008823-008830-0055

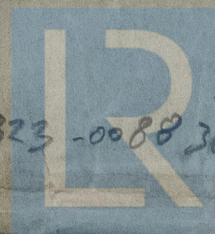

© 2021

008823-008830-0055 Lloyd's Register
Foundation