


N^o 204-5 OIL STEAMERS. PROFILE & DECK PLANS.


SCALE $\frac{1}{8}" = 1 \text{ FOOT}$.

DIMENSIONS:
 LENGTH B.P. = 210' 0"
 BREADTH = 34' 0"
 DEPTH = 16' 6"


SECRET AND CONFIDENTIAL.

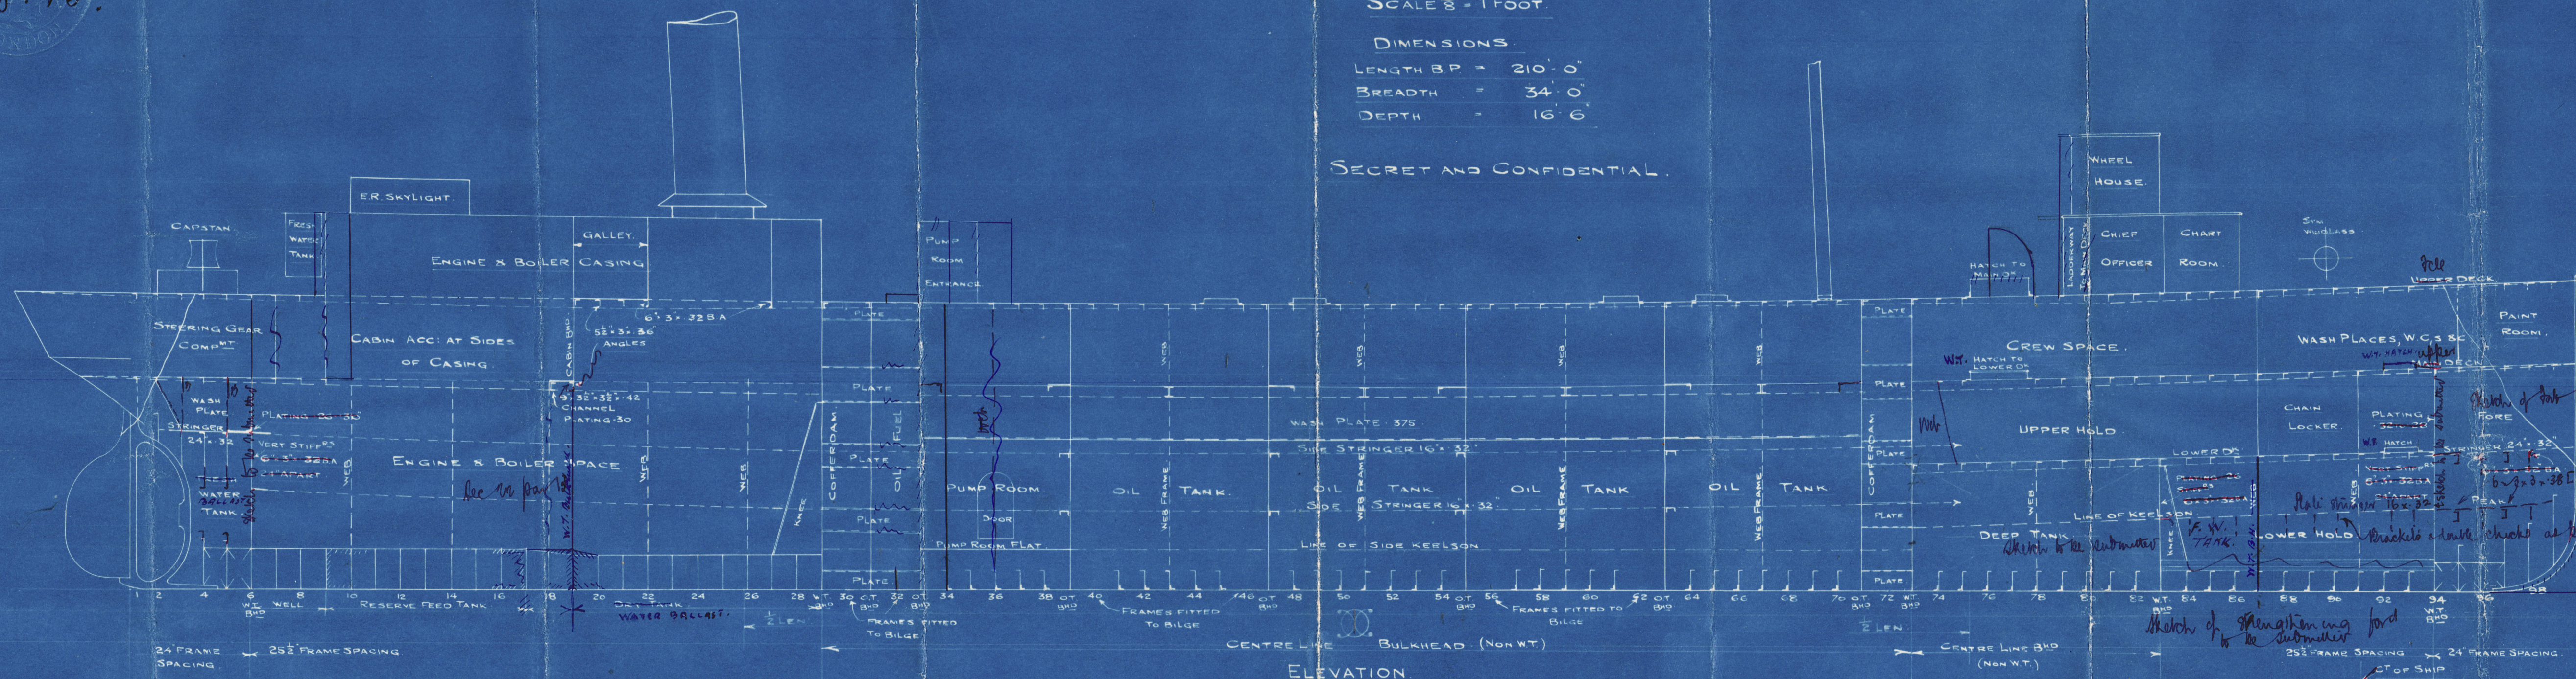


UPPER DECK

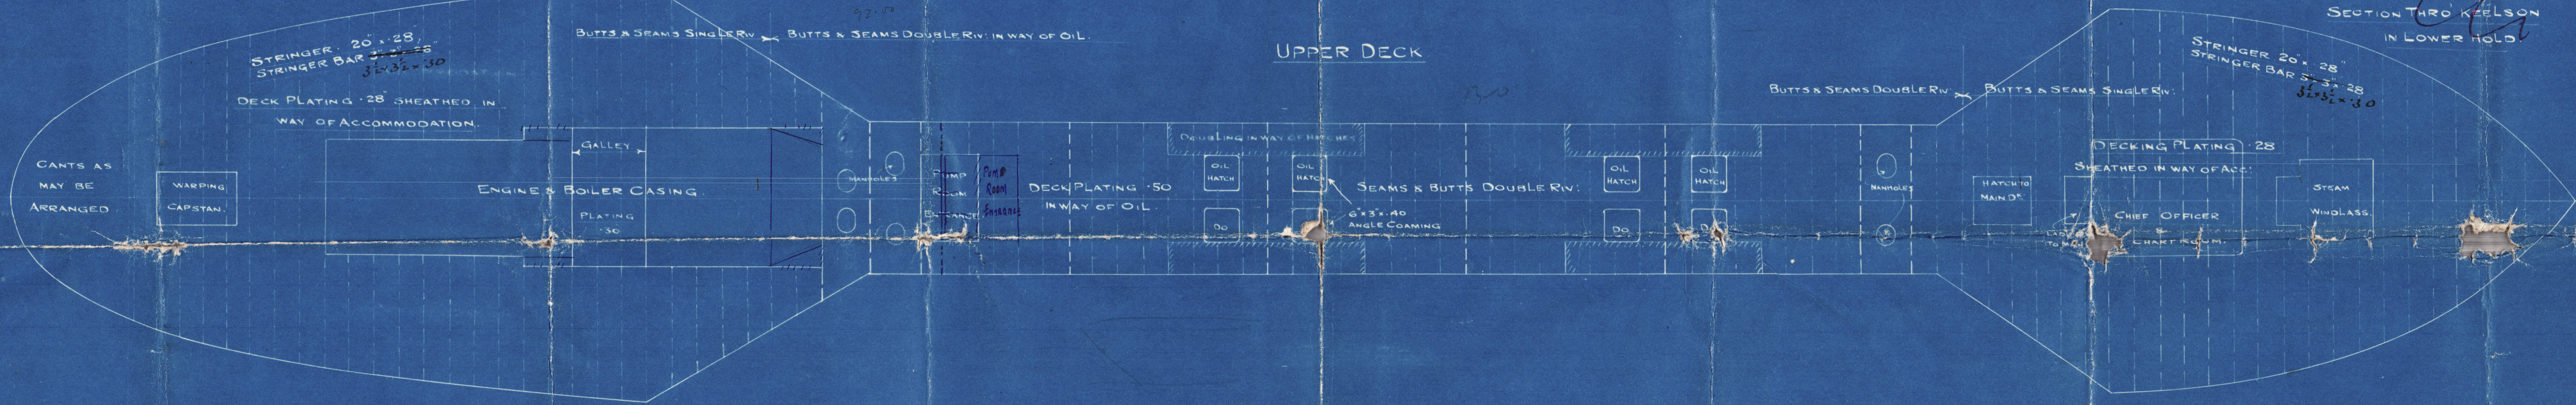

MAIN DECK

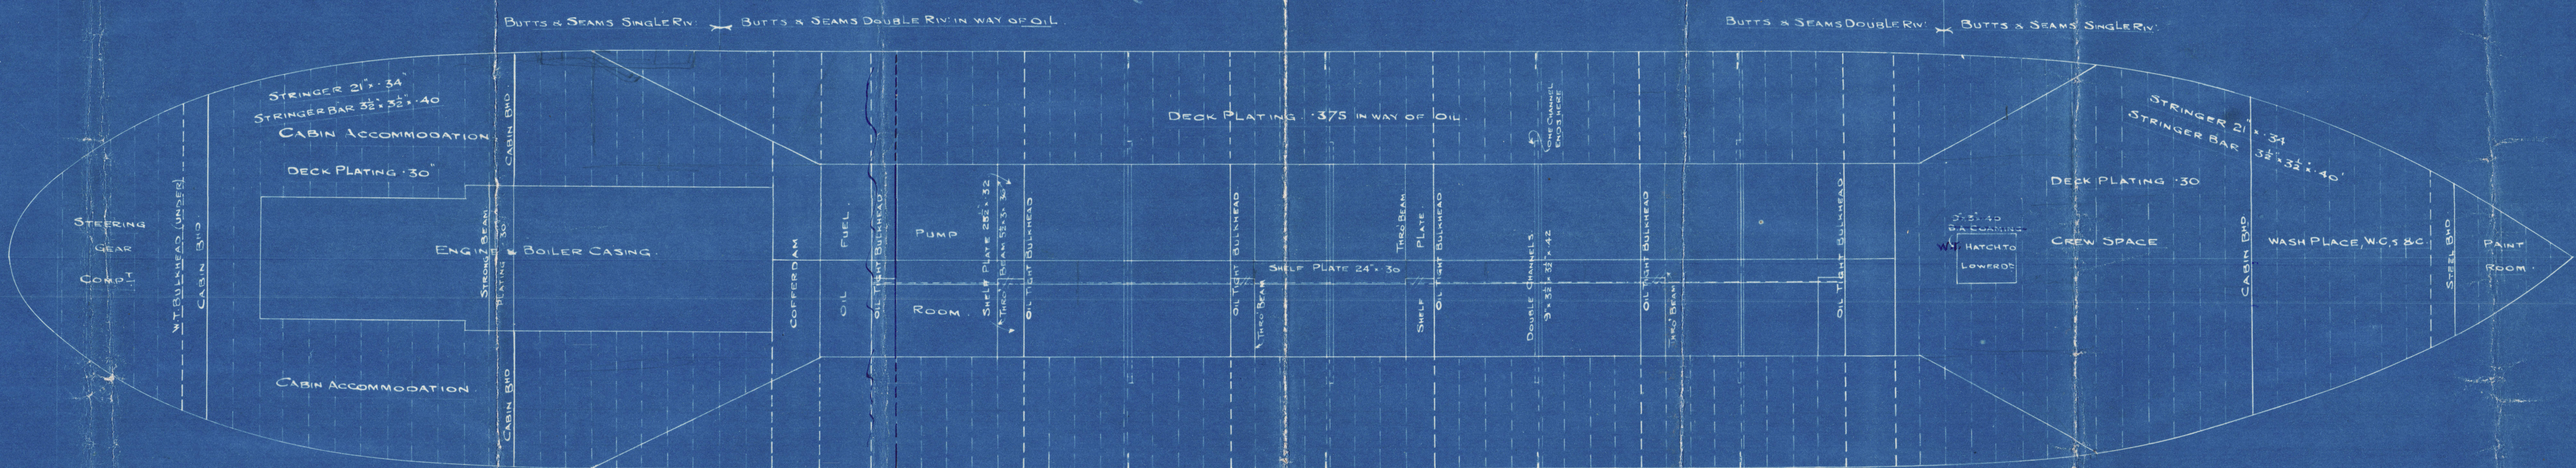

PLAN OF LOWER DECK & HOLD.

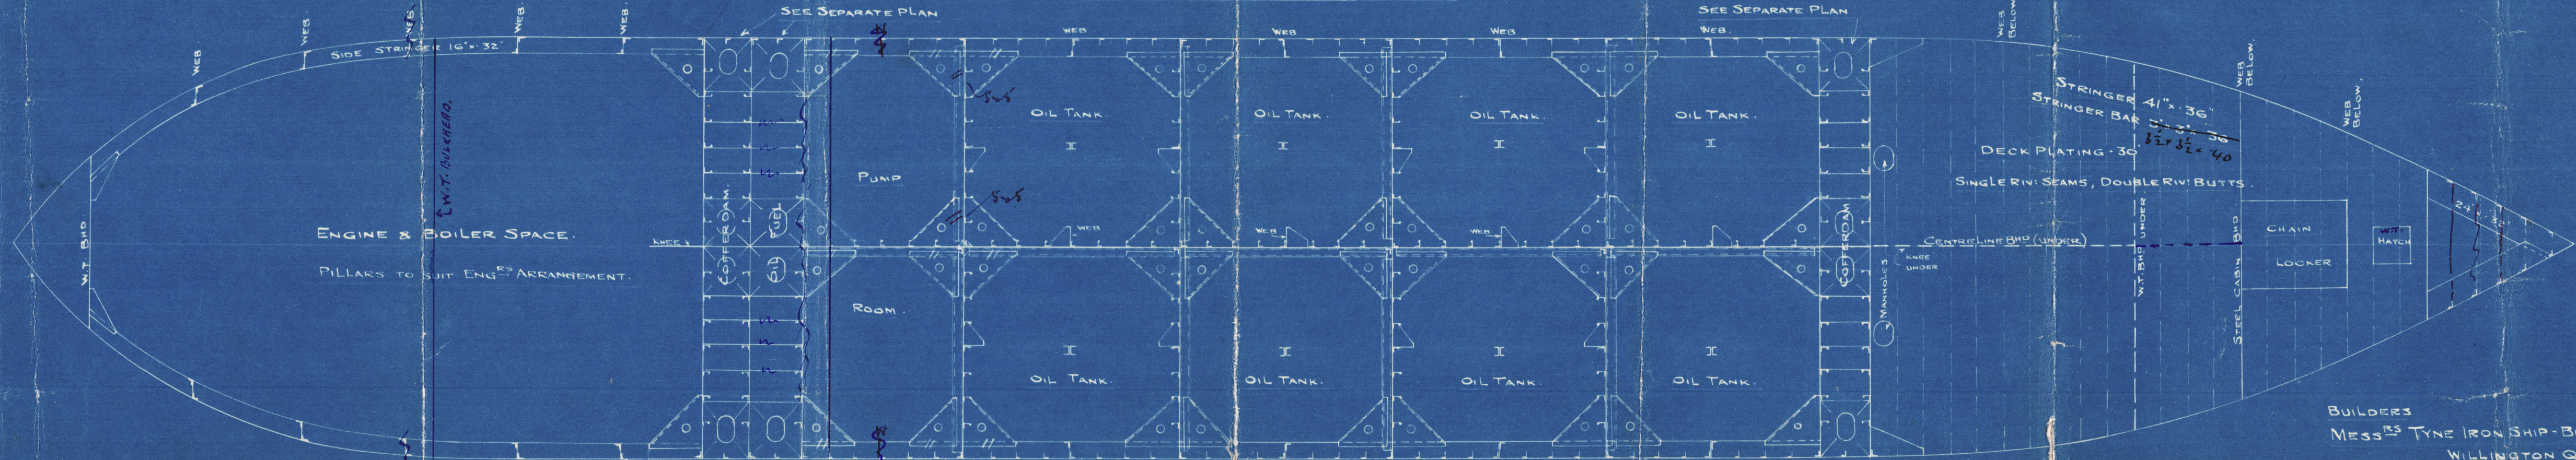

BUILDERS
 TRACING N^o 5718
 DATE 1918

Syne Iron SB. Co. Ltd

No 204 and 205

Plan of Profile and Deck plans.

R.F.A. PHILLO
NEWCASTLE ON TYNE

Report No. *69096*

DS 448





R.F.A. PHILLO
NEWCASTLE ON TYNE.

Report No. *69357*

Hemsley I

J.H.

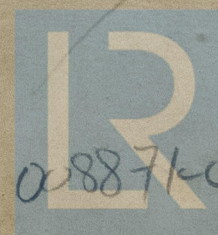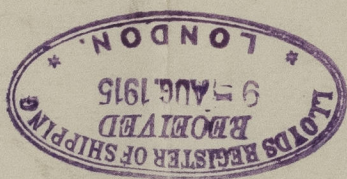

© 2020

Lloyd's Register
Foundation