



PROPOSED GENERAL ARRANGEMENT.

OF
1000 TON OILERS.
210'0" BP x 34'0" MLD x 16'6" MLD.
Nos 204-205.

SCALE 1/8" = 1 FOOT.

SECRET
AND
CONFIDENTIAL

ADVANCE COPY
APPROVED PLAN.
ALTERATIONS IN RED.

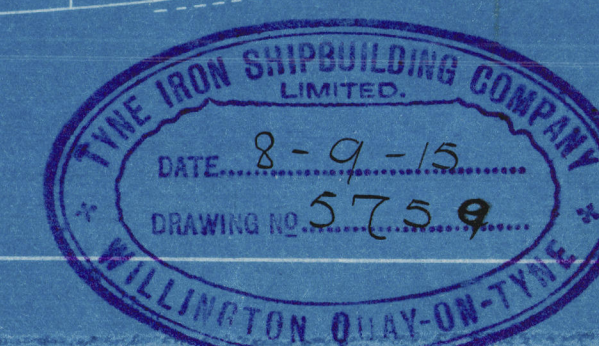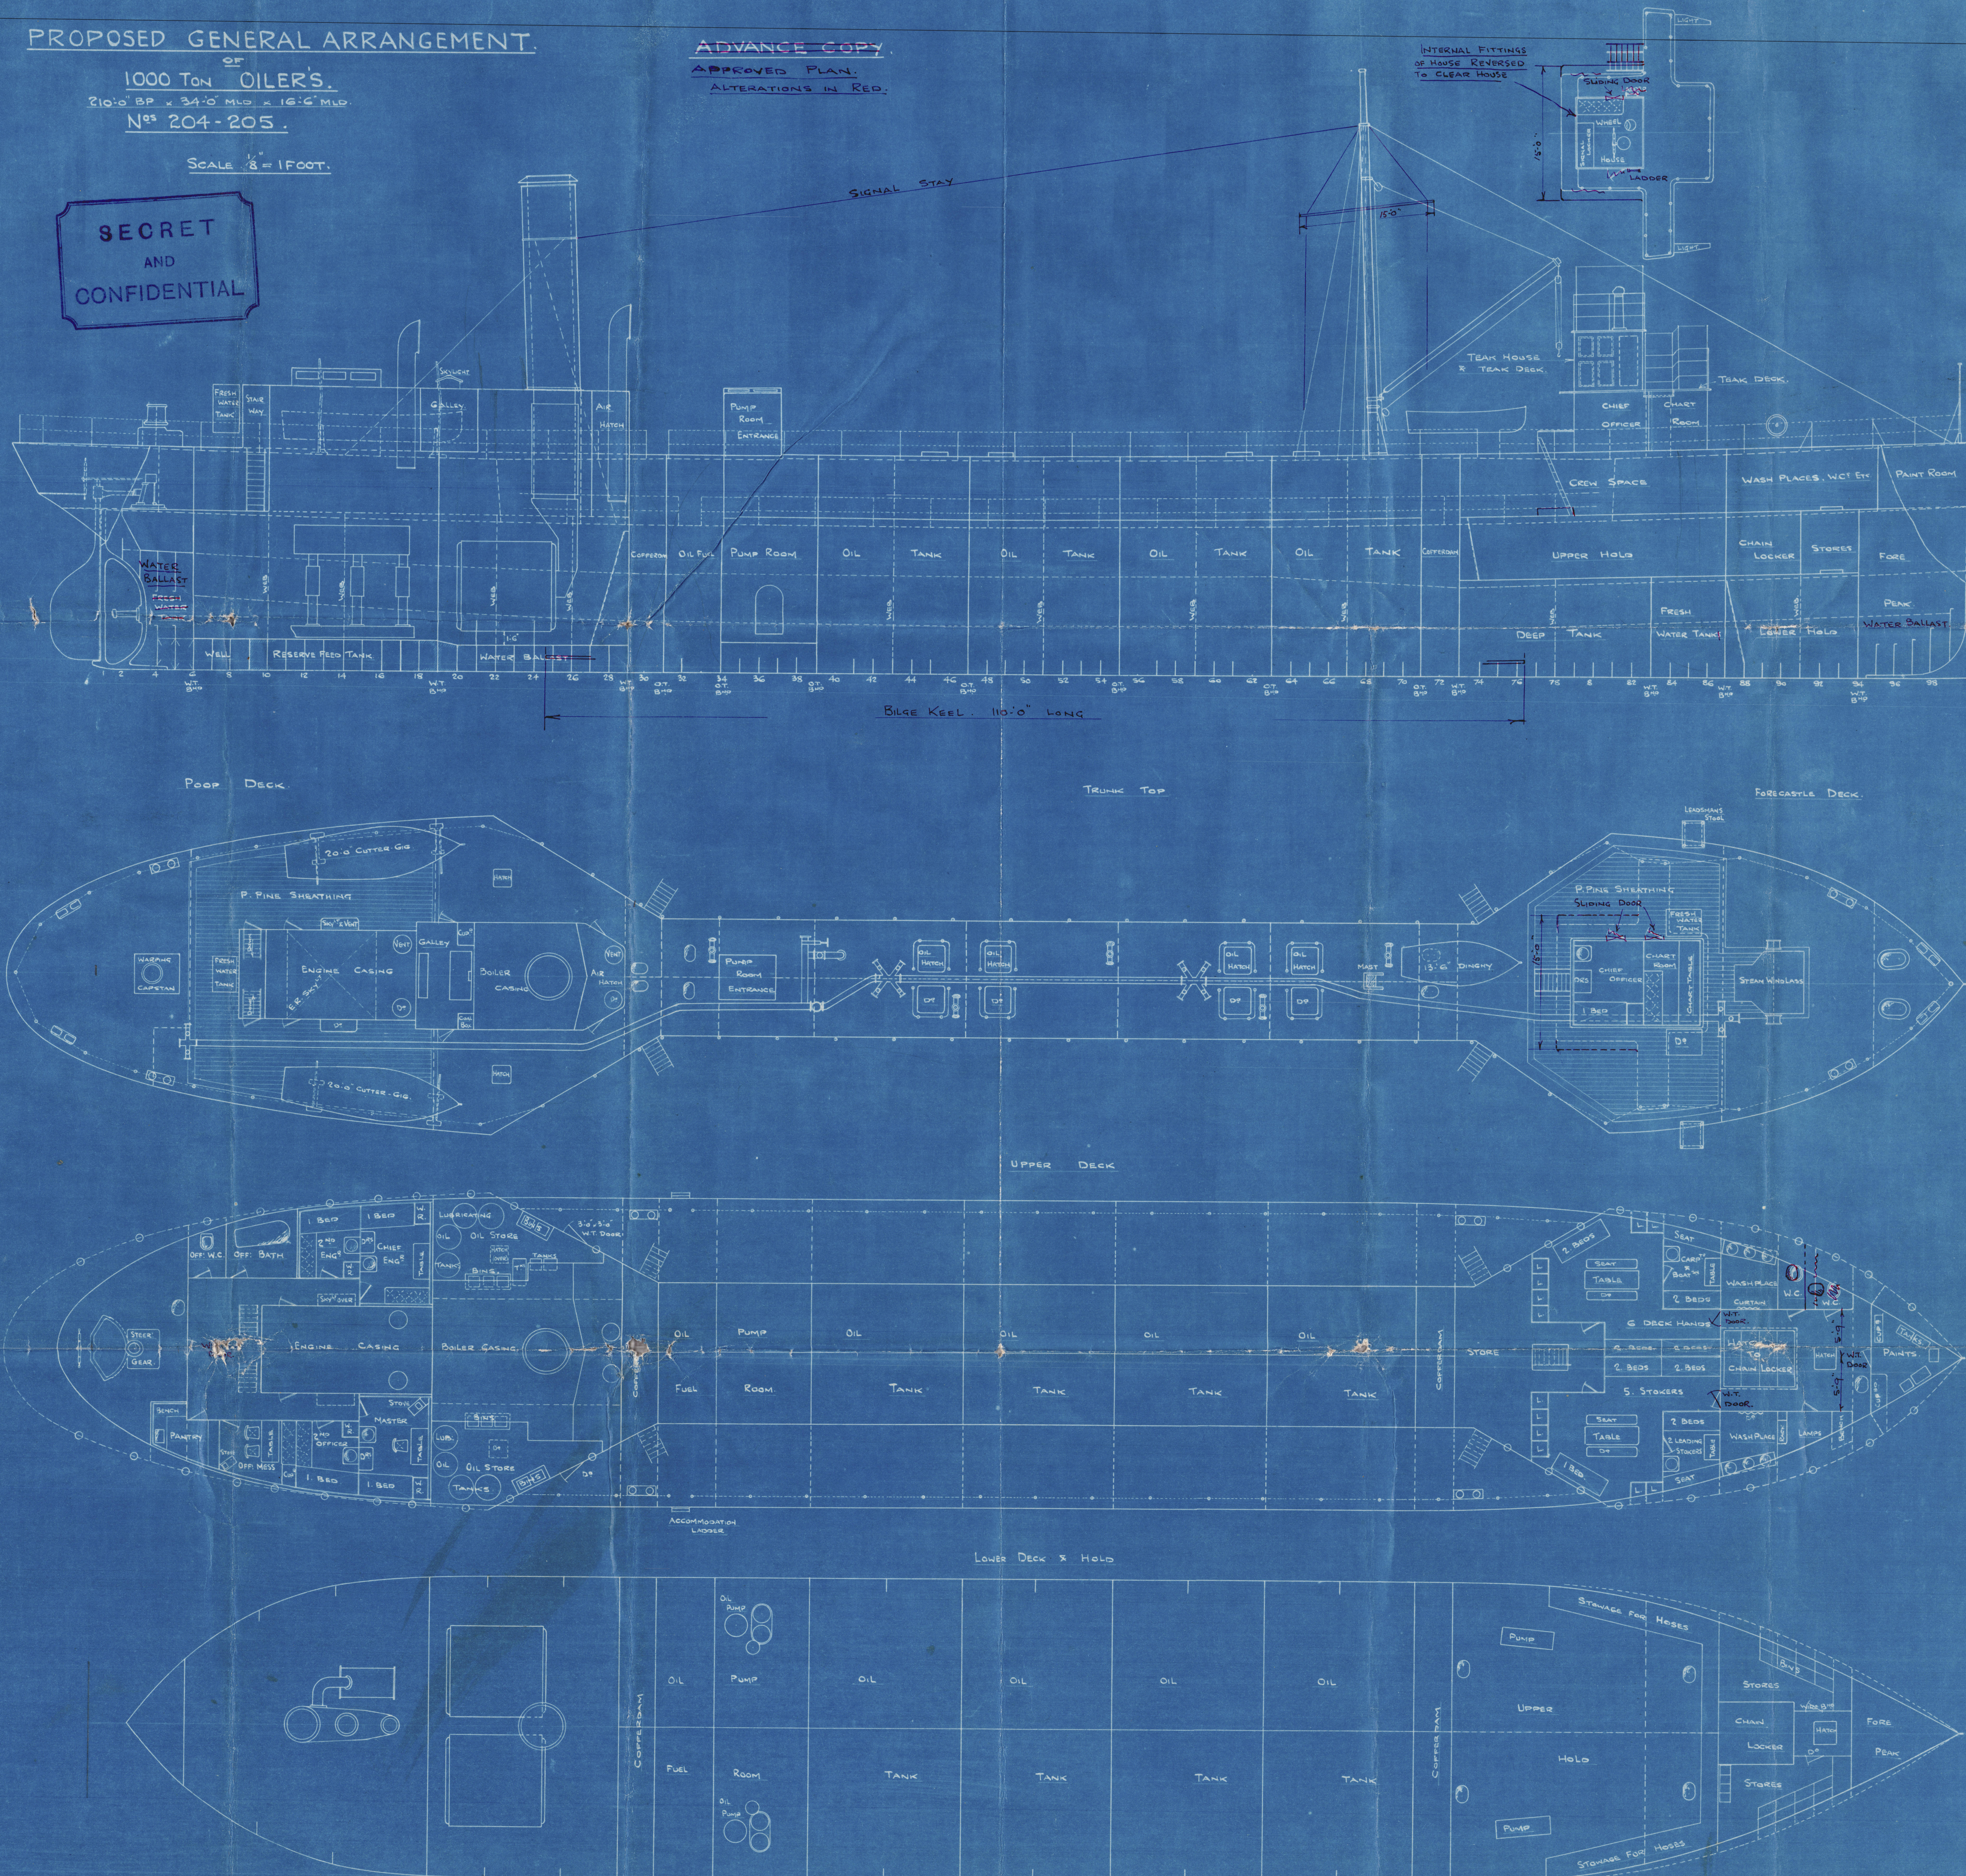

TRACING No 5743

DATE 24/8/15

Lloyd's Register
008871-008878-0006

Tyne Iron S. B. Co. Ltd.

3.

No. 204 and 205

General Arrangement plan

N/N. HEMSLEY I

R.F.A. PHILOL
NEWCASTLE ON TYNE.



Report No. 69096



R.F.A. "SCOTOL"
NEWCASTLE ON TYNE.

Report No. 69357

BUILT 1916

HEMSLEY I.
EX

SCOTOL

M.M. 8841

008871-008878-006

© 2020

Lloyd's Register
Foundation