

PROFILE & DECK PLAN.


S.S. "DARLENY"

SCALE 1/8" = 1 FOOT.




DIMENSIONS:-


425'-0" ON LWL, 56'-0" MLD, 28'-2" MLD. TO LOWER DECK, 36'-2" MLD TO UPPER DECK. CLASS 100A.I. WITH FREEBOARD. COMPLETE SUPERSTRUCTURE VESSEL WITH TONNAGE OPENING.

 


-UPPER DECK-

 

-SECOND DECK-

 


-F'CLE DECK-

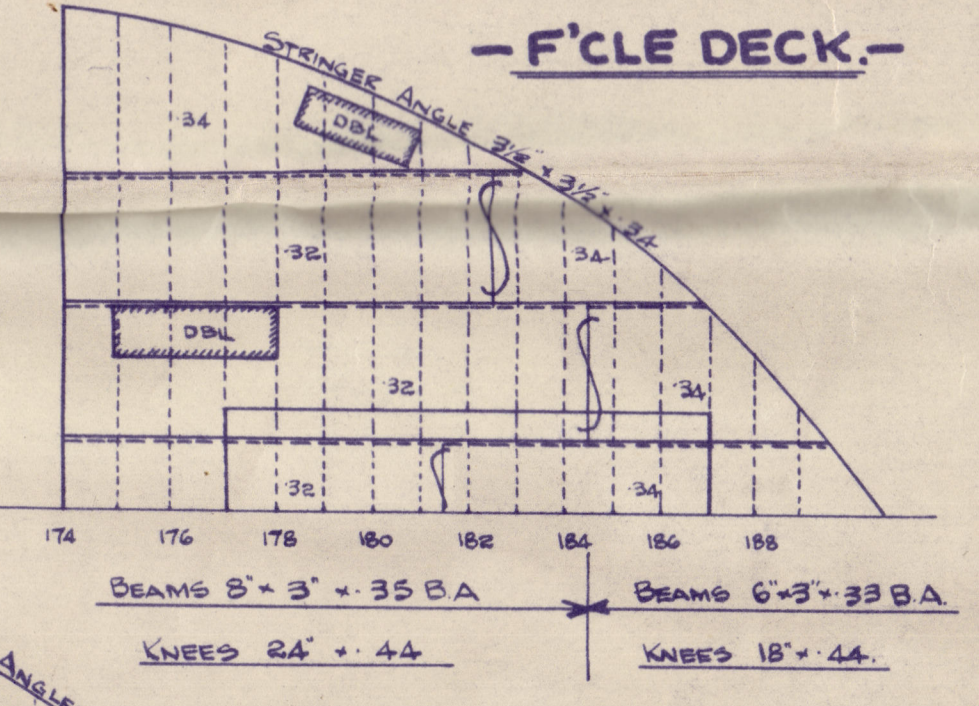

W. Hamilton & Co. Ltd.
Temple Yard
55 DARLEYN W. A. 27.

Profile & D.K. plans
as Built.

Gr. 1st E. Rpt. W.

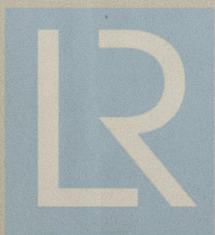

© 2021

Lloyd's Register
Foundation

008917, 008924 - 0156