

21-2-24

GENERAL ARRANGEMENT.

PROPOSED TWIN SCREW FERRY STEAMER.

FOR THE


FLEETWOOD URBAN DISTRICT COUNCIL.

SCALE: $\frac{1}{2}$ " = 1 FOOT.


DIMENSIONS.

LENGTH	ON DECK	67'-0"
BREADTH	MOULDED	17'-0"
DEPTH	"	6'-0"

PROFILE.

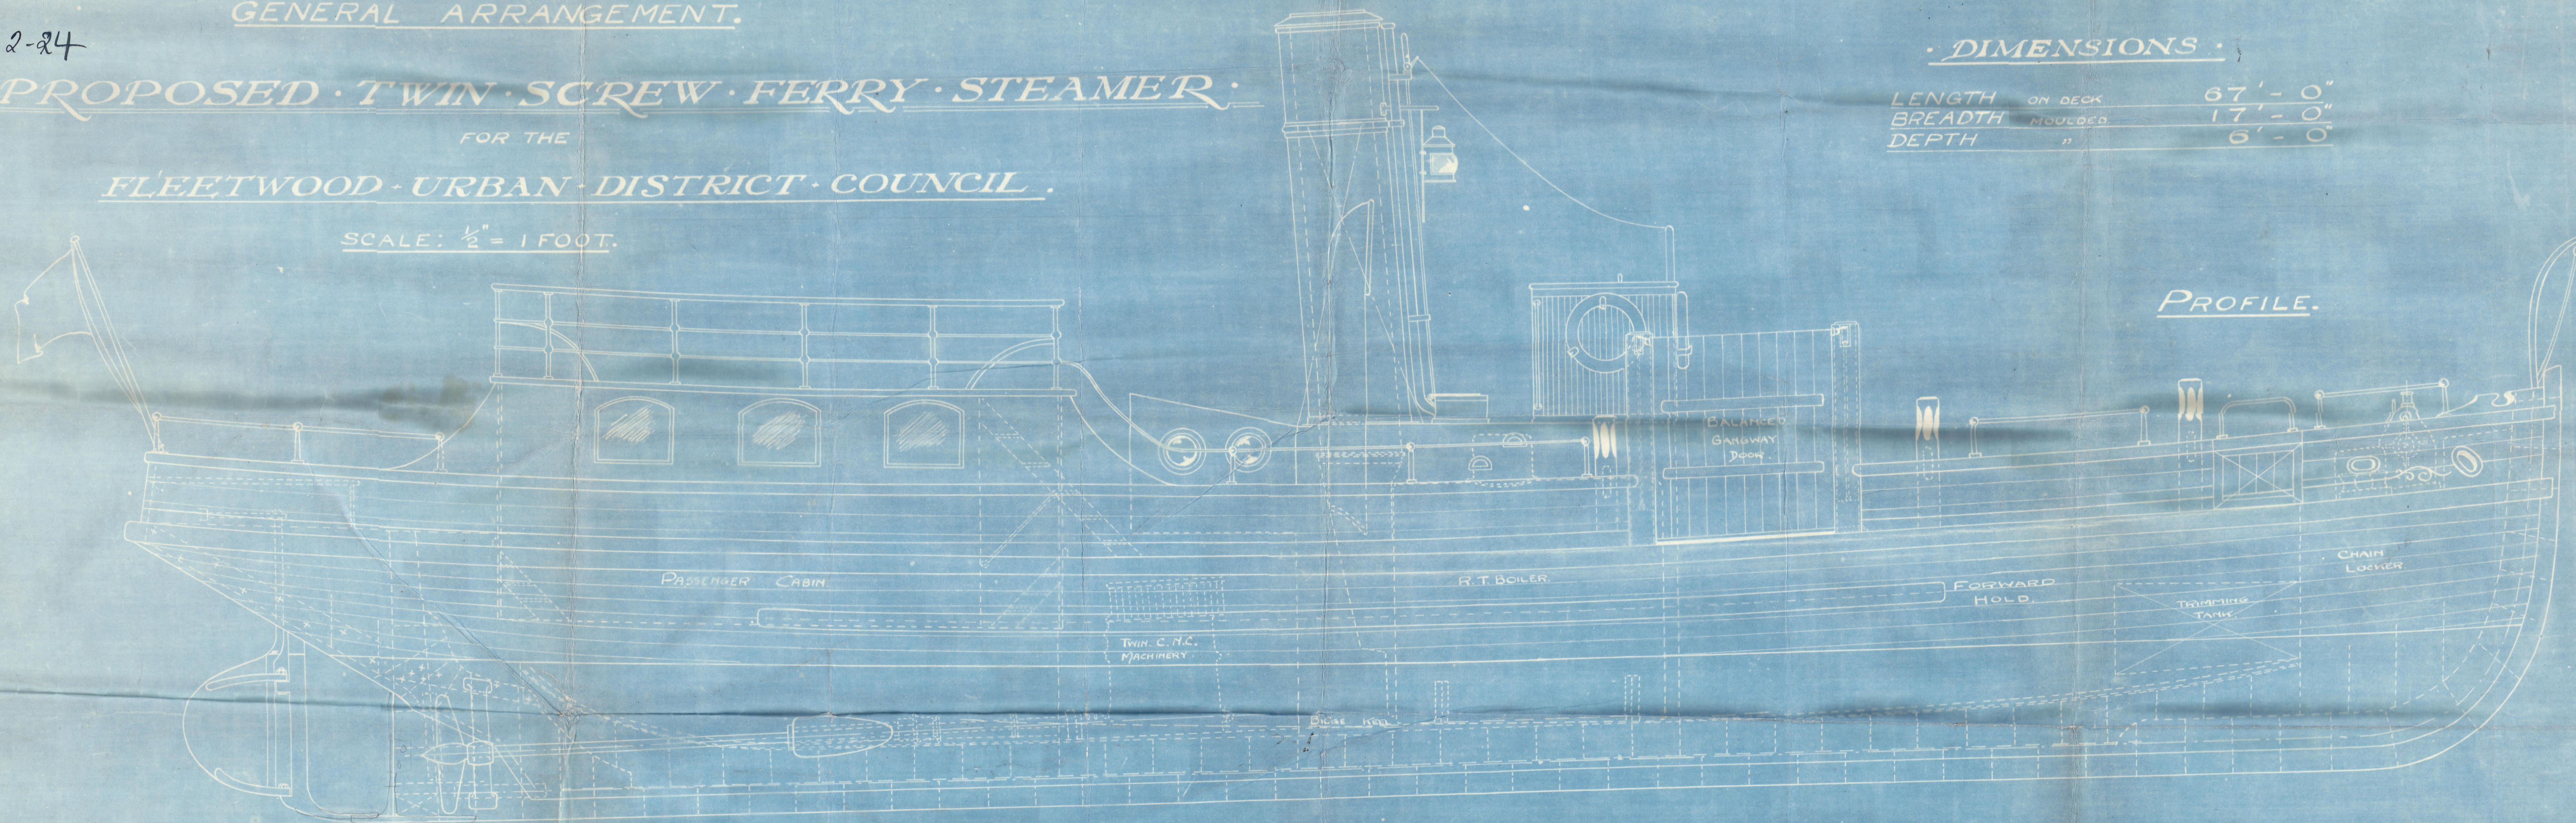

PLAN.

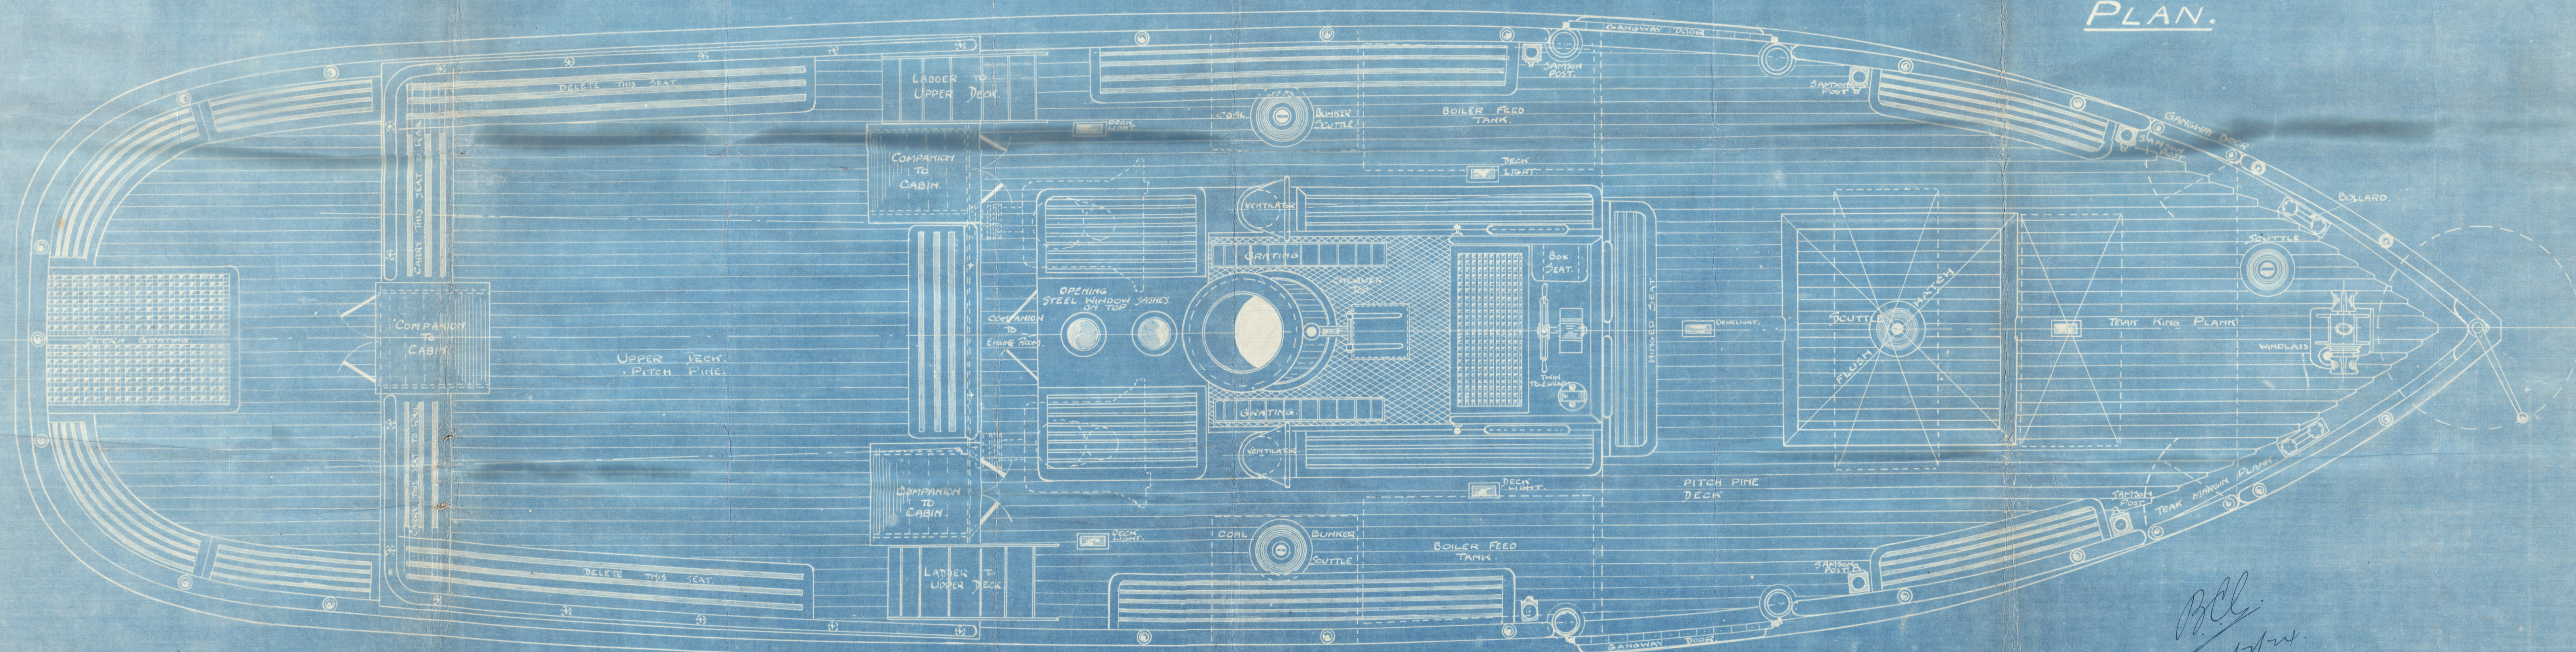

B.C.L.
201-2-24

Hleetwood Ferry
Boat.
General Arrang^{mt}

S.S. *Wipresdale*

LIVE
Report No. *87143*



© 2020

Lloyd's Register
Foundation

008964-008972-0001