

PROPOSED · TWIN · SCREW · FERRY · STEAMER FOR THE FLEETWOOD · URBAN · DISTRICT · COUNCIL ·


Fleetwood & Knott Ltd

SCALE. 1" = 1 FOOT.

MIDSHIP SECTION :

SECTION AT N° 16.

21-2-24

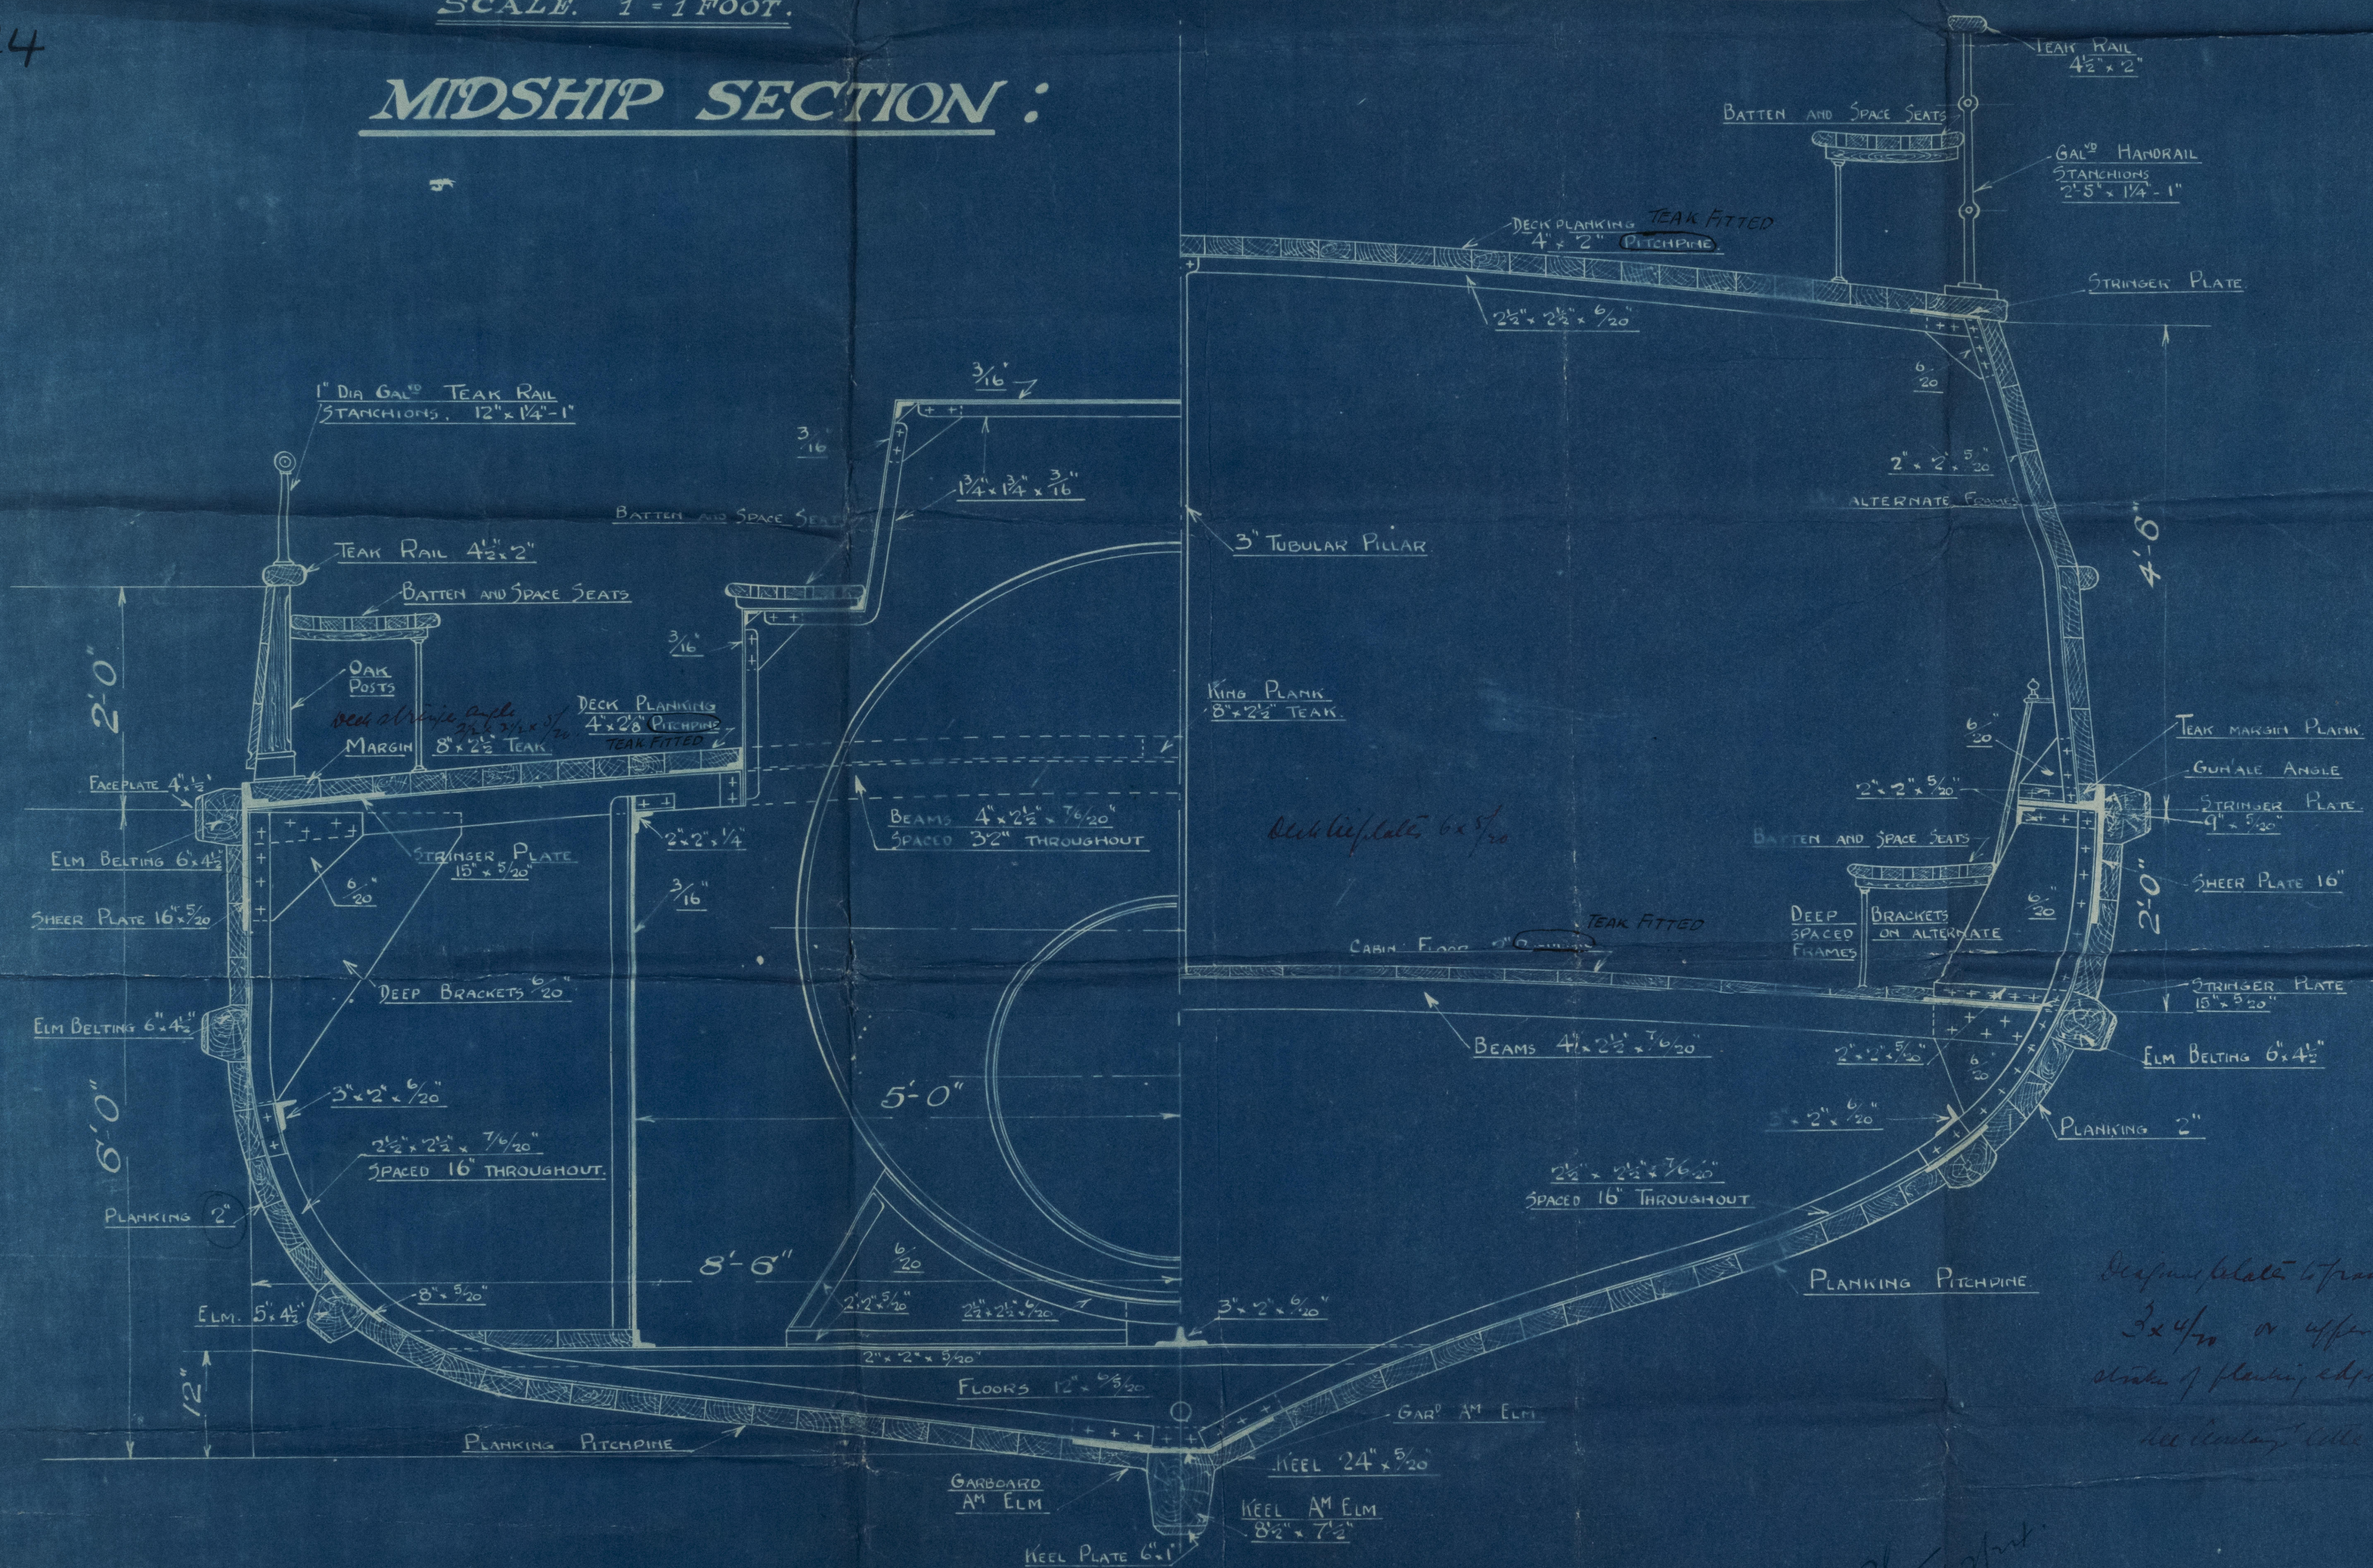

Deepened plate to frames.
3x4/16 or upper three
strikes of plating, edge bolts
see drawing, called out 20/7/24

Bel
not of pt.



Fleetwood Ferry
Boat

Midship Section.

S. S.

Wyrre date

LIVE

Report No.

87143



© 2020

Lloyd's Register
Foundation

008964-008972-0002