


NEW FERRY STEAMER FOR THE F.U.D.C.

10/3/24

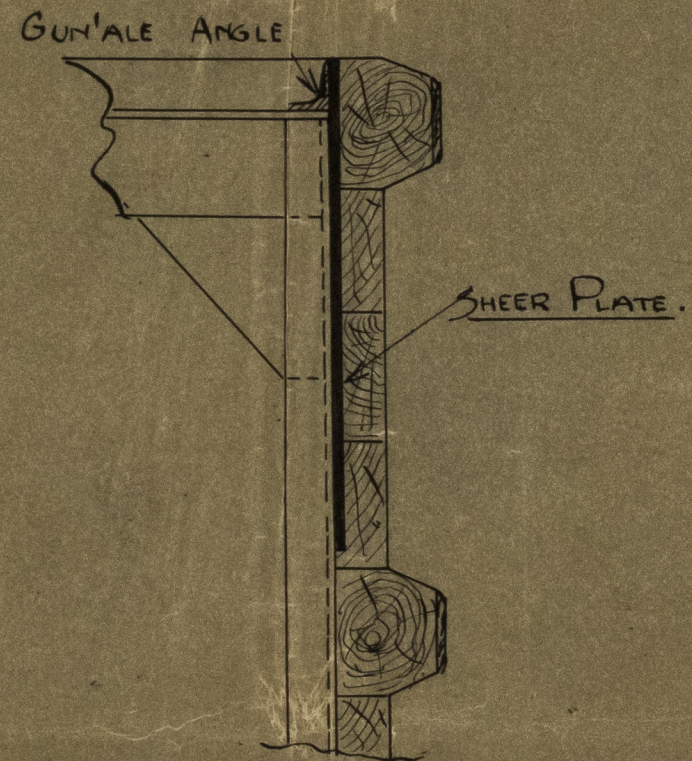

PROPOSED ALTERNATIVE METHOD OF WORKING SHEER PLATE AND METHOD
OF BOLTING INTERMEDIATE PLANKING BETWEEN BELTINGS

J. ROBERTSON AND SONS (FD) LTD
 FLEETWOOD.

7/3/24.



2020
 10/3/24
 Lloyd's Register
 Foundation
 008964-008972-0003