

EQUIPMENT NUMBER			
L X (B+D) =	200 + 2080 + 15 =	1246-6	10366 -
QUARTER DI	155 + 325 =	255-4	262 -
CASINO & C	175 + 1020 + 7 + 5 =	140-3	201 -
FORECASTLE	317 + 75 *	162-7	163 -
		10425-0	10400 -

EQUIPMENT.

2	BOWER ANCHORS	25% CWT. STOCKLESS.
1	" "	202 -
1	WEIRDS ANCHOR	2 - " " not required
1	STREAM "	6 - " " not reqd
60	5' STEEL WIDE	
90	3' " "	
90	TWILING	x 2 1/4" steel wire { miter & round consistent
90	HAWSEP	x 1 1/4" " " " " bolted wire
	WARP	

MIDSHIP SECTION.

DIMENSIONS 200'-0" B.P. x 37'-0" EXTR. x 15'-0" DEPTH MLD

2.2. DECK 3'-3"


TO CLASS LLOYDS 100 A.I. (1921-22 RULES).

SCALE $\frac{1}{2}$ " = 1 FOOT.

SECTION IN WAY OF RAISED

QUARTER DECK (CLEAR OF OIL.)

DRAWN THROUGH BOILER SPACE.

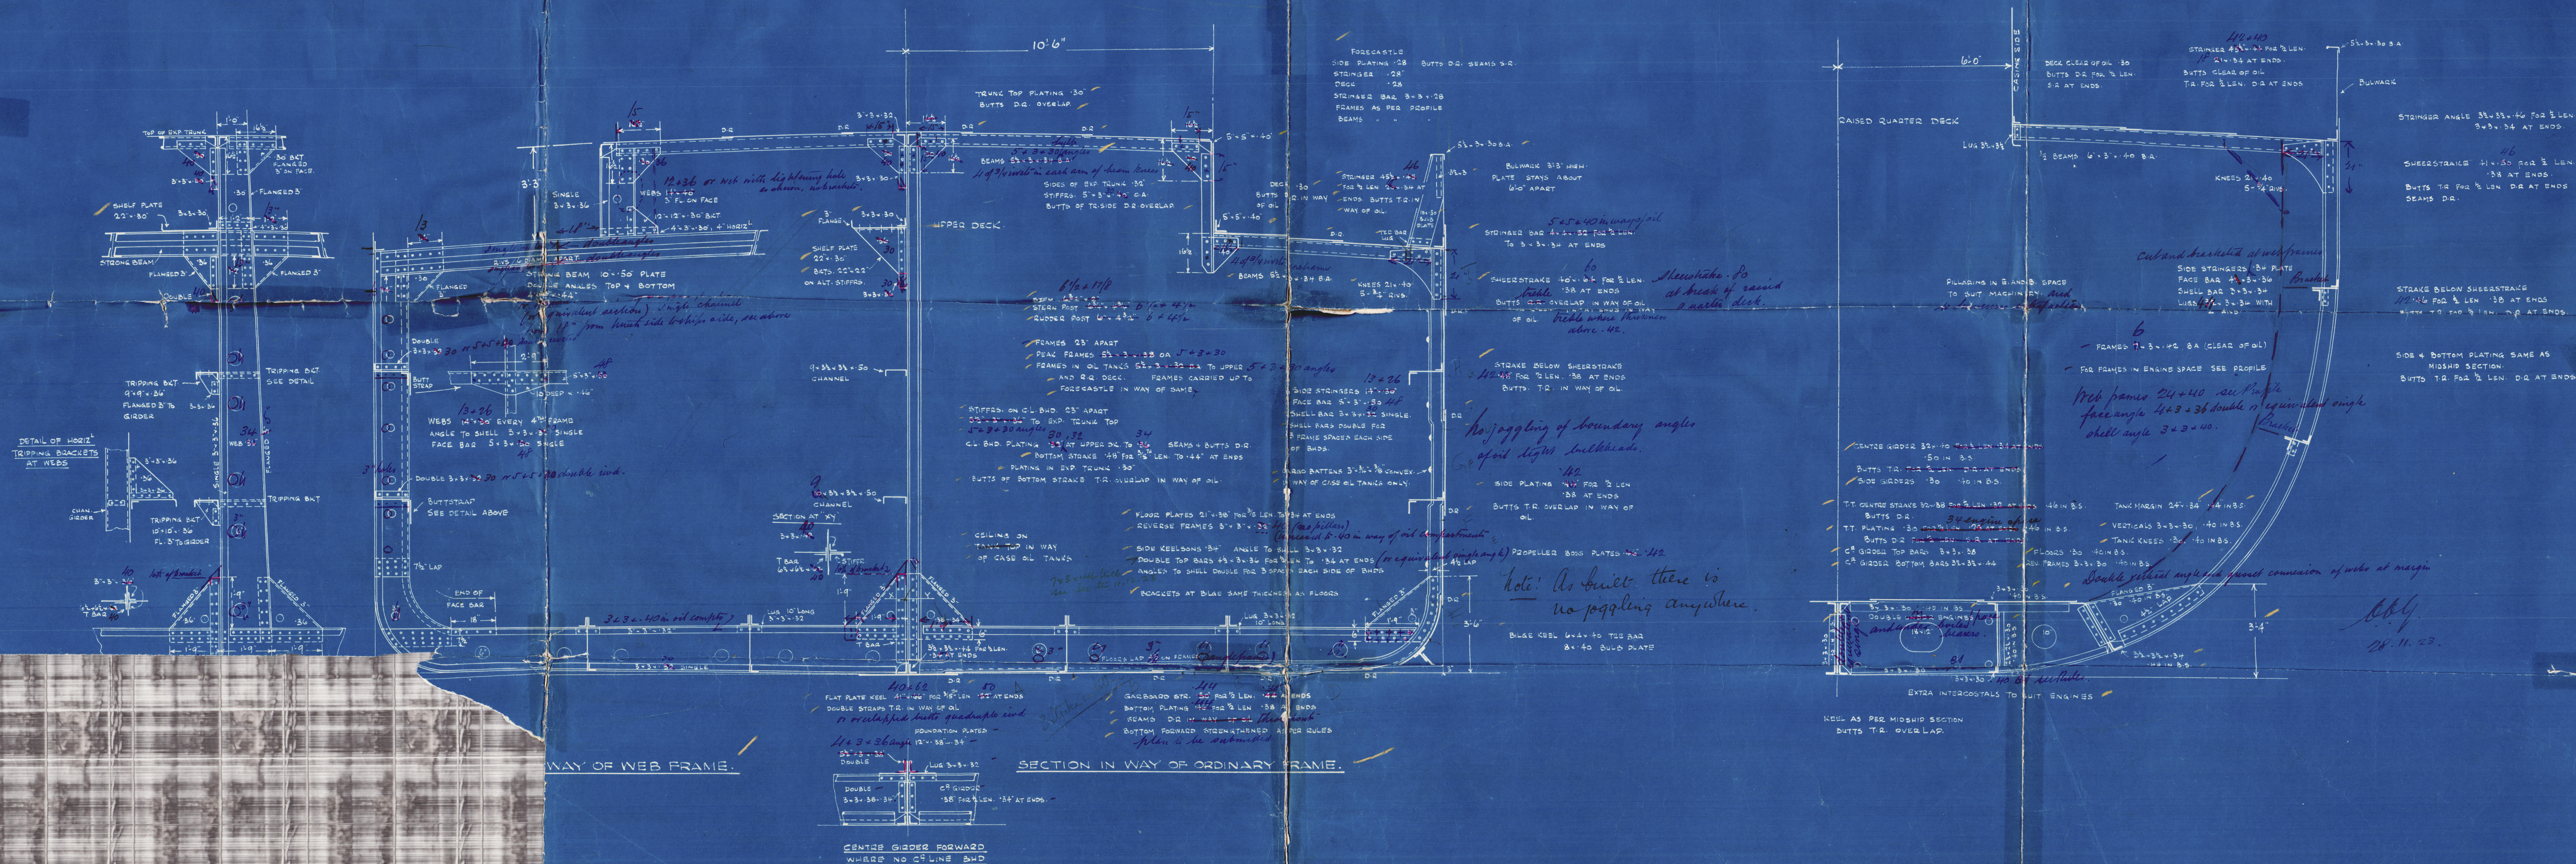

PLYMOUTH

Semara

Messrs Philip & Son Ltd.,

Dartmouth.

SS No 670

Midship Section.



© 2020

Lloyd's Register
Foundation