




[illegible]

## FINISHED PLAN

009004-009007-0112

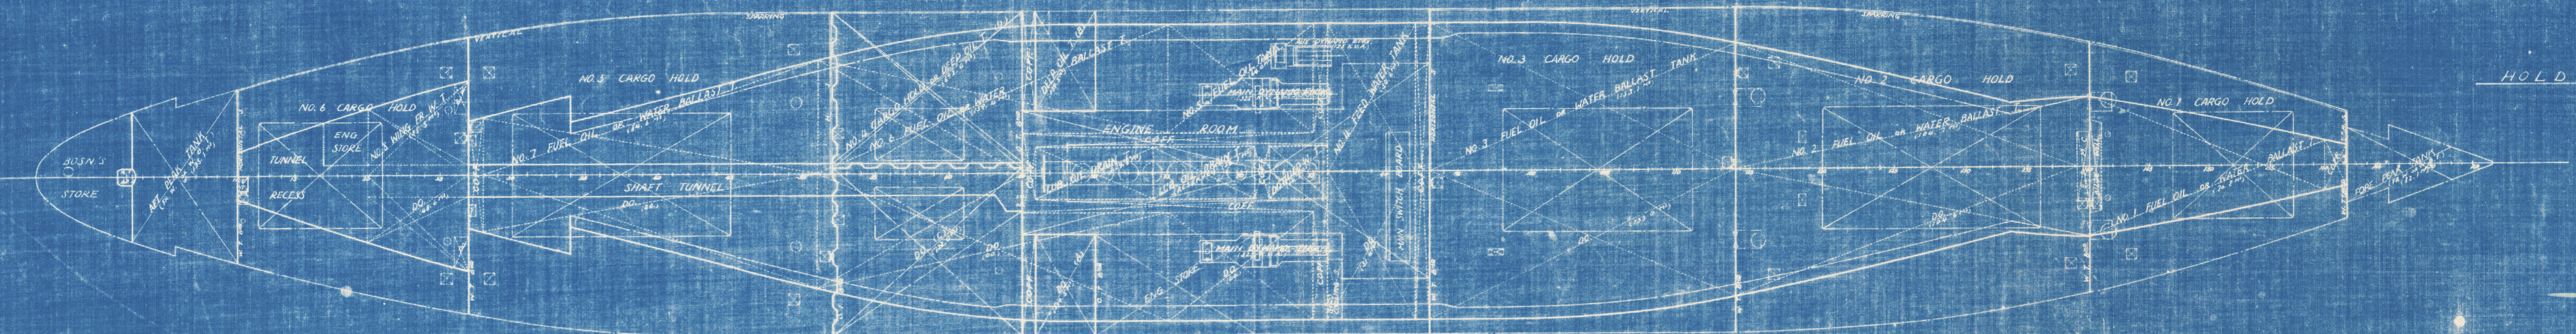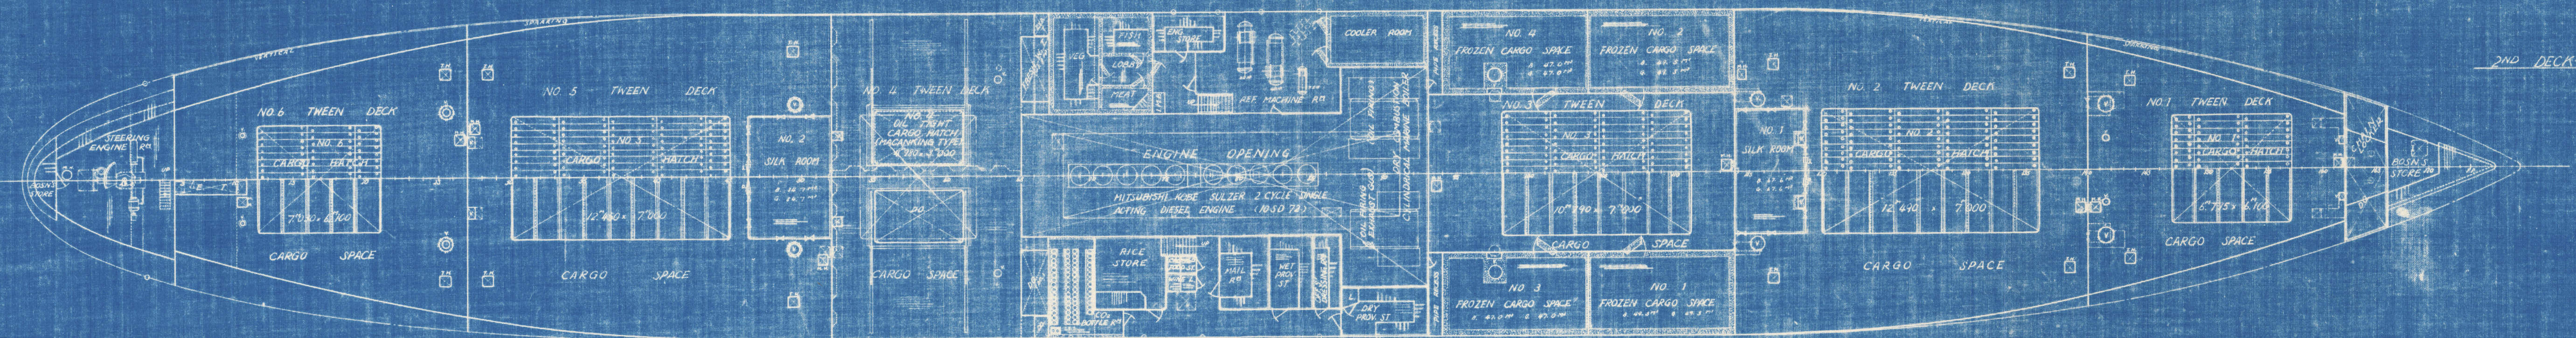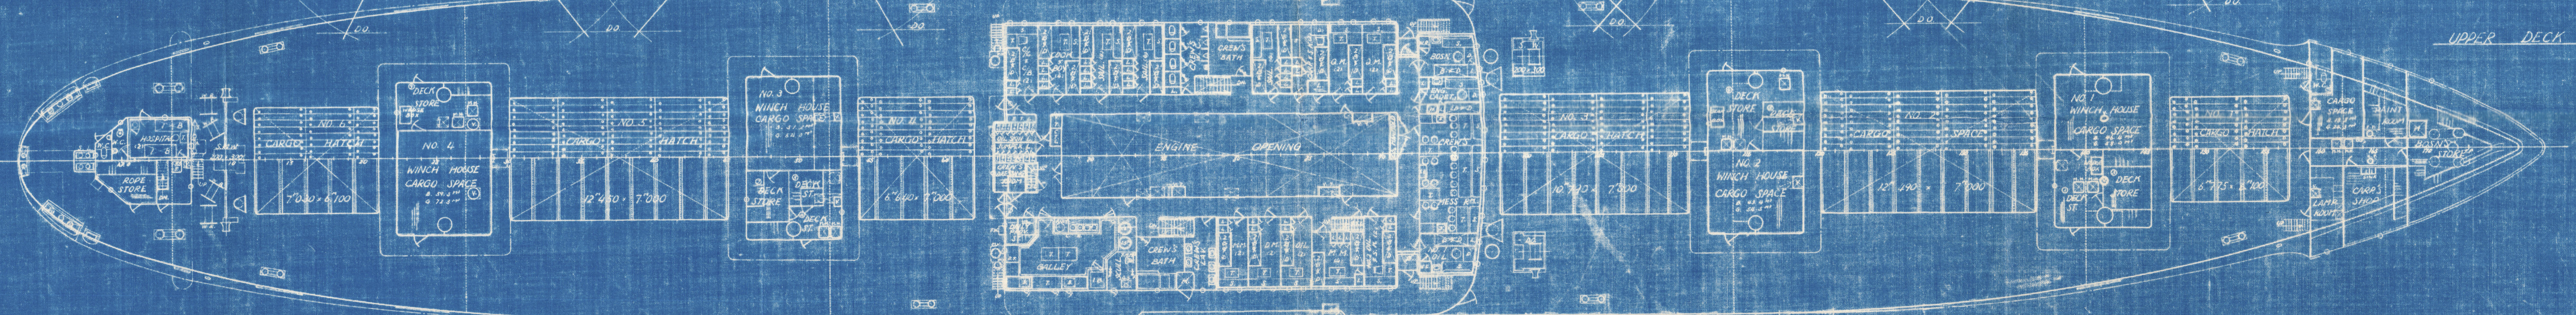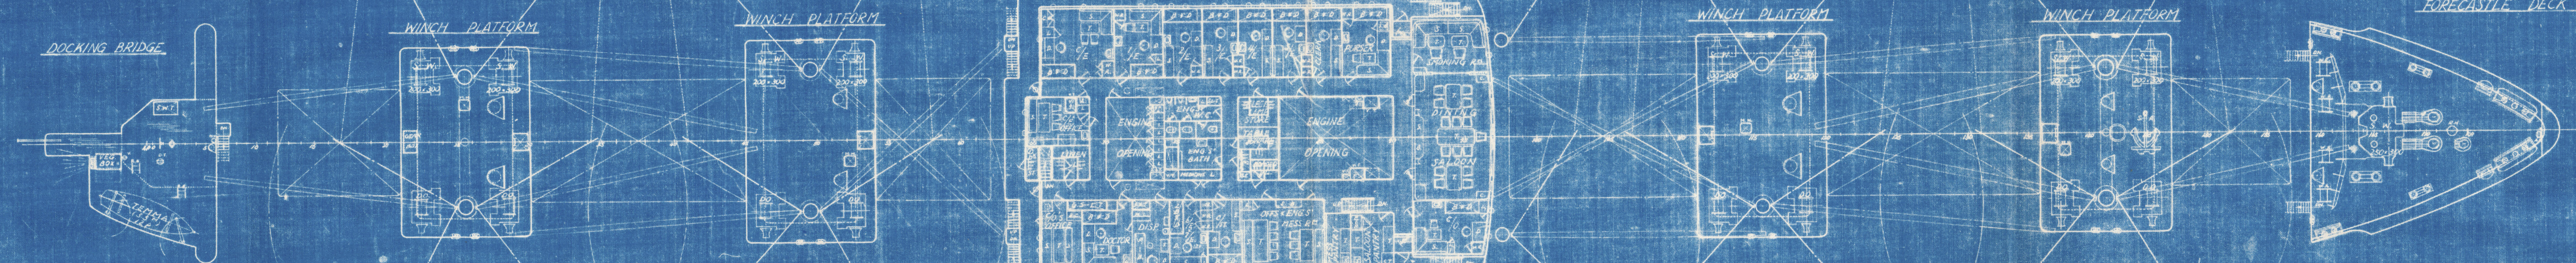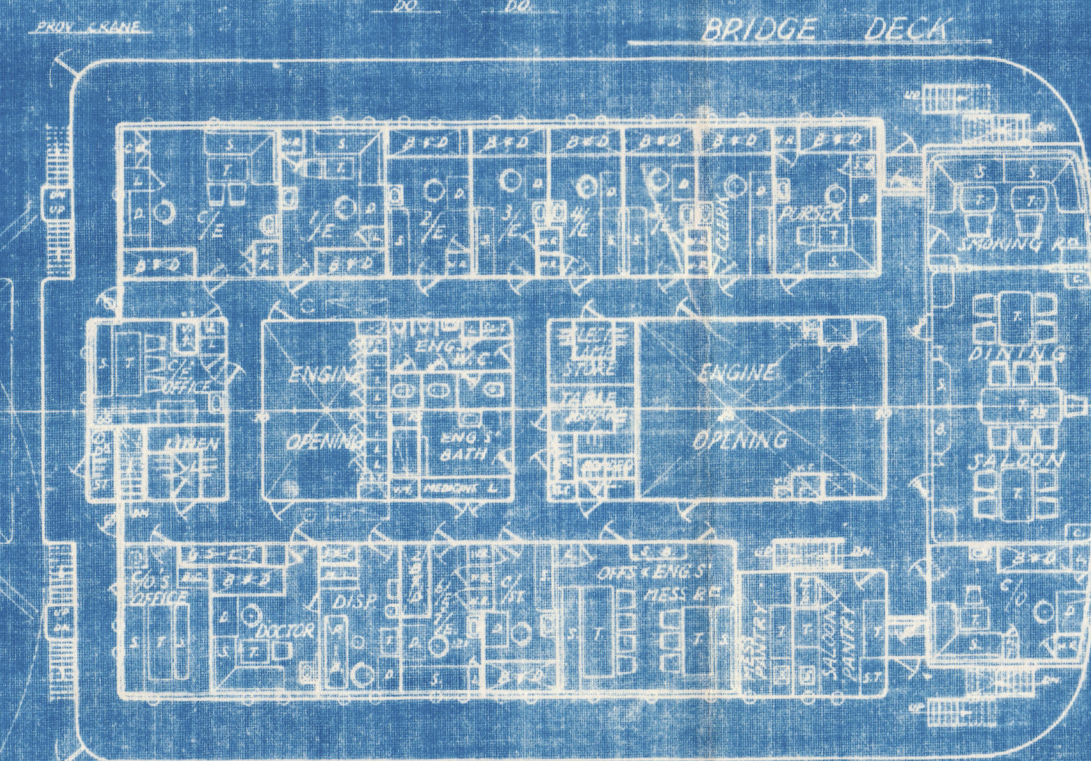

ロ  
イ  
ド  
船


KOBE RPT. No. 1770

DATED. \_\_\_\_\_

協

會

御  
中


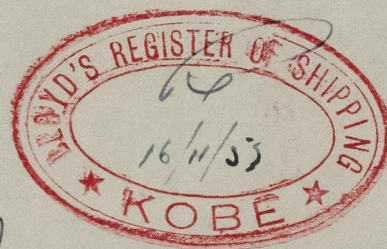


★ HIYEHARU MARU

Gen. amgt.

AS FITTED

RECORDS DEPT.  
LONDON.

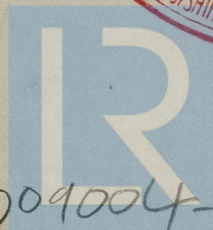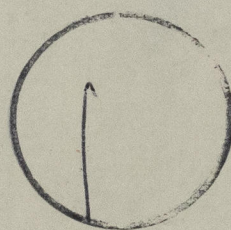

Lloyd's Register  
Foundation

009004-009007-0112