


- | | | | | | |
|------------------------|---------------|-------------|-------------------|-------------------------|----------|
| FINISHED PLAN | | | | | |
| S.NO.855 HIYEHARU MARU | | | | | |
| STERN FRAME | | | | | |
| S.N.O. 84E
107 | 主事官
大野 幸四郎 | 船名
ヒエハル丸 | 建造年
昭和27年8月29日 | SCALE
$\frac{1}{20}$ | SC 102-2 |

FINISHED PLAN 5 HIYEHARU MARU STERN FRAME

SC 102-2

009007-009004-0113

TO COMMITTEE OF
LLOYD'S REGISTER
OF SHIPPING
FOR

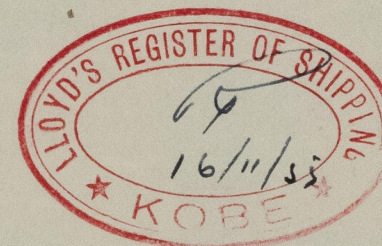


★ HIYEMARU MARU

CERTIFIED COPY OF "APPROVED PLAN"

KOBÉ RPT. NO. 1770
DATED. _____

RECORDS DEPT.,
LONDON.

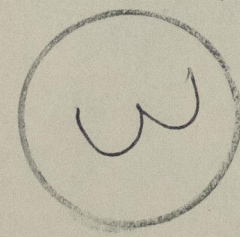

Sternframe.



009004-004007-0113