




8-1-18
16-4-18 (110)
10-9-18 (111)

LONGITUDINAL SECTION

S. S. No 109.
Scale 1/8 inch = 1 foot

NOTE: IF ANY SCANTLING, STRENGTHENING ETC.
WHICH WE HAVE HEREON SUBMITTED, BE IN
EXCESS OF YOUR MINIMUM REQUIREMENTS
KINDLY AMEND SAME.

Masts:- steel 4 1/2" tank top to top of steel
18" x 30" at deck
15" x 25" at head } hinged 4 ft above deck
16" x 25" at heel
Lanterns 18" Bolls 3R above deck 2R below.
Doubled for 4 feet at deck and 18" at heel.

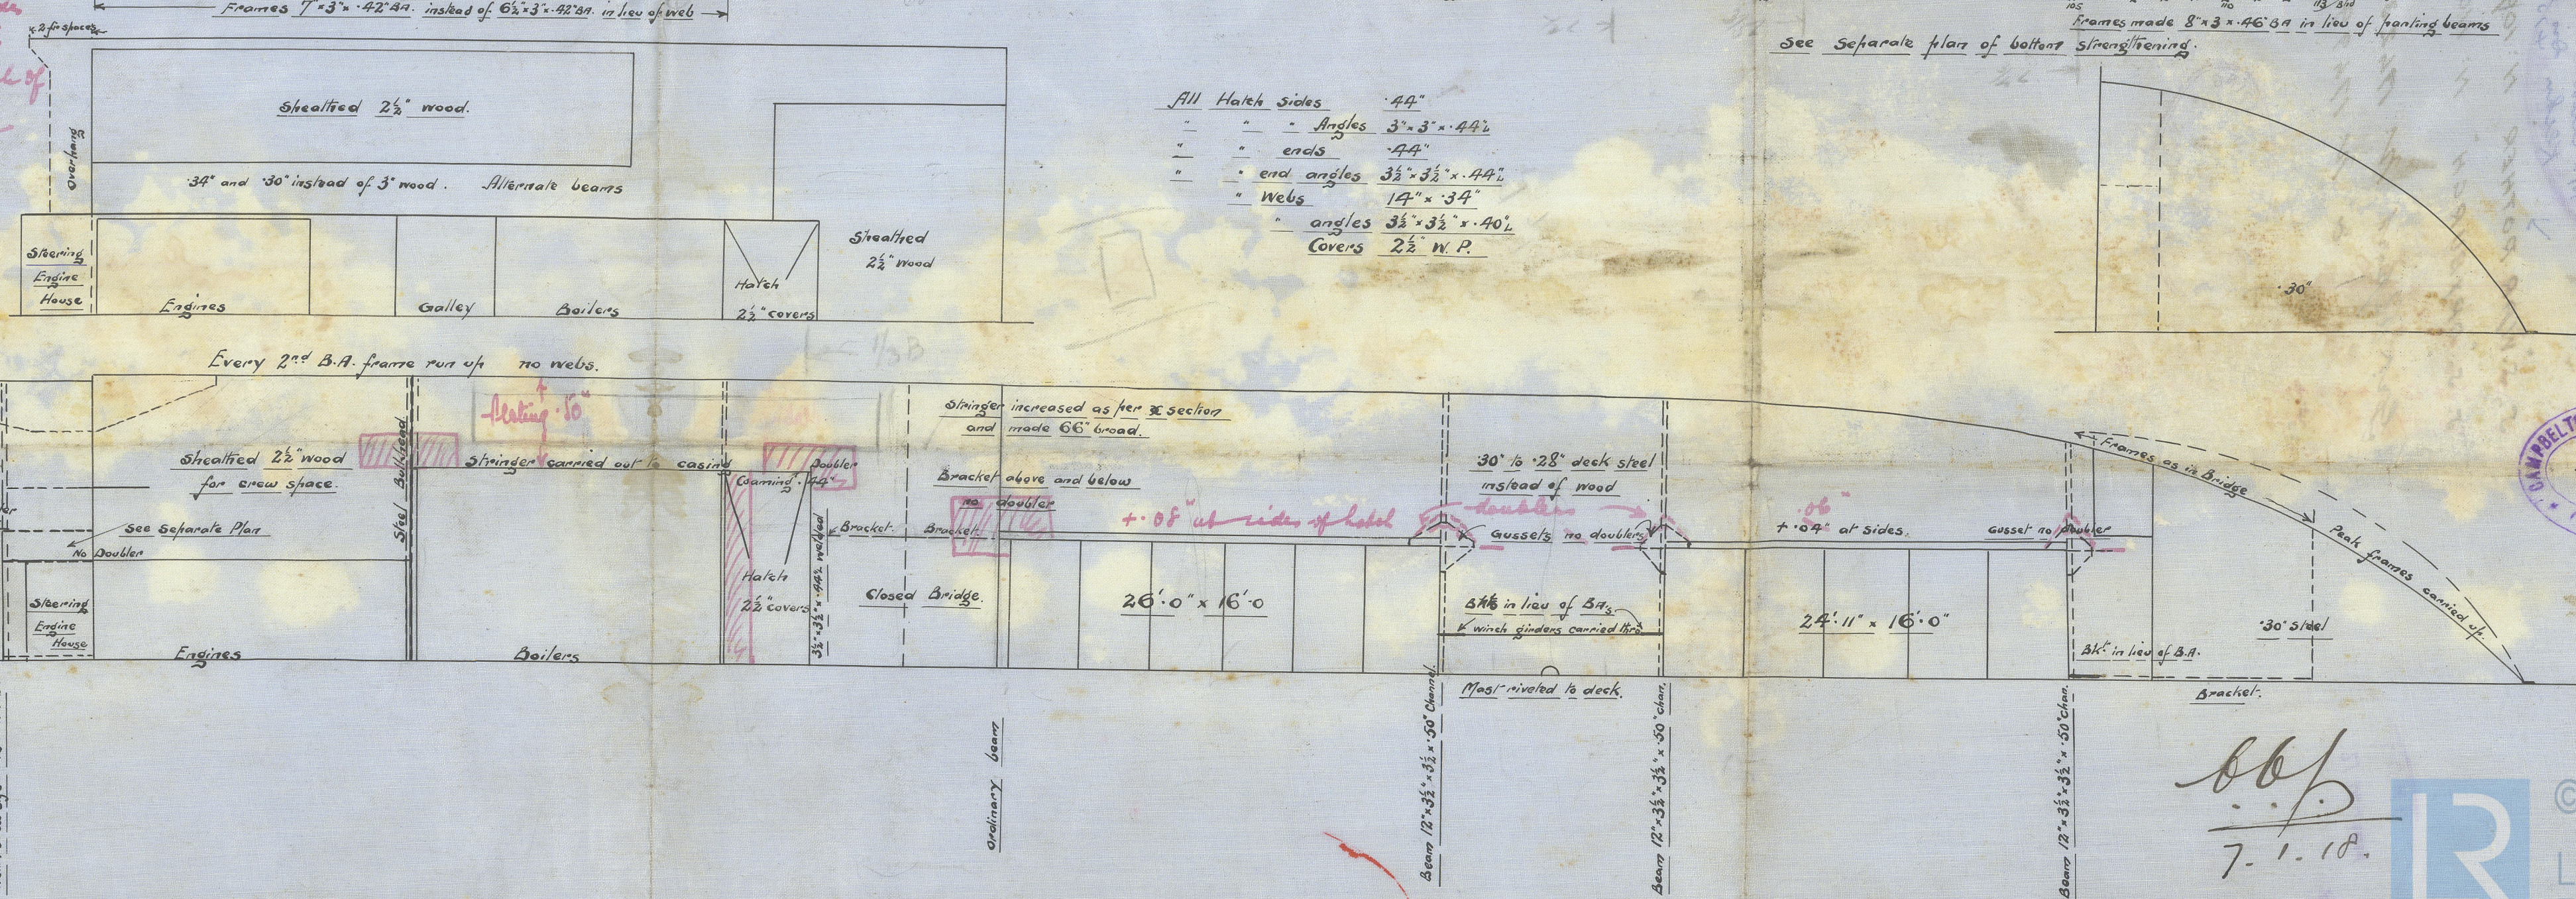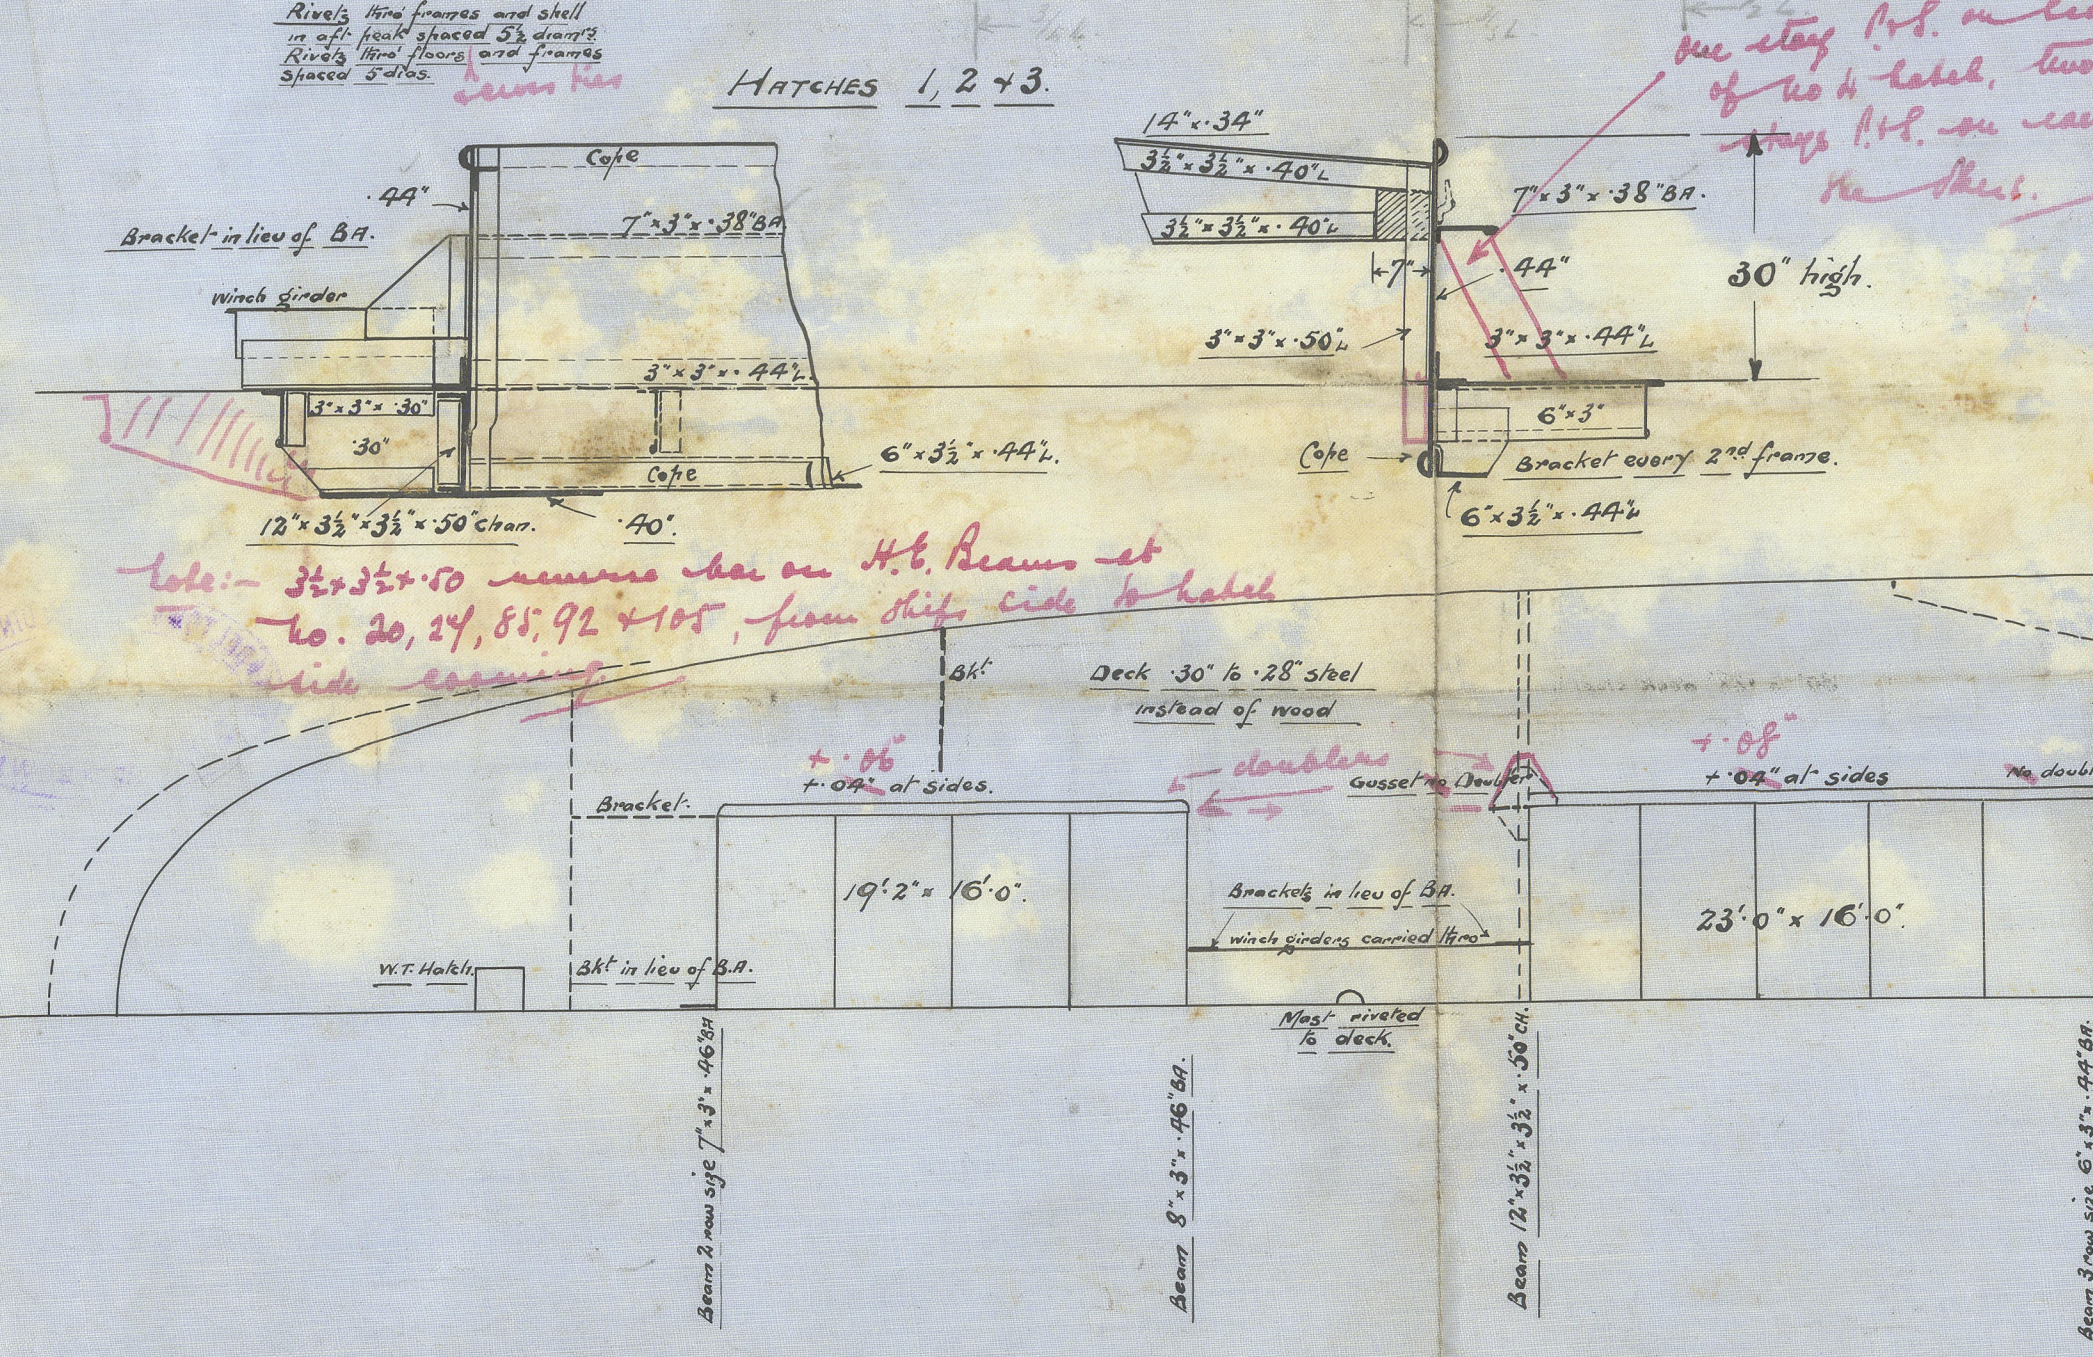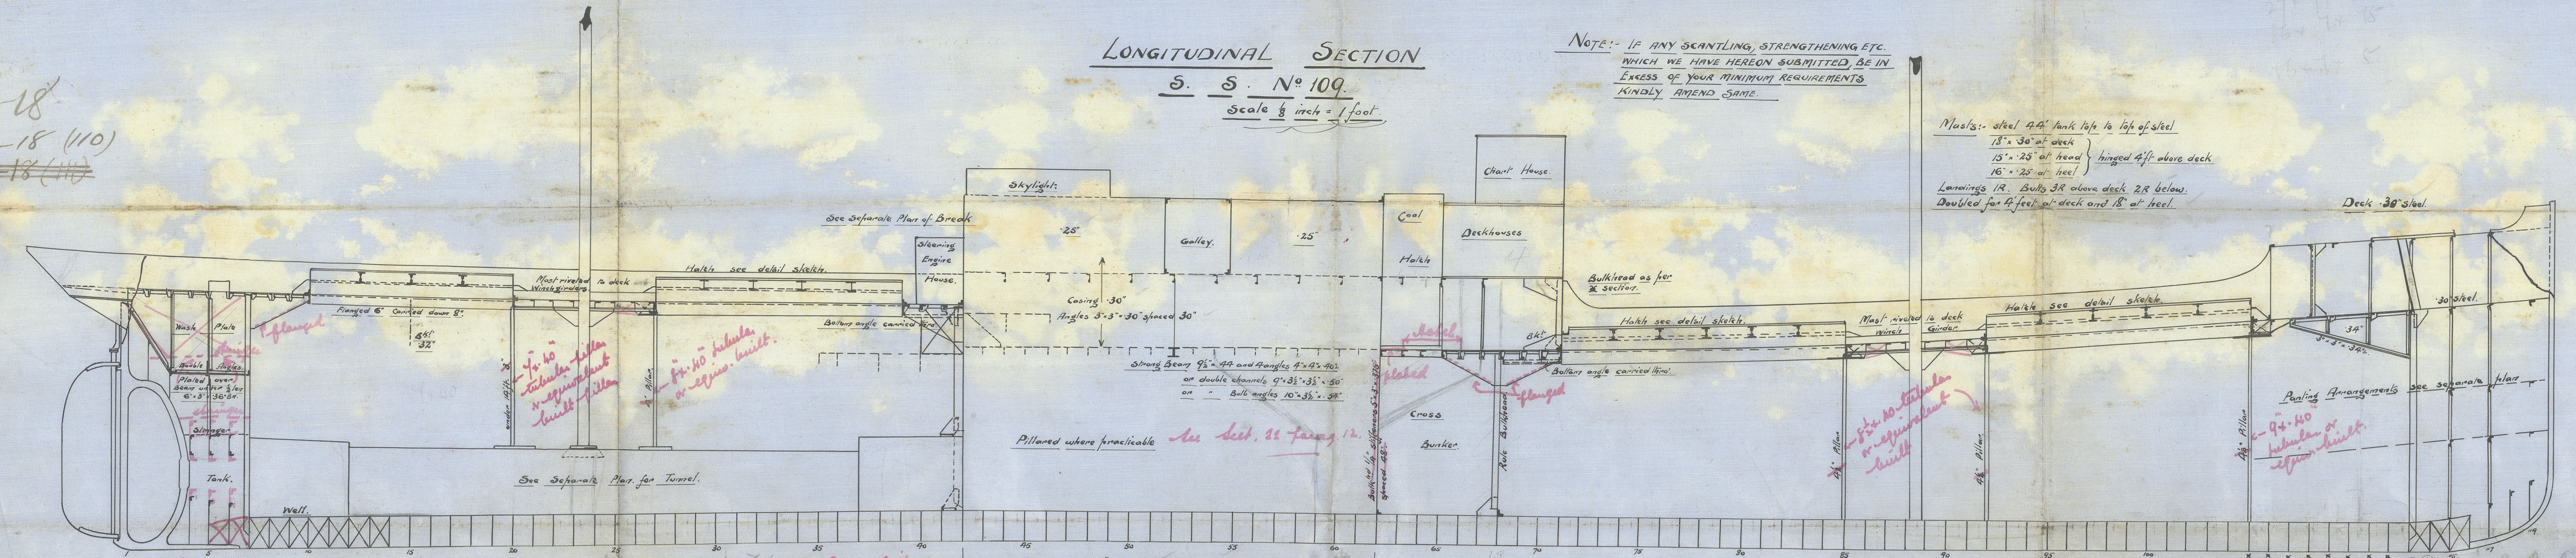

22/12/17

7-1-18

Campbelltown S.S. Co. Ltd
No 109 + 110
Profile and Deck Plan

Transferred to NIN Clan
Kekin Dis 475

S. S. WAR ROTHER N: 109

S. S. "DRYBURGH" N: 110.

Gr. Report N: 17423
& N: 17499.



© 2021

Lloyd's Register
Foundation

0091021-0091029-00914