


20.11.19.

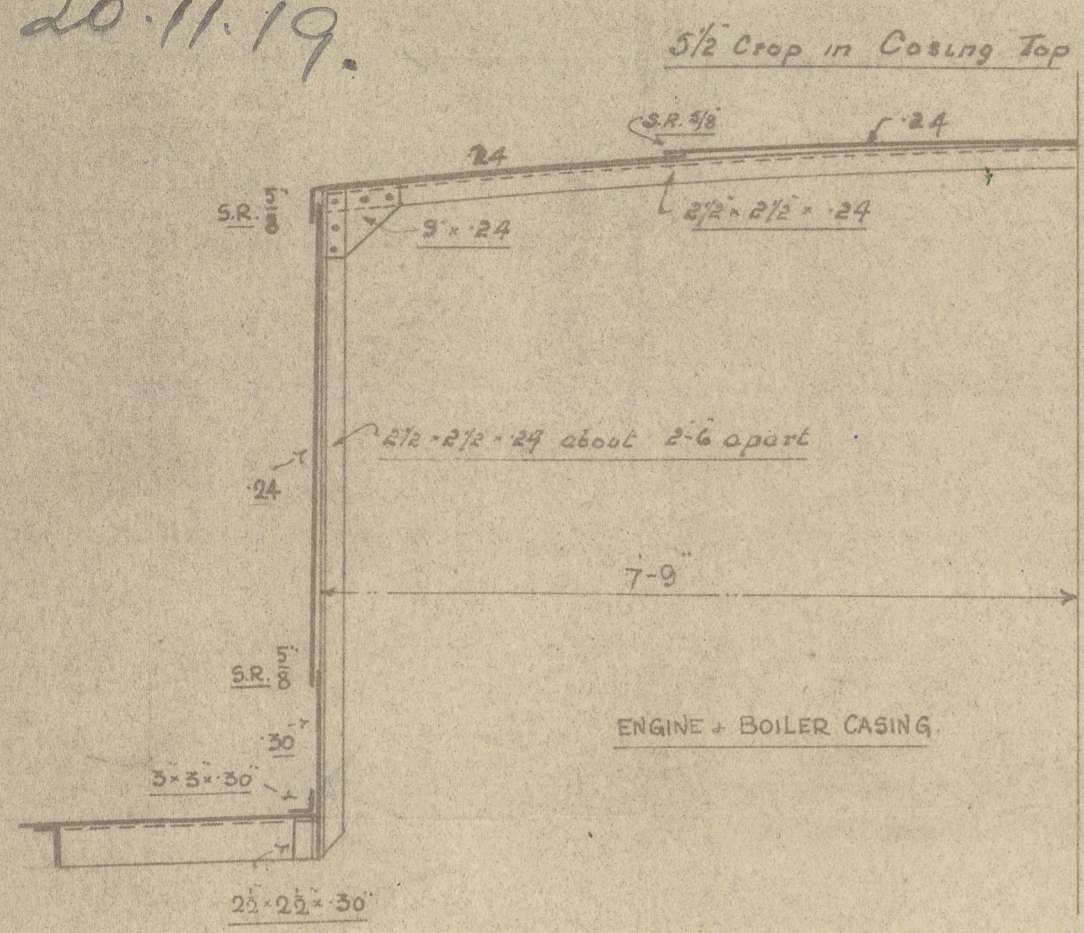

STEEL SCREW STEAMERS

N^{os} 304 & 311

SCALE 1/2" = 1 FOOT

DIMENSIONS

LENGTH B.P.	168'-0"
BREADTH MID.	26'-4 1/2"
DEPTH "	12'-7 1/2"
DEPTH (d) LLOYDS	10'-1 1/2"
DEPTH " " R.O.D.	14'-1 1/2"

EQUIPMENT

2 Stockless Anchors each	12'-2'-0"
1. " " "	10'-2'-0"
1 Stream " "	4'-0'-0" Ex. Stock.
1 Kedge " "	1'-3'-0" "
195 Fathoms 1 1/2" Stud Chain Cable	
60 " 1 1/2" Short Link Chain or 2 1/4" Steel Wire	
75 " 8" Hemp	or " " "
90 " 6" " "	" 2 1/4" " "

FORGINGS

PROPELLER POST	STEM - 6 1/2" x 18"
RUDDER	6 1/2" x 3 1/2"
RUDDER HEAD	4 1/2" DIA
RUDDER PINNLES	2 1/2"
RUDDER PLATE	82"

MAIN DECK



BREADTH	26'-3 3/4"
DEPTH	12'-6 1/2"
39 000 SMALL N ^o	
6552 00 LONGT. N ^o	
RD. QTR DECK	108'-8 1/2" x 4'
T.G. FORECASTLE	23'-29 1/2" x 7 1/2"
BRIDGE HOUSE	12'-8 1/2" x 8'-0" x 7 1/2"
CASING	46'-58" x 6'-5" x 5'
7347-16	EQUIPMENT N ^o

BEAMS

6-33	26'-3 3/4"
MAIN DECK DEPTHS	13'-31"
QTR.	10'-10"

QTR. DECK

26-375	
16-605	
43-000	
168	
7224-00	

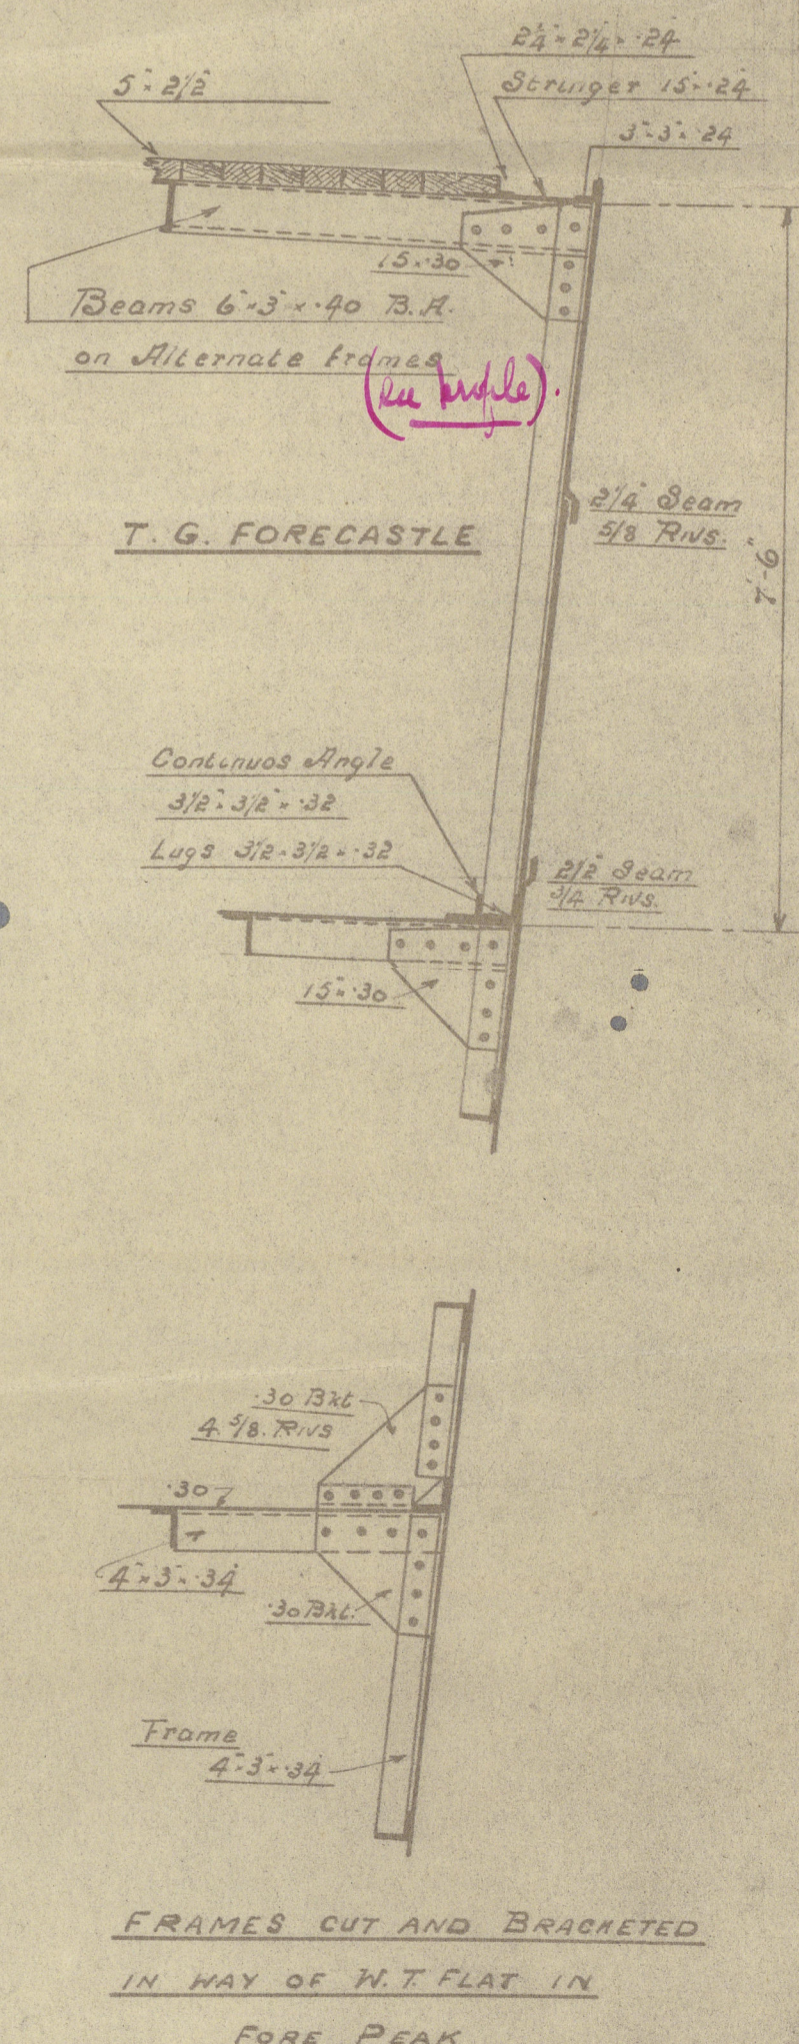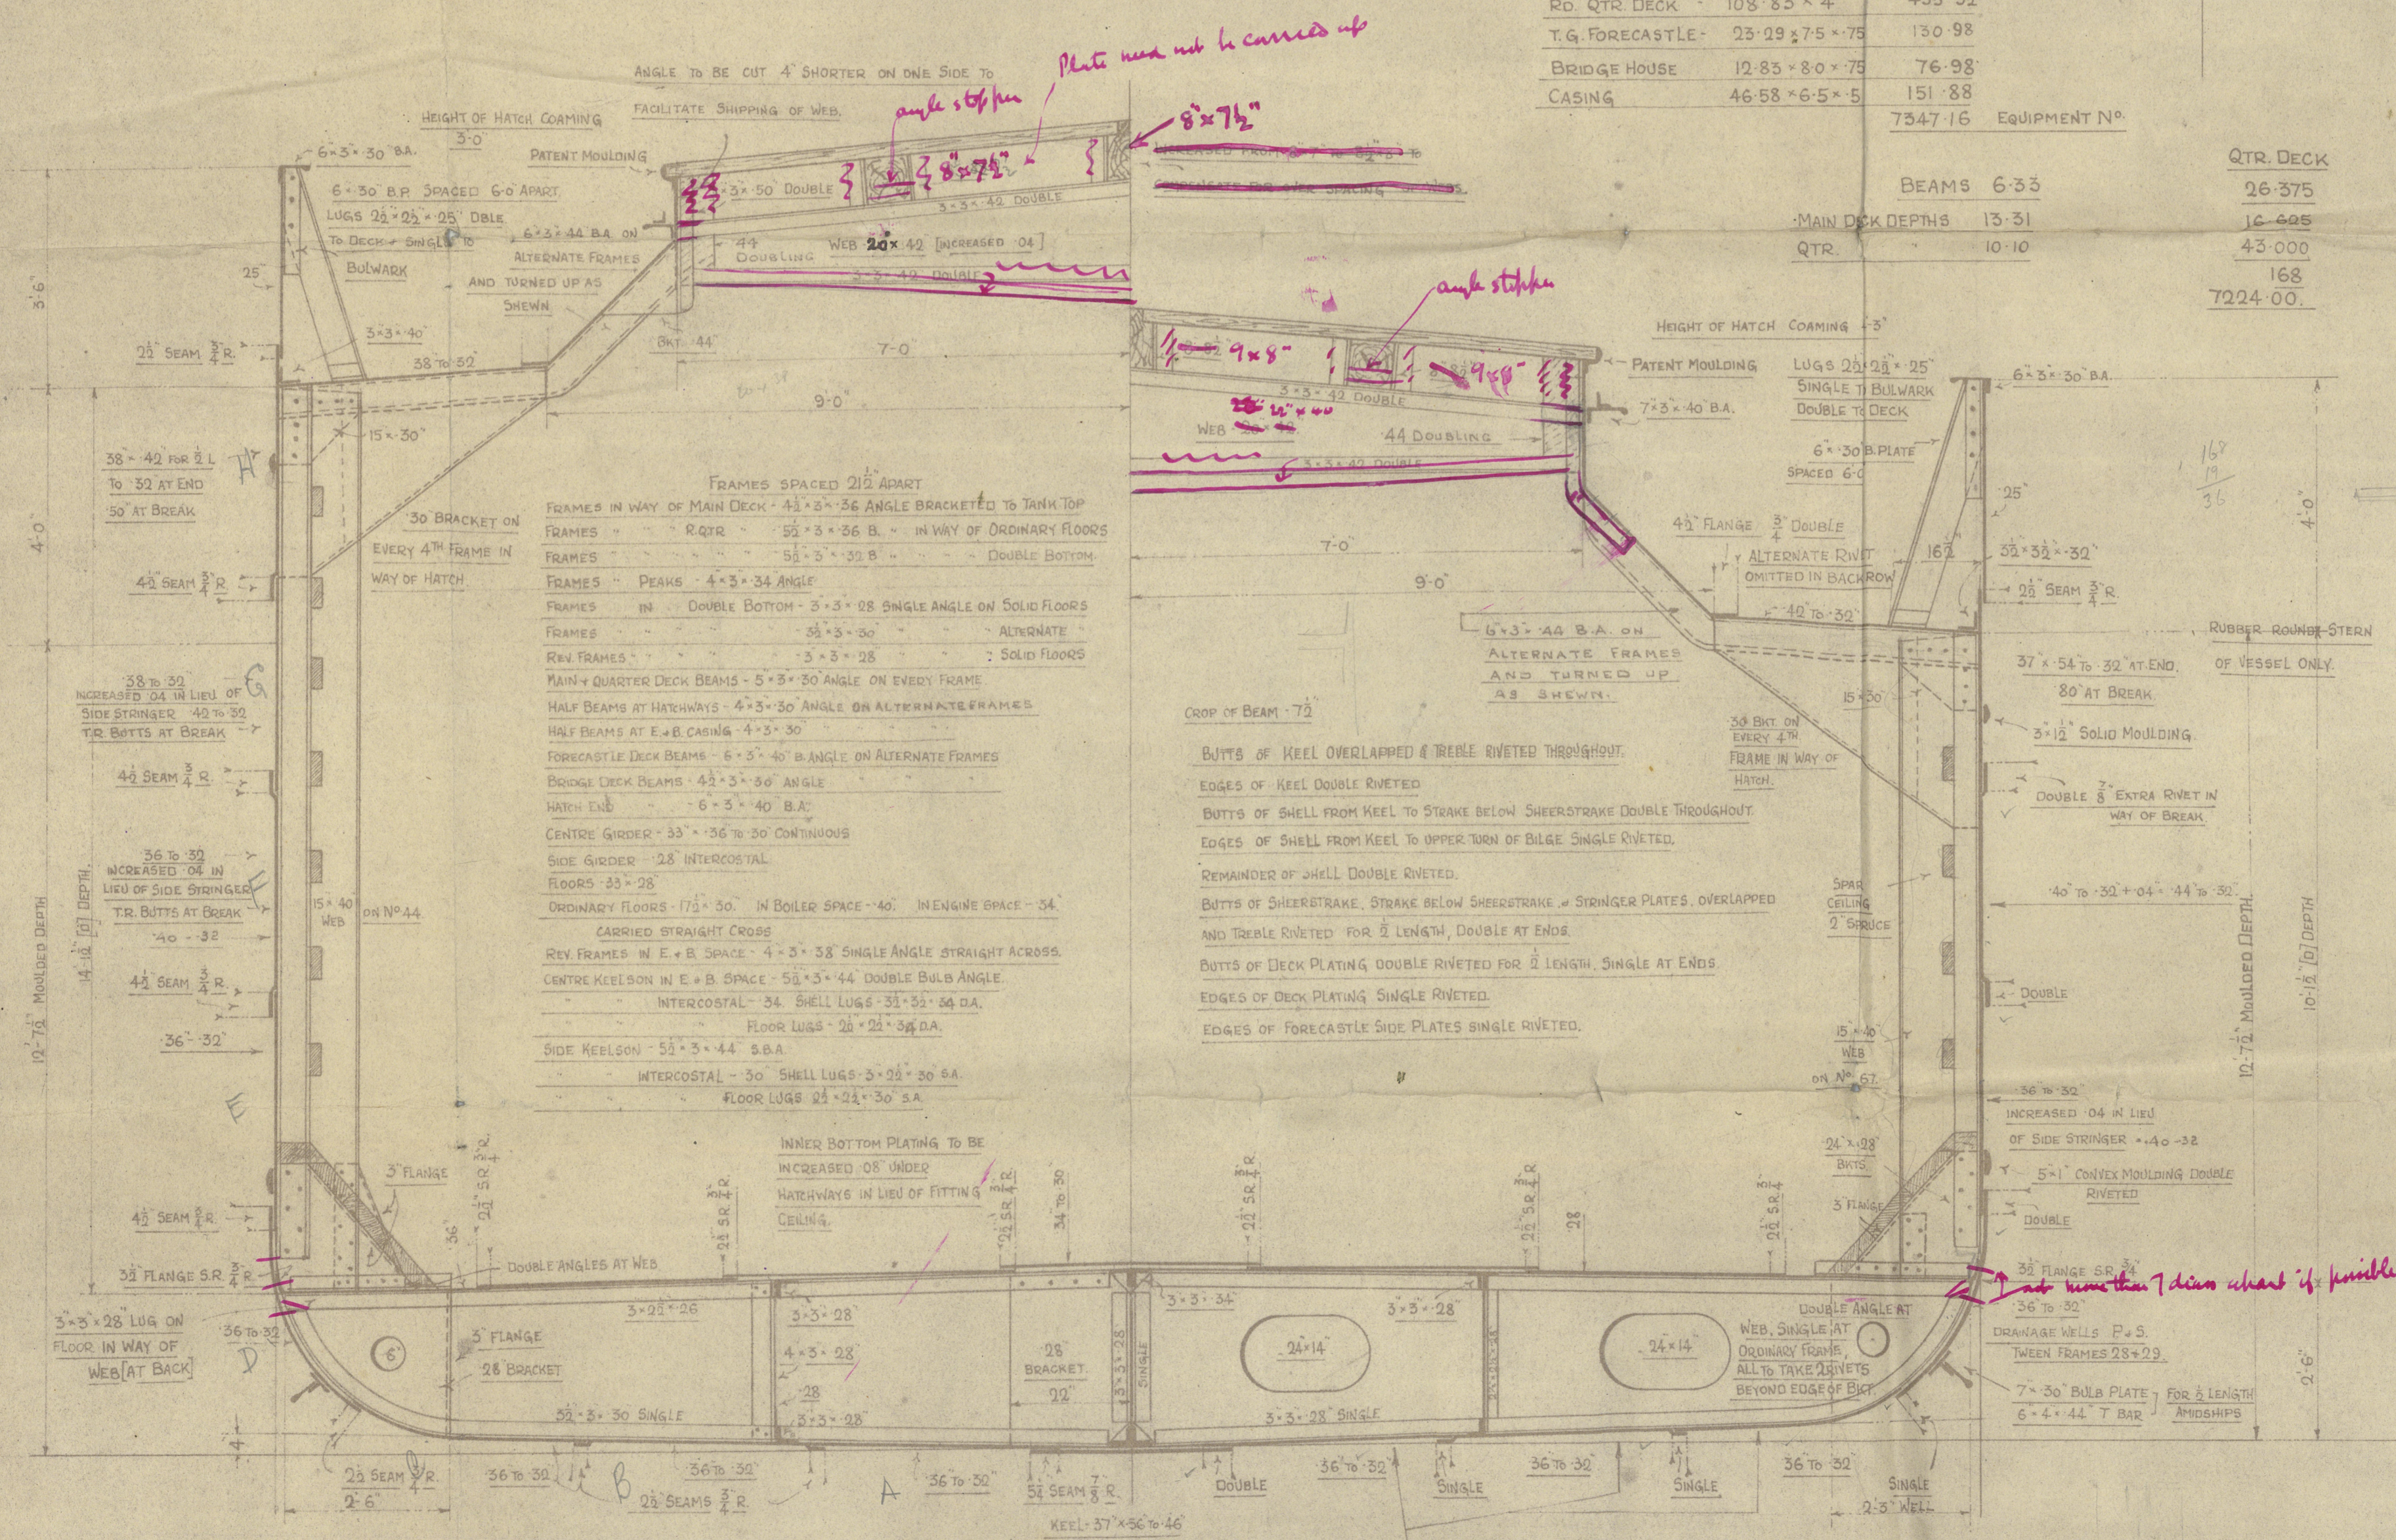

DRAWING N^o 126
THE ABOVE DRAWING NO MUST BE
QUOTED IN ALL CORRESPONDENCE IN
REFERENCE TO SAME.
JOHN CHAMBERS LTD.
SHIPBUILDERS AND ENGINEERS,
OULTON BROAD, LOWESTOFT.

17.4.1919.

504 + 511

Midships Section

CHAMBERS

504 + 511

MIDSHIP SECTION

"Salcombe Regis"
n. n. "Rio Verde"

~~Lon. Apt. No. 84546~~



© 2021

Lloyd's Register
Foundation