
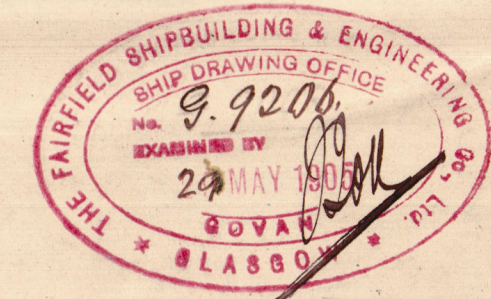
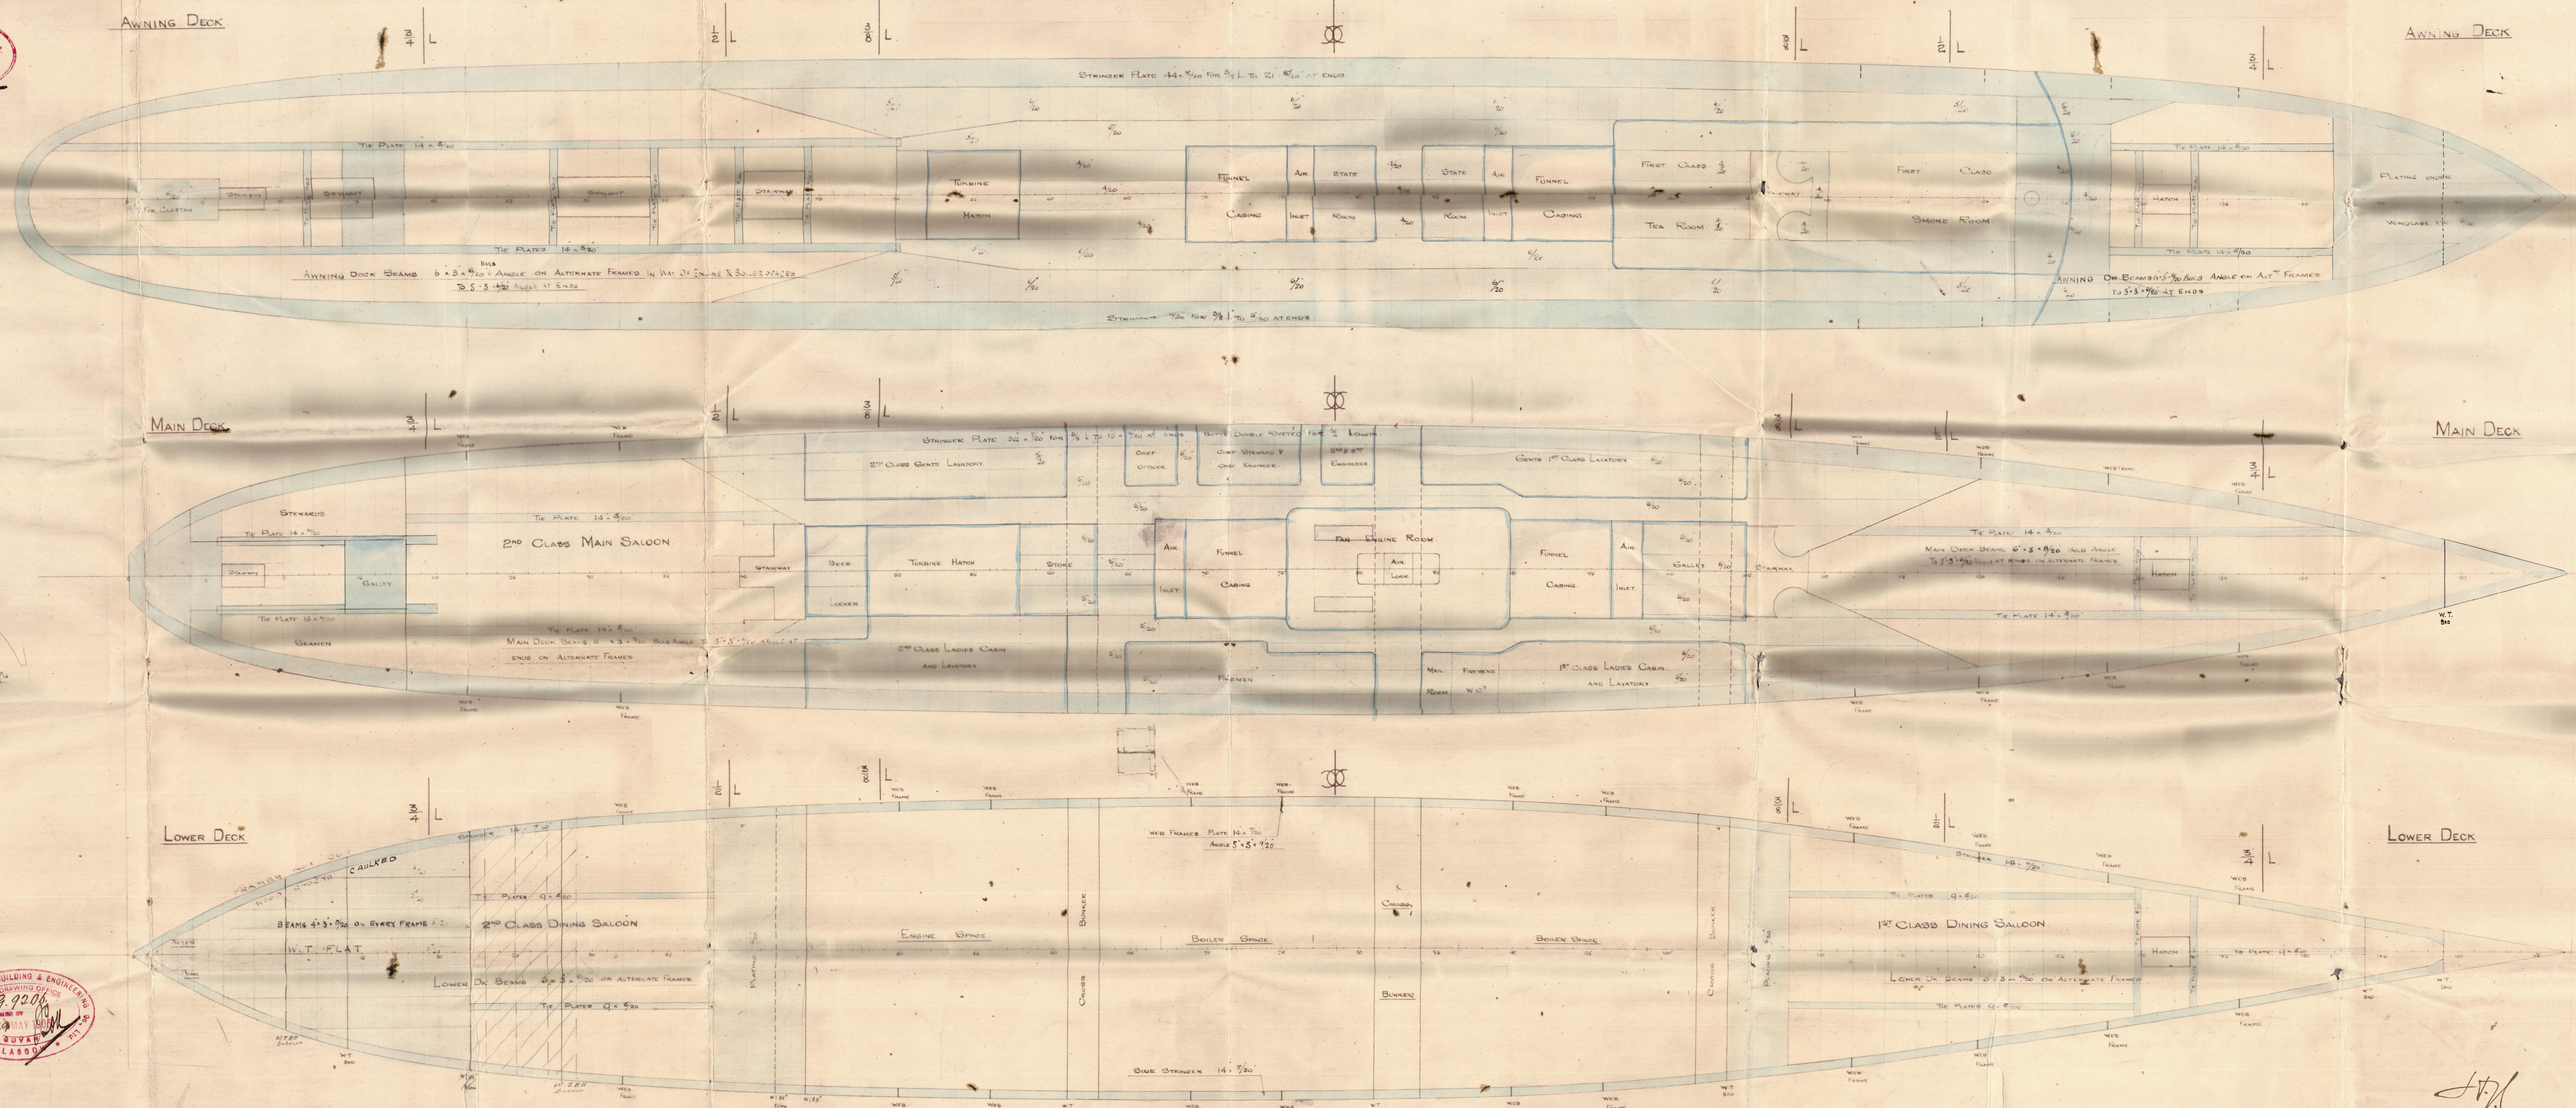


DECK PLANS

PRINCIPAL DIMENSIONS 315'0" x 39'6" x 16'6"

CLASS A.1. LLOYD'S FOR CHANNEL PURPOSES

SCALE 1/8" = ONE FOOT

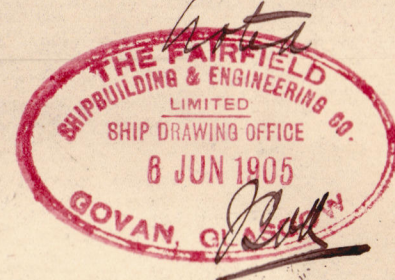

Handwritten signature and date: J.V.K. 7/6/05

Gl. M. M. No. 24008

VIPE R.









3.

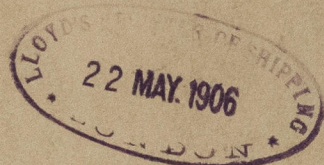

© 2021

Lloyd's Register

Foundation

009083-009093-0120