
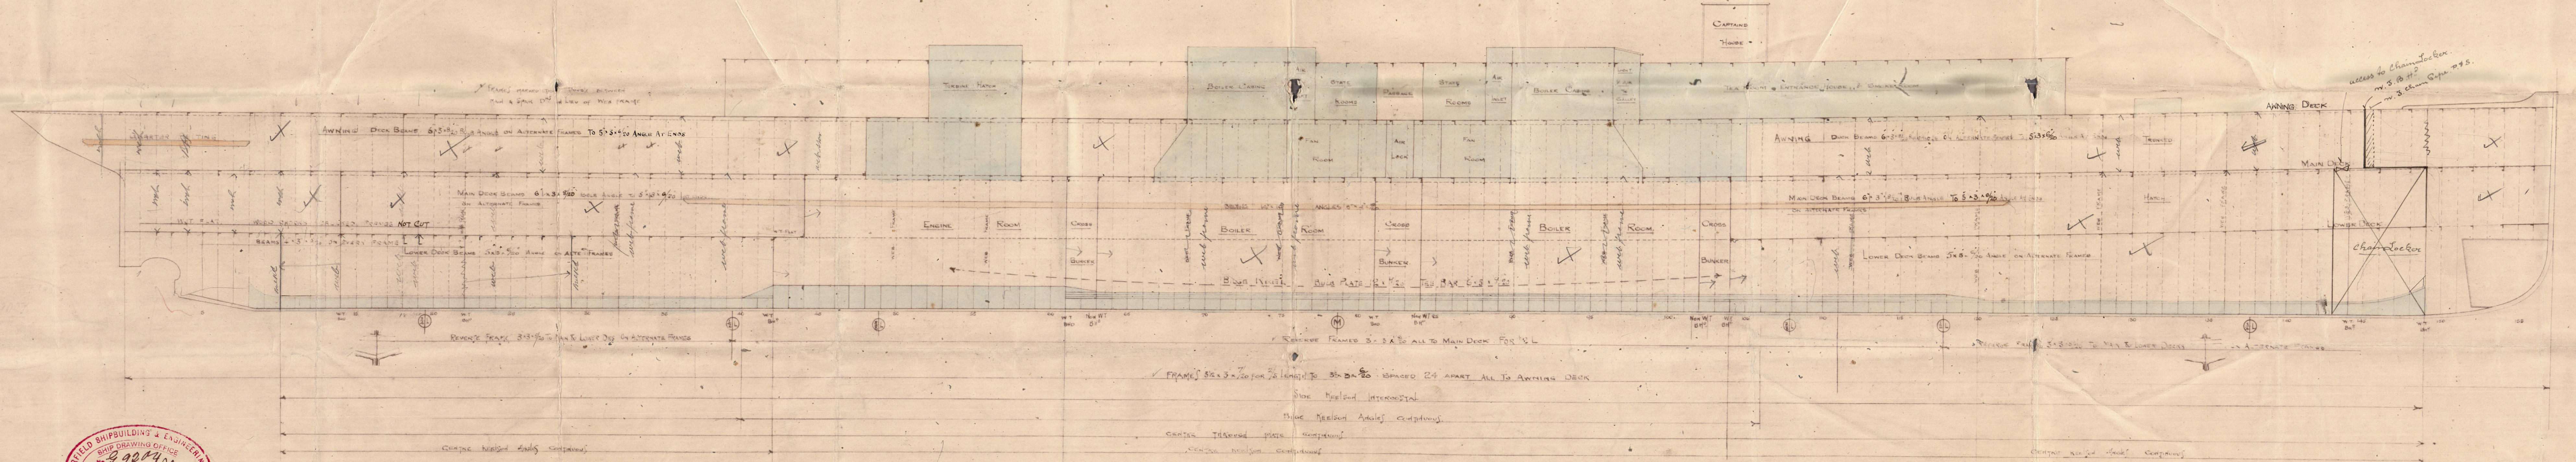


2.6.05

— PROFILE —

PRINCIPAL DIMENSIONS 315'0" x 39'6" x 16'6"
CLASS A.I. LLOYDS FOR CHANNEL PURPOSES

— SCALE 1/8" = ONE FOOT —

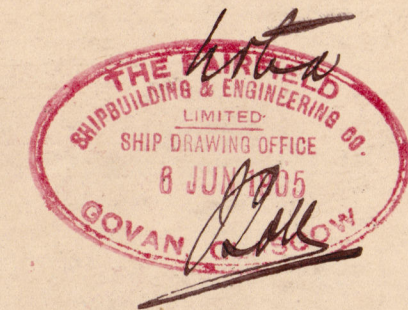

J.H.L.
2/6/05

The Fairfield S. B. & Co.


Turbine Steamer

No 444


Amended Profile

"VIPER"

Glo. nft. No. 24008

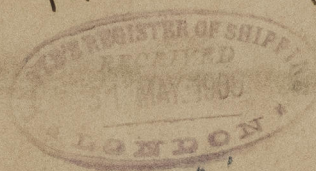

nn "Snafell" 2.

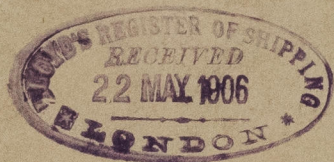

009083-009093-0122



© 2021

Lloyd's Register
Foundation

123

009083-009093-0122



© 2021

Lloyd's Register
Foundation