

578/24

# MIDSHIP SECTION

DOUBLE ENDED FERRY STEAMER No 398

LENGTH B.P. 187'-0" BREADTH 35'-6" DEPTH 14'-0" MLD.

TO CLASS LLOYDS 100A-FOR FERRY SERVICE IN SYDNEY HARBOUR N.S.W.

SCALE 1/2" = ONE FT.



## NUMERALS

L x D = 187' x 14' = 2618  
 L x (B+D) = 187' x 49.5' = 9256.5  
 PROPORTIONS L/D = 13.35  
 d = 12.37

## EQUIPMENT.

1- 3 CWT ANCHOR EX STOCK.  
 60 FATHOMS 5/8" CRANE CHAIN  
 60 " 5" MANILA TOW ROPE.

RIGGING	
BUTTSTRAPS OF SHEERSIKE	T.R. 3/8" D.R. ENDS.
" OF STRIKE LOW	T.R. 3/8" D.R. ENDS.
BUTTSTRAPS OF STRING PLATE	T.R. 3/8" D.R. ENDS.
BUTTSTRAPS OF BOSS PIES	T.R.
BUTTSTRAPS OF "A" STAKE	T.R. 3/8" D.R. ENDS.
" OF OUTSIDE PLATING	T.R. 3/8" D.R. ENDS.
BUTTS OF DECK PLATING	D.R. 1/2" SR ENDS
EDGES OF DECK PLATING	S.R.

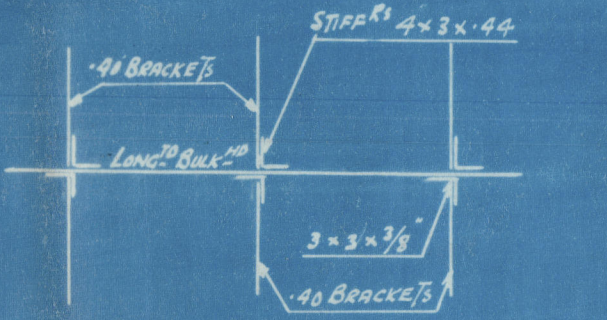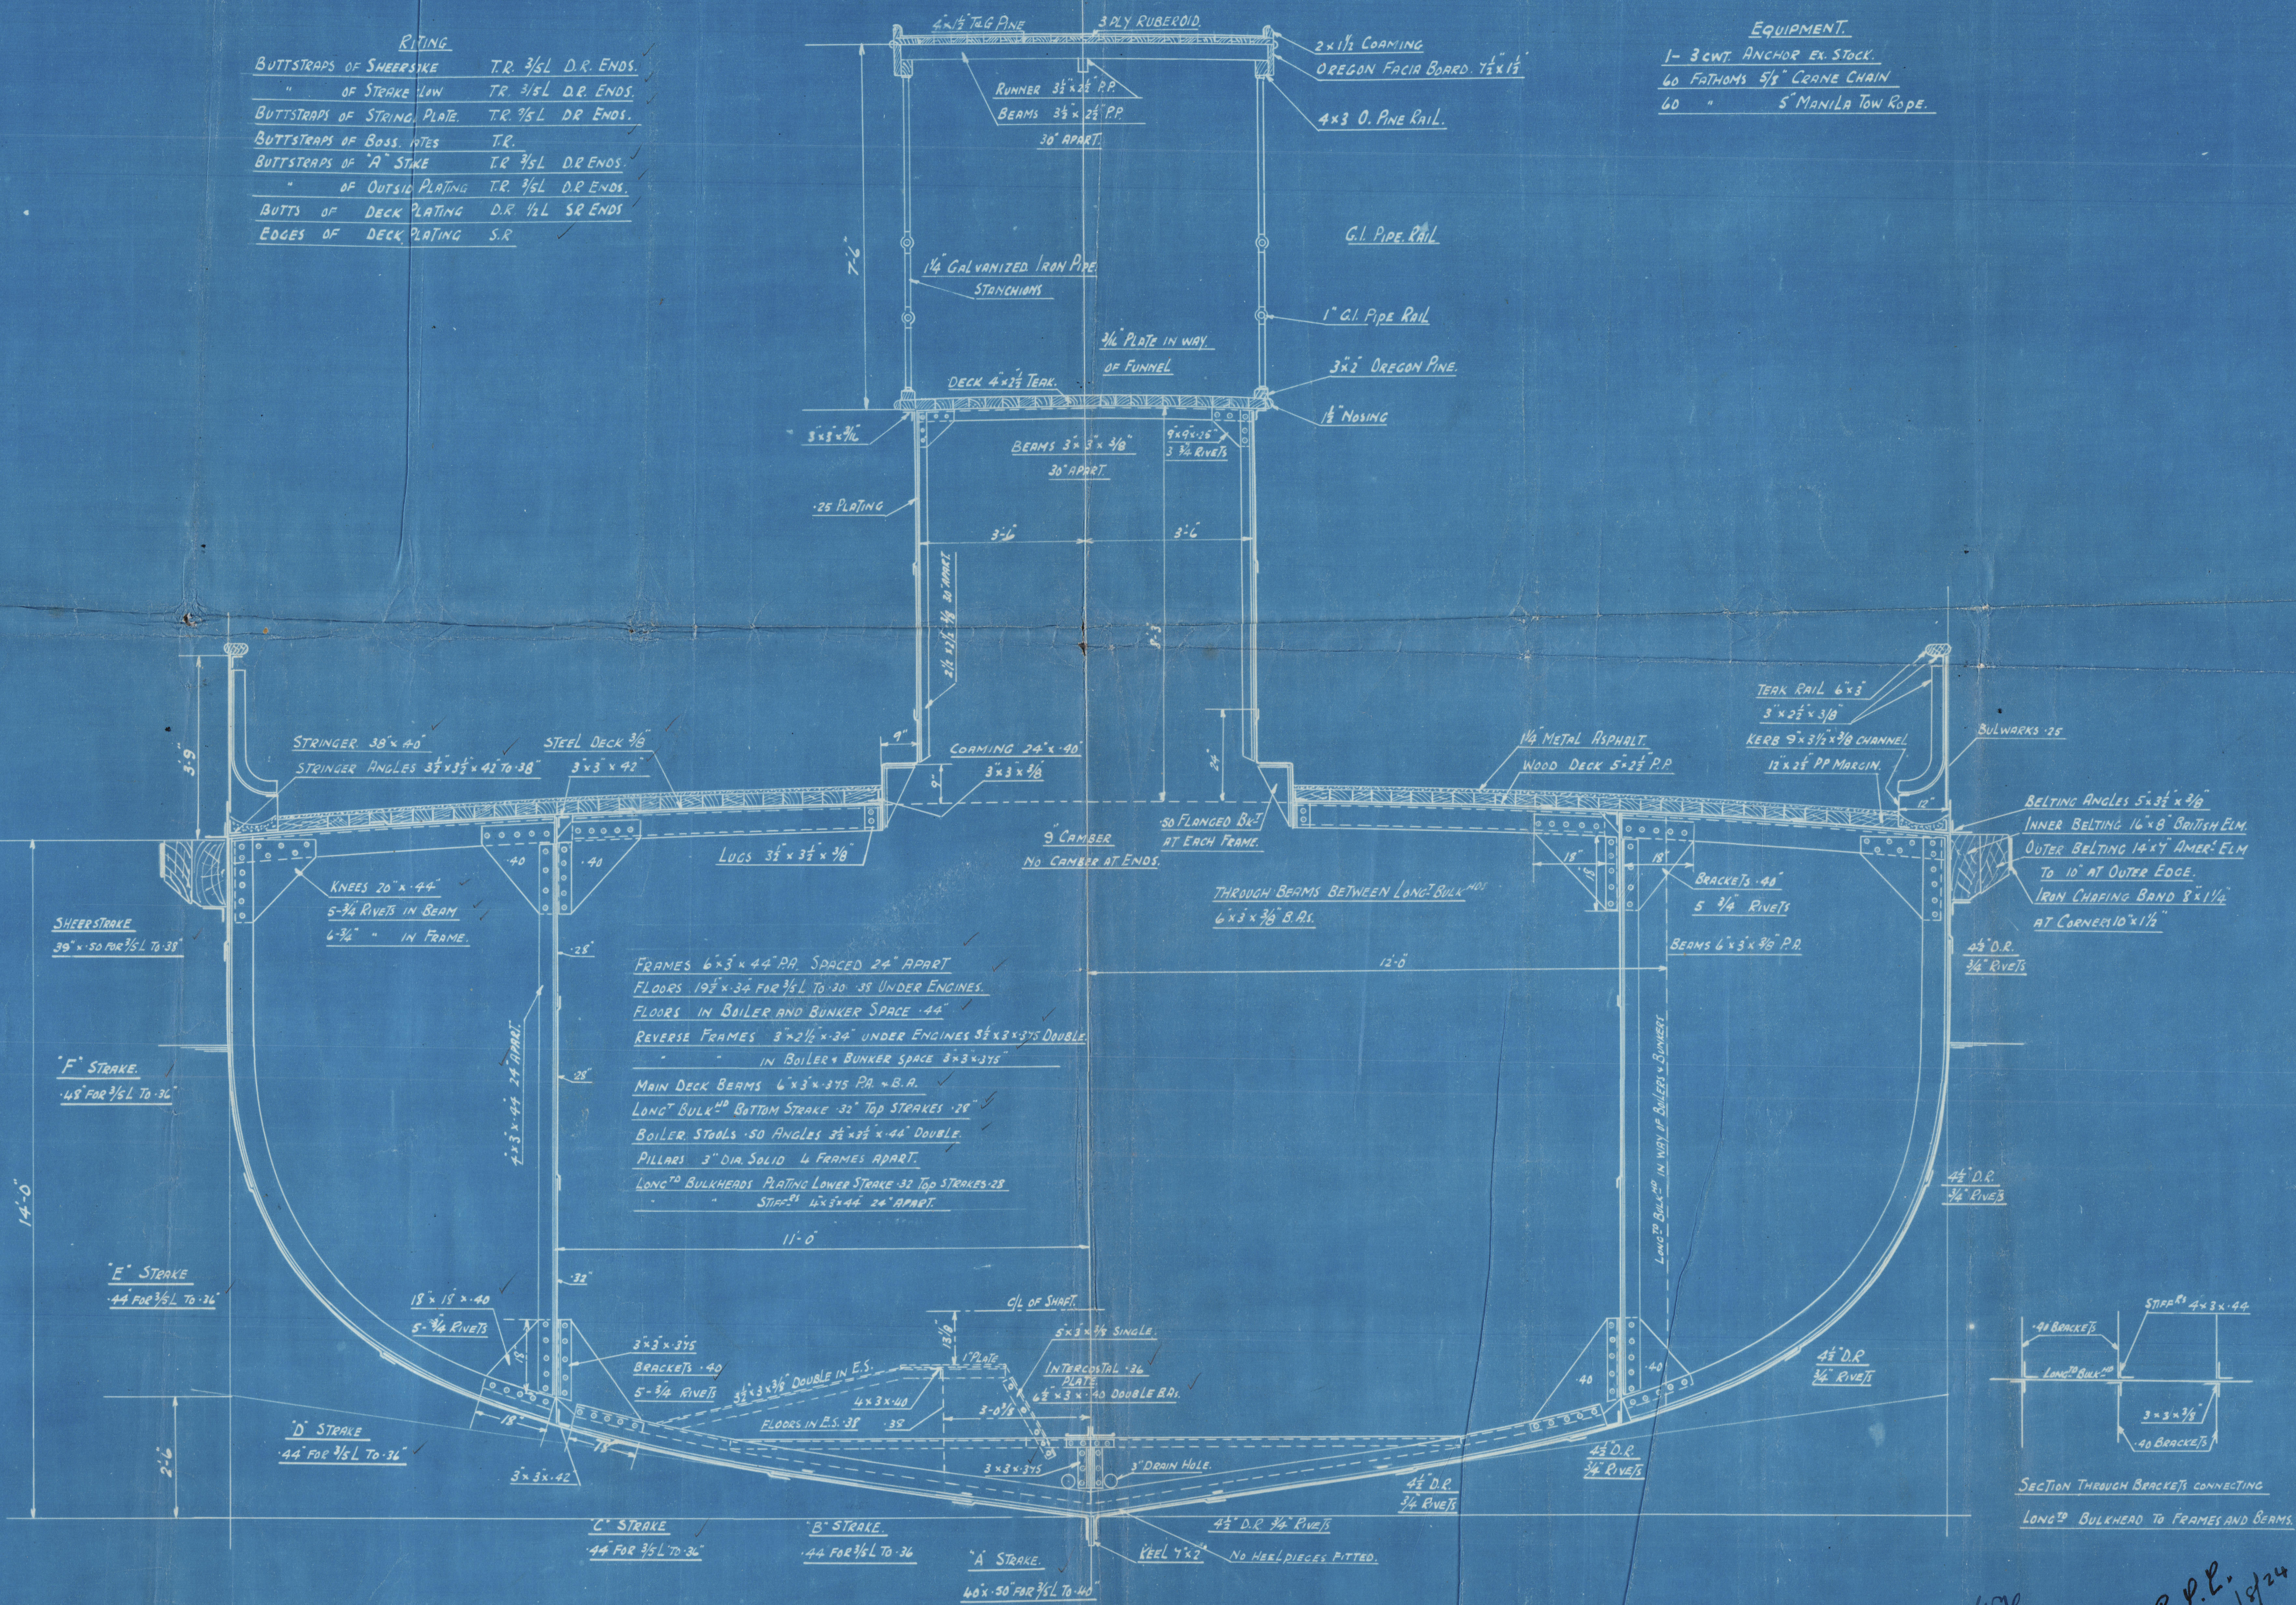

SECTION THROUGH BRACKETS CONNECTING LONG BULKHEAD TO FRAMES AND BEAMS.



Master Letter

Double Ended Towing Steamer

N 398


C. S. "Lurgurena"

LIVERPOOL

Report No. 88601.



© 2021

Lloyd's Register  
Foundation

009301 - 009310 - 0136