



N^o 725 P *N. 815^o 866P*
PROFILE SECTION SHEWING 2ND GIRDER
WITH SUPERSTRUCTURE & MAIN DECK PLAN
SCALE 1" = 1 FOOT

BULKHEADS SHOWN IN BLUE FOR N^o 815^o

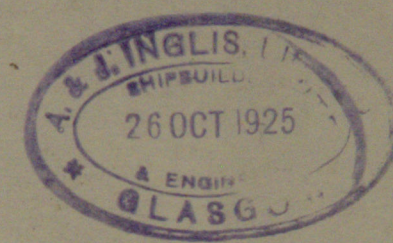

Bulkheads in blue N. 815^o vessel and 866
Correct position of bulkheads in N. 815^o
shown in pumping plan profile

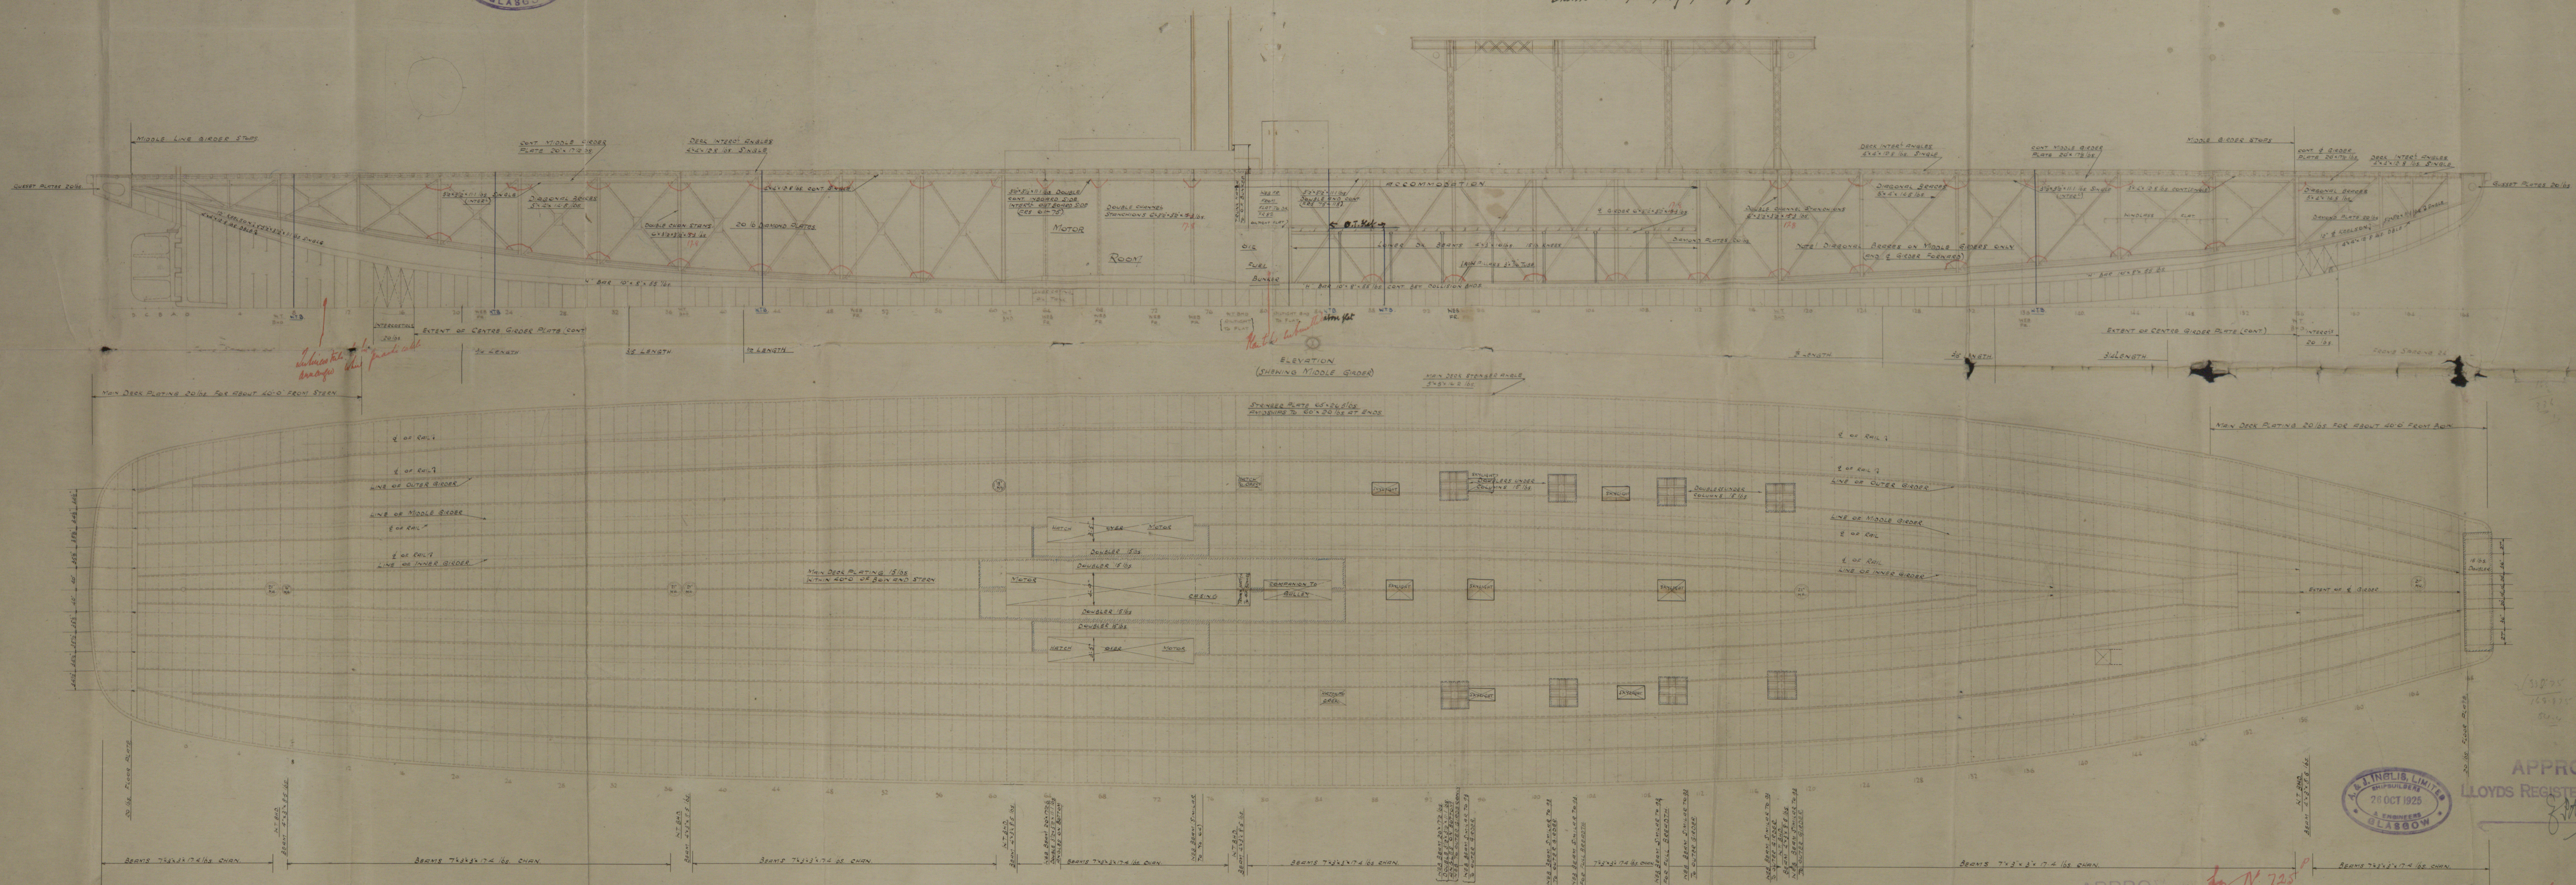

APPROVED for 866P
LLOYDS REGISTER OF SHIPPING
DATE 11.12.28

APPROVED for N^o 725 P
LLOYDS REGISTER OF SHIPPING
DATE 11.12.28

APPROVED for N^o 815^o
LLOYDS REGISTER OF SHIPPING
DATE 11.12.28

Probite & Ok

N. 725 P. *W 815^P*

Inglis Ltd *866P*

D. B. 82 TOP

Dolores de Arquiza *

GLASGOW REPORT No 46022

Freeboard

GLASGOW REPORT No 47769

M. O. Delfina Nitro

GLASGOW REPORT No

48080

Fbd

GLASGOW REPORT No 49806

8106

"Carmen Avellaneda"

GLASGOW REPORT No 49946

009301 - 009310 - 0159

Lloyd's Register
Foundation

425



© 2021

Lloyd's Register

009301-009310-0159
Foundation