


STEM STERN FRAME & RUDDER FOR NO. [REDACTED]

SCALE $\frac{3}{4}$ " TO 1 FOOT.

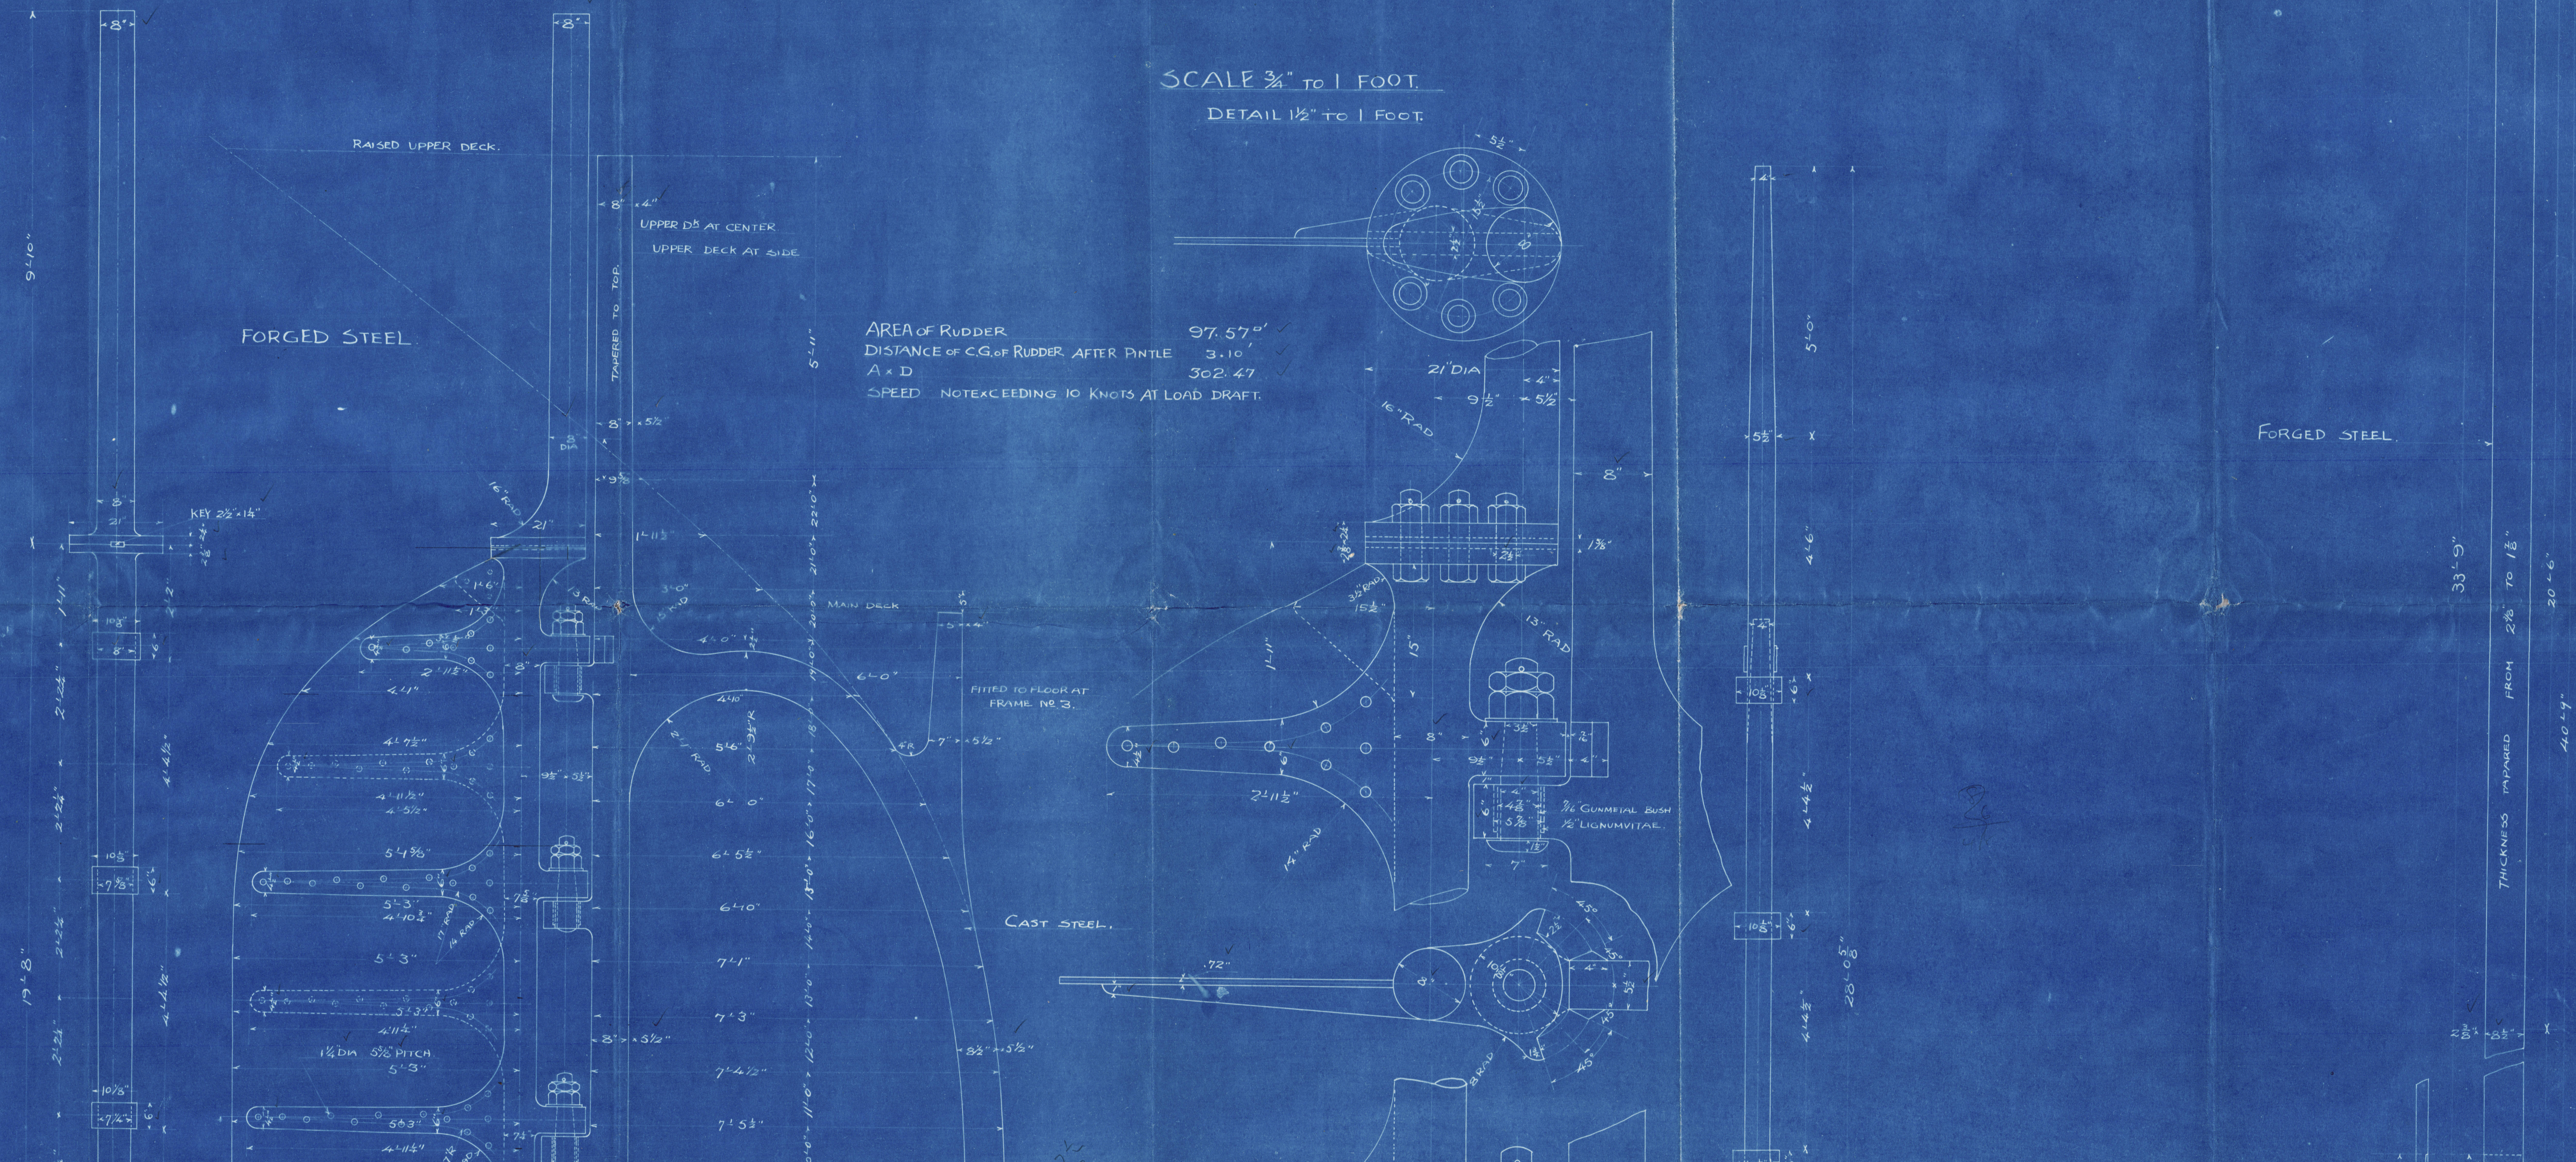

31. stem, stem frame & Rudder

^uForgings

N^o 31


^uFujinagata ^uKosensho

Kobe

Gen. Box. 2568.



London Office

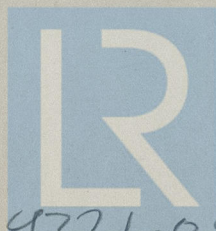

© 2021

Lloyd's Register
Foundation

004321-00 1330-0206