

STEEL SCREW CARGO STEAMER

CLASSED * 100 A 1 LLOYD'S REGISTER.

PROFILE AND DECKPLAN.


SCALE 1 : 50.

TYPE : RAISED QUARTERDECK.

S.S. No 565 x 566.

f. Wad. C. Boole & Sonen
Stichtkruis

ADDITIONAL FILLS UNDER SPERM WIND
TO SURVEYORS SATISFACTION.

 

C. Boeles & Zonen

565 9 566.


Profile & Deck plan.

Box 2921

S. Georgia

Rott 11495

Boeles & Zonen

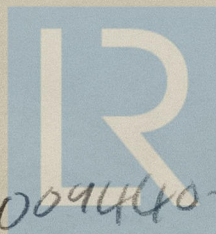

© 2021

Lloyd's Register
Foundation

009440-009450-0111