Do. between 2
and 3rd d
Total unde

009451-009458-0195 1/2

BEAM

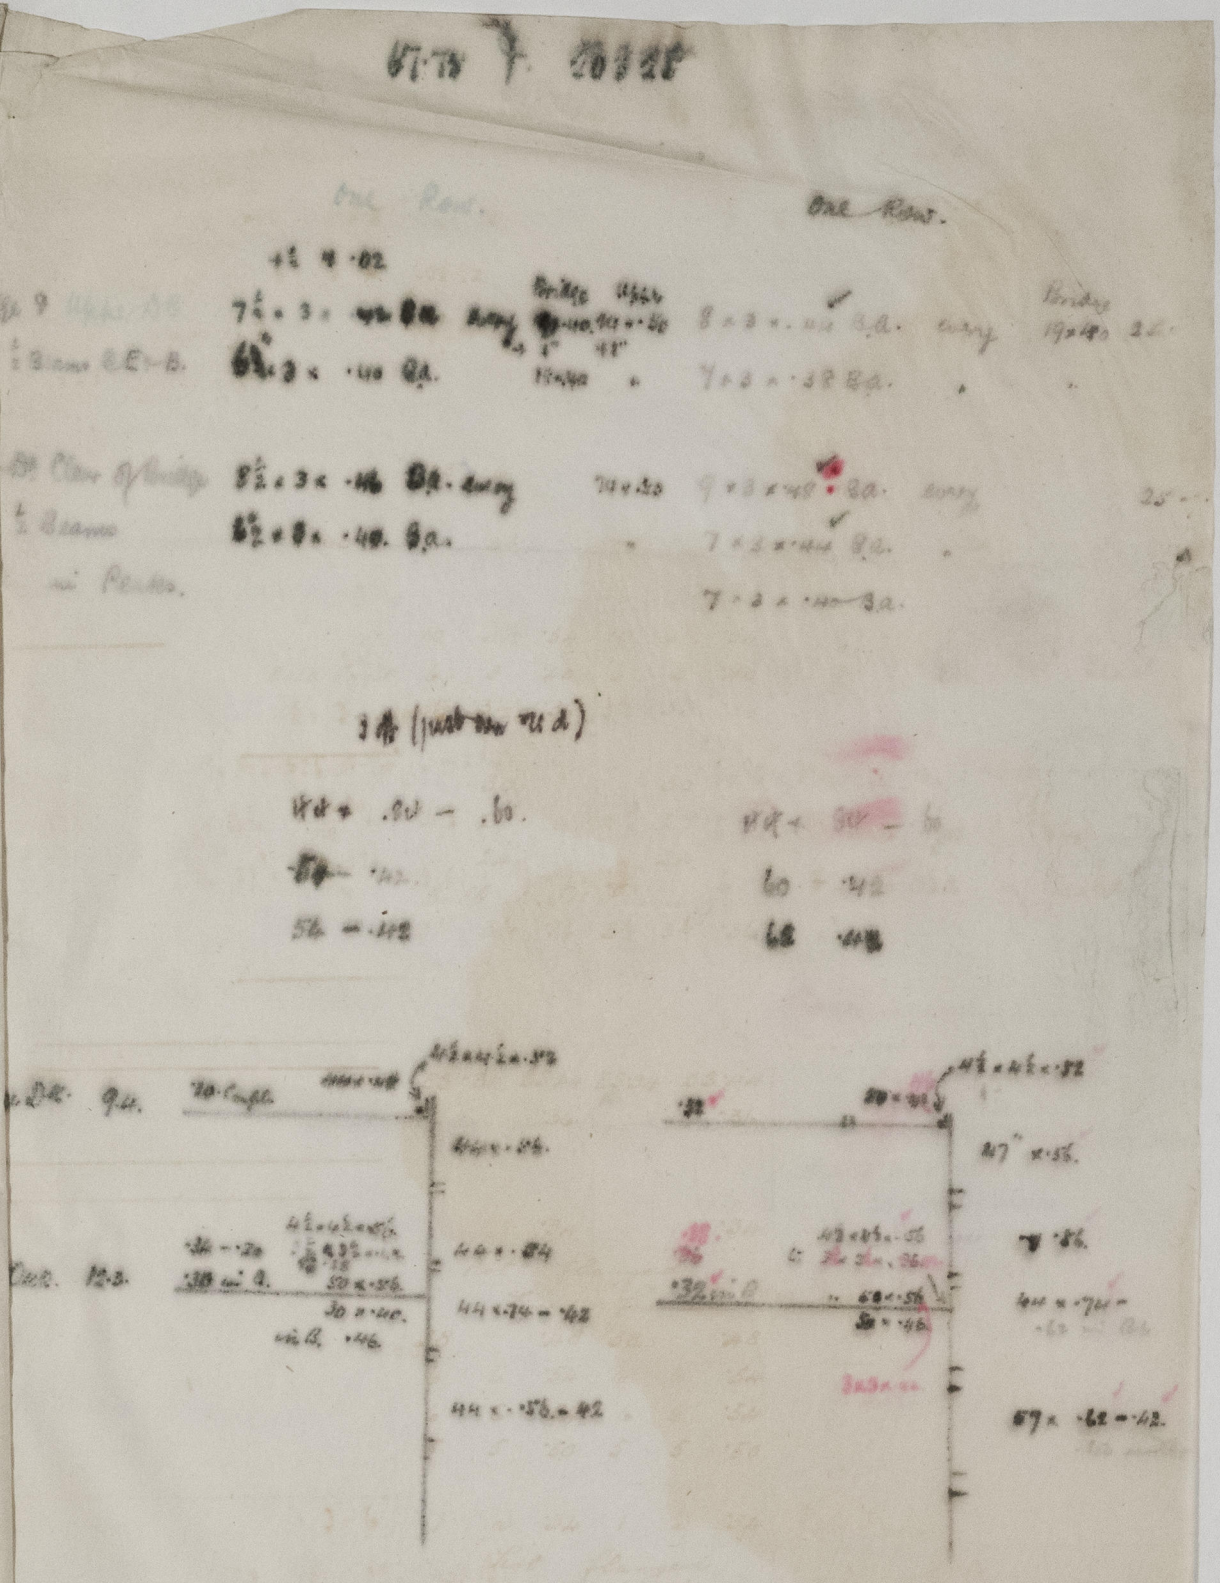

to be submitted

© 2020
Lloyd's Register Foundation