

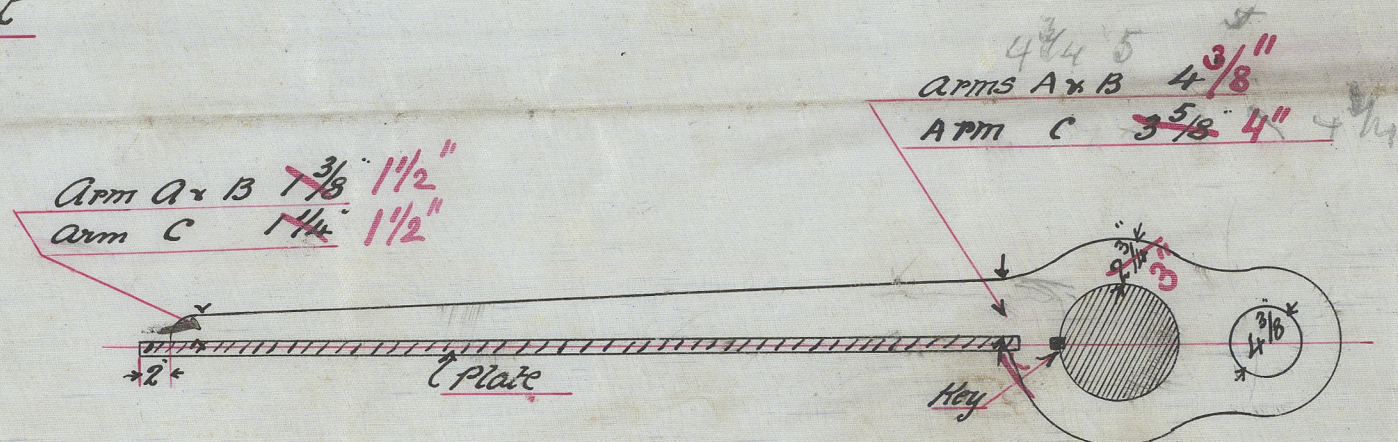



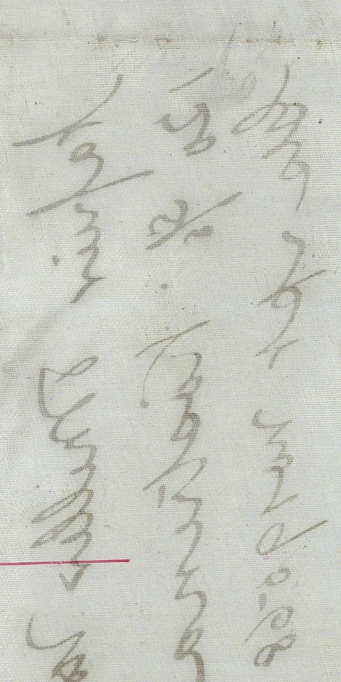

17/8/07
J.V.L.
7/8/07
To pass Lloyd's Tests
Pittles increased $\frac{1}{4}$ dia. in line
of wide spacing.

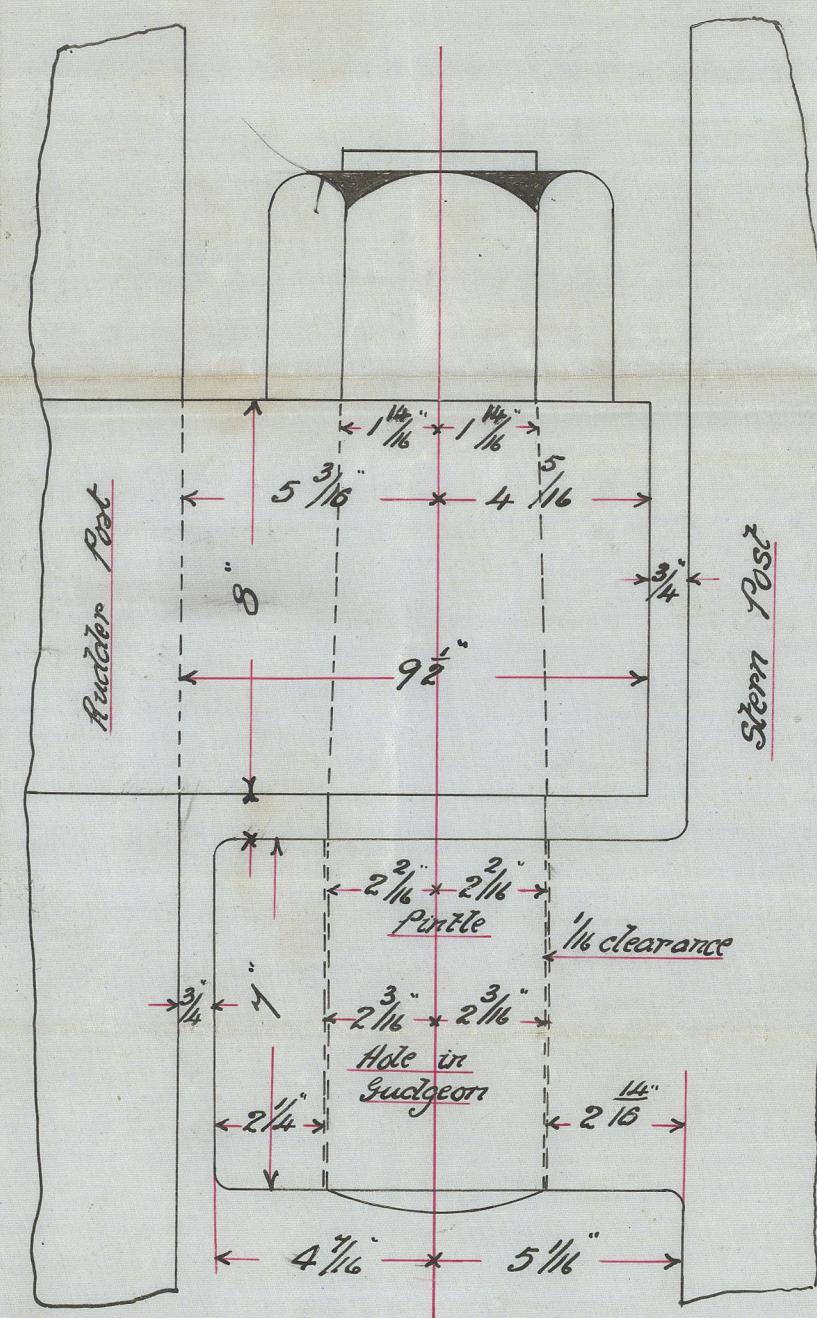

Single Plate Rudder
S. S. No 120
Scale $\frac{1}{2}'' = 1 \text{ Foot}$

IRON FORGING


To pass Lloyd's Test

Quills increased $\frac{1}{4}$ dist. in line
of wide spacing.

Rudder Plan
Kaiser & Miller
No 120 & "

"Tuzla."

gls 19568


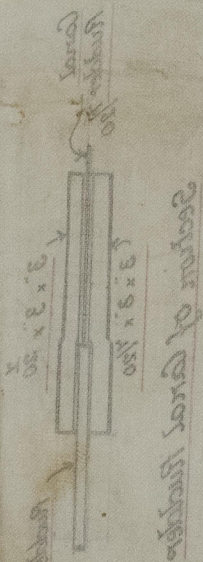


© 2020

Lloyd's Register
Foundation

009493-009504-0128

Kapier & Muller 20
 120 5/8 Kistrena
 Ges. v. 19568

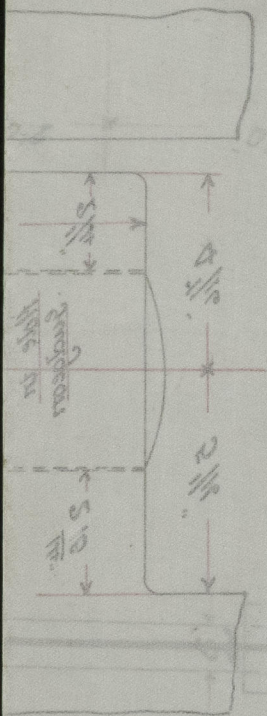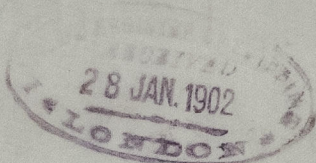

Back of Rudder






© 2020

Lloyd's Register
 Foundation

009493-009504-0128