


as fitted

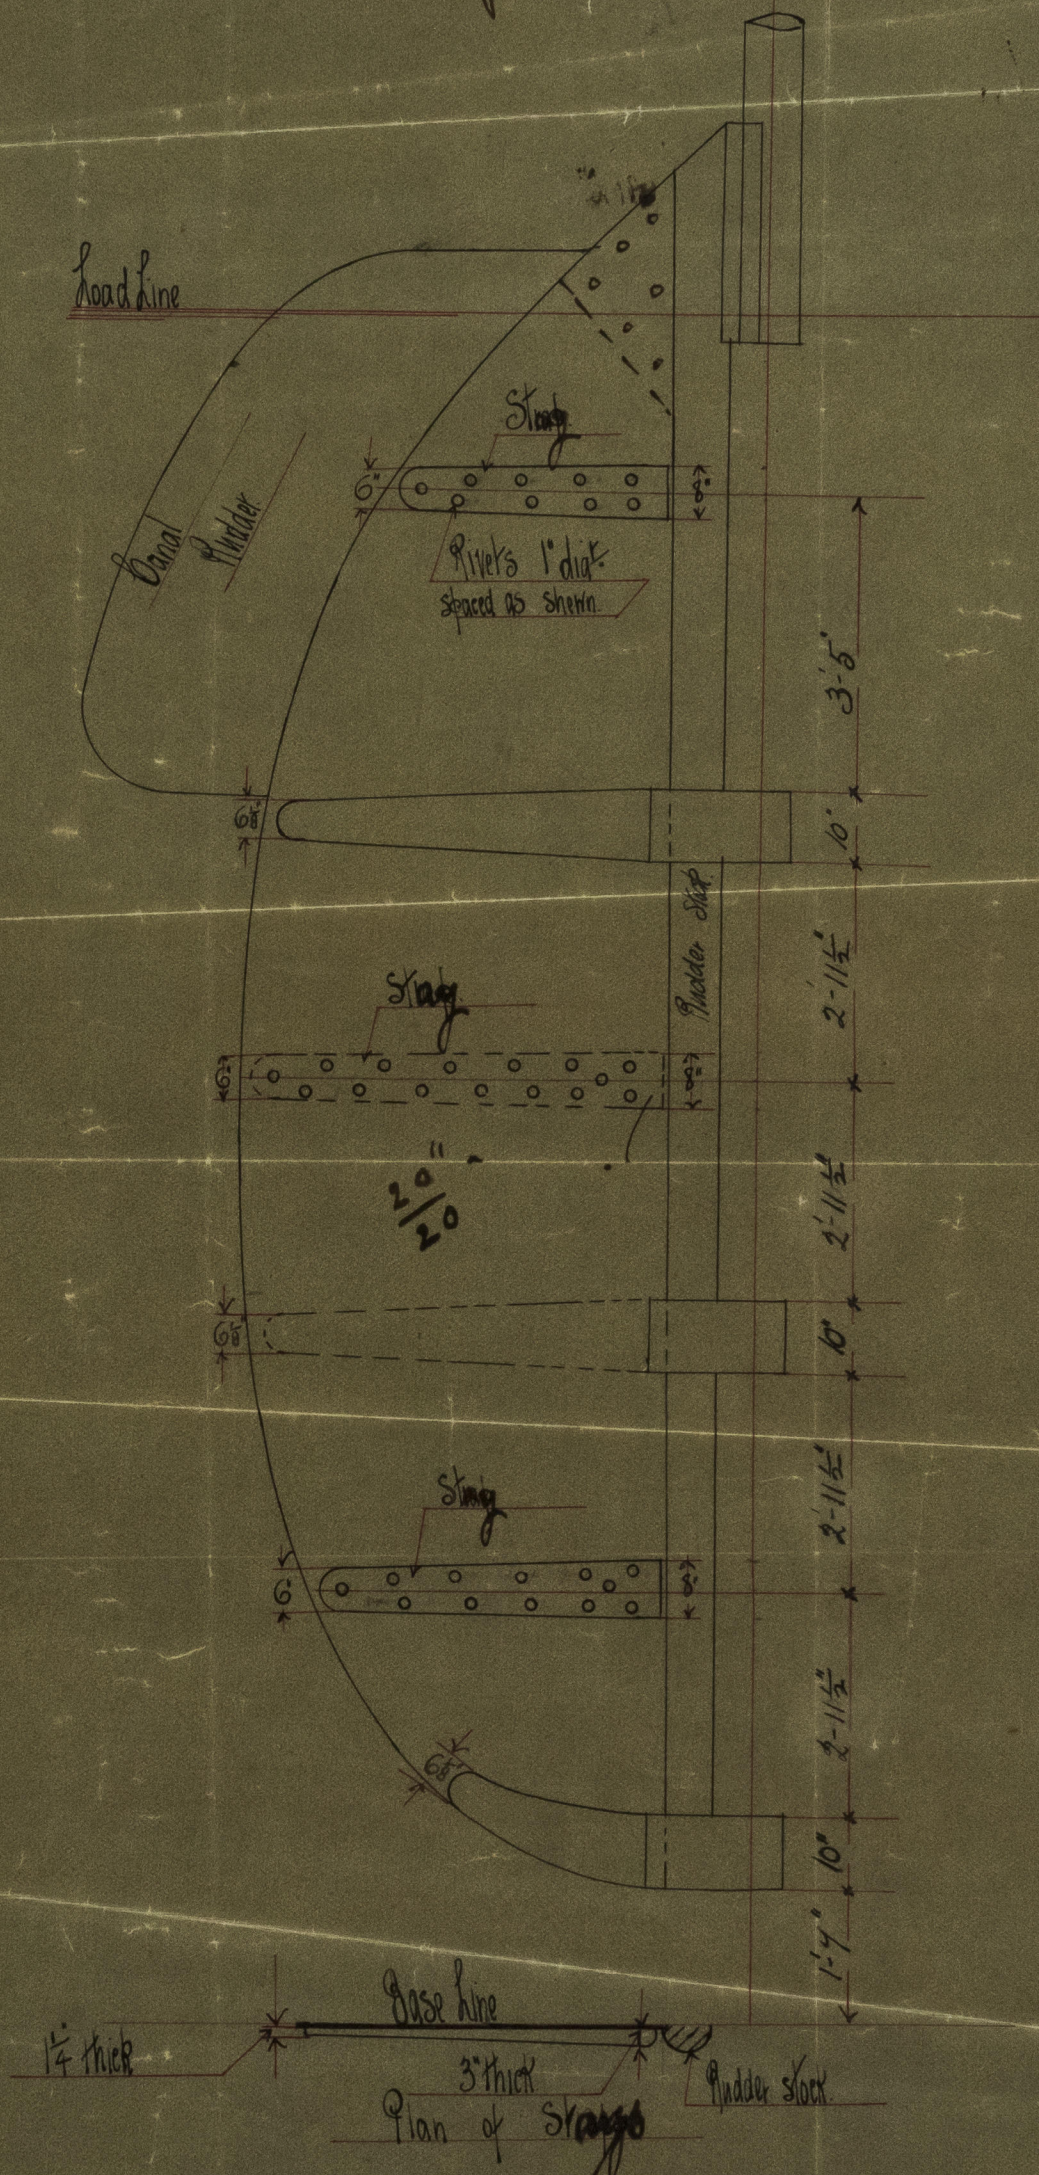

Sketch of Rudder showing position of Struts.

No. 120 S.S.

Scale 1/2" per foot.

J.P.



© 2020

Lloyd's Register Foundation