



PLAN AT "C" DECK.

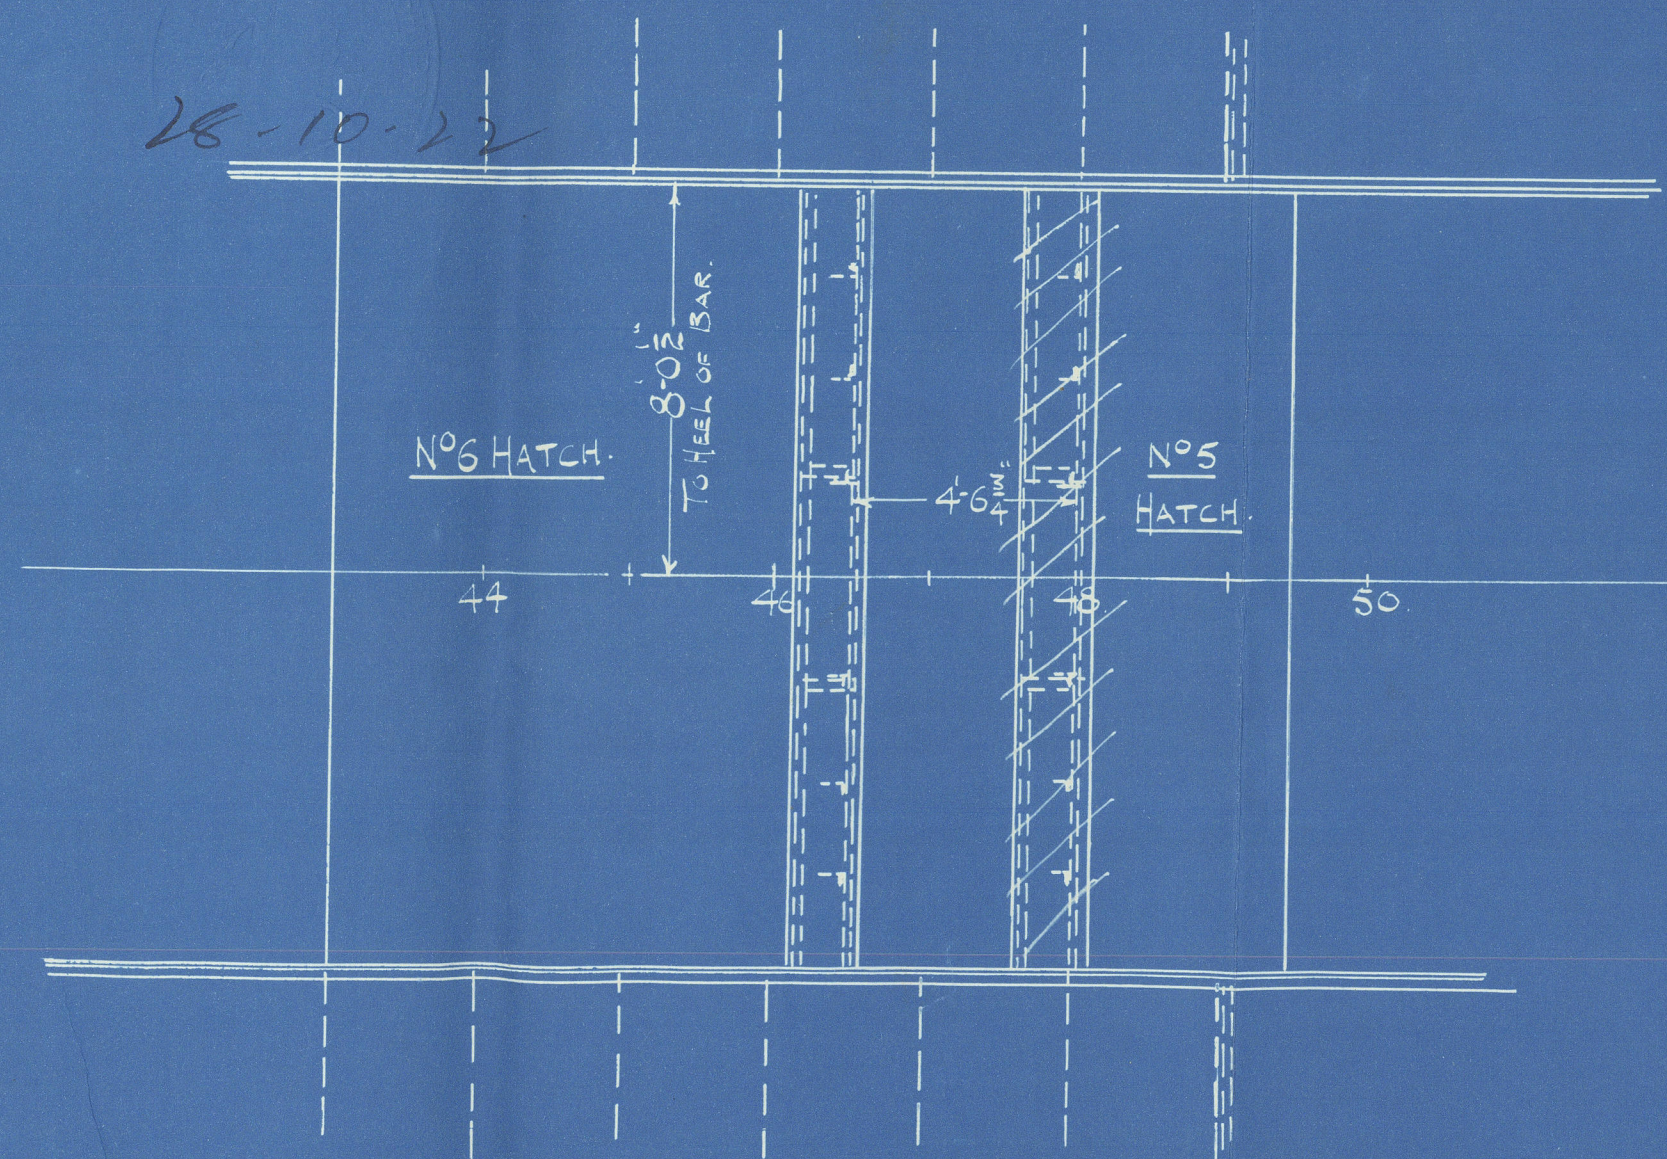

PLAN AT "E" DECK.

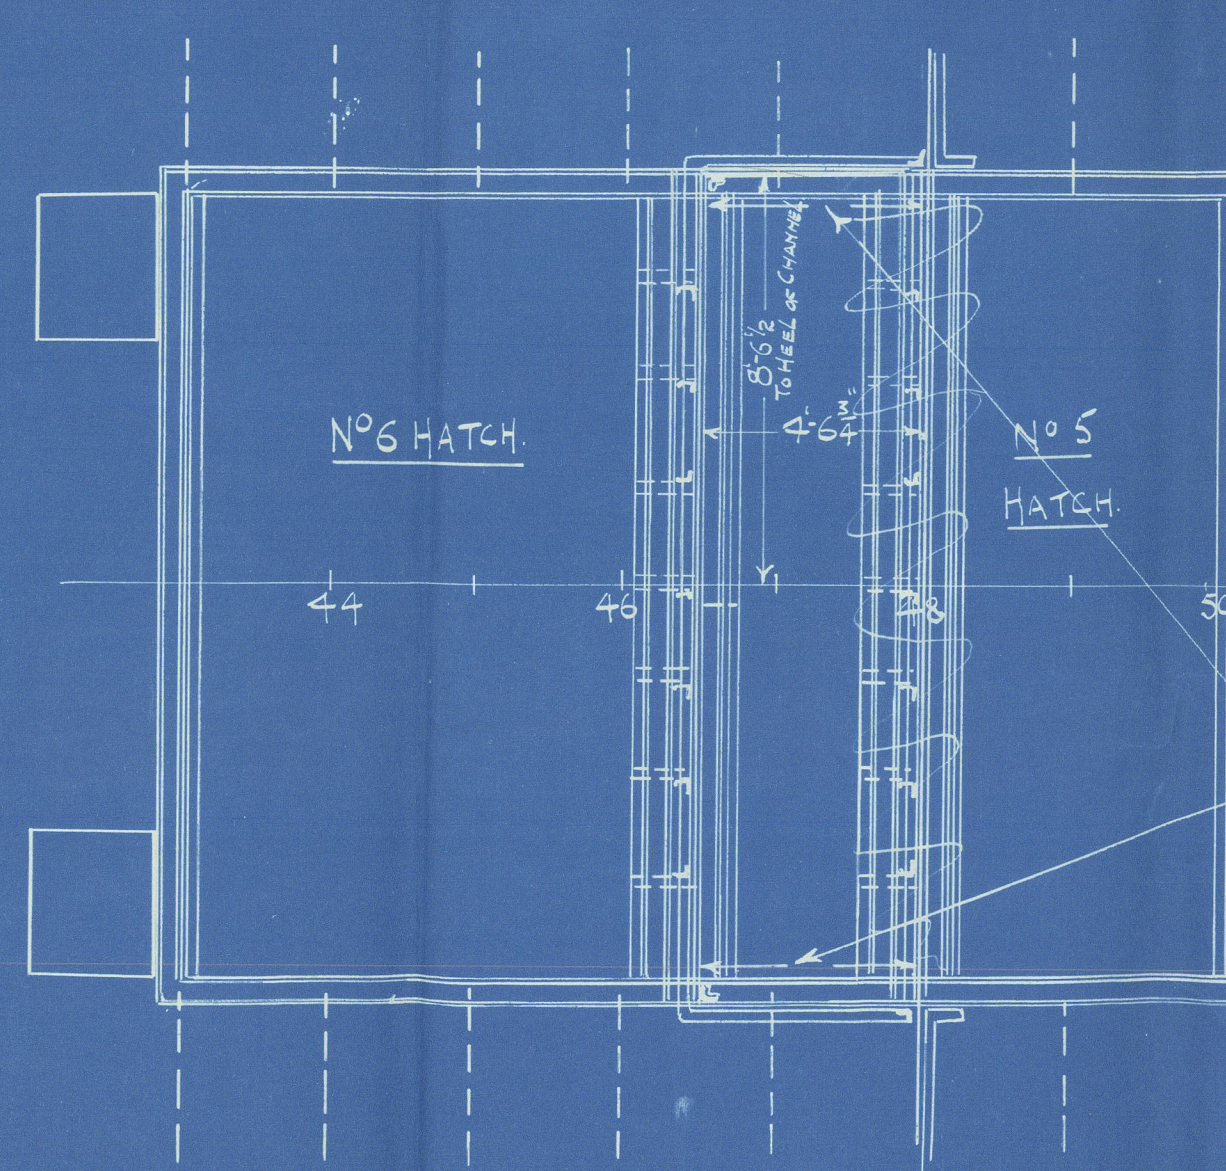

T. S. S. "MONTROSE."

Nº 465


DECK PLANS SHEWING ALTERATIONS.
IN WAY OF NOS 5 & 6 CARGO HATCHES.

DRG. No 43427

SCALE 1/4" = 1 FOOT.


24 10 22

SECTION AT 47 BEAM "E" DECK.
LOOKING FORWARD

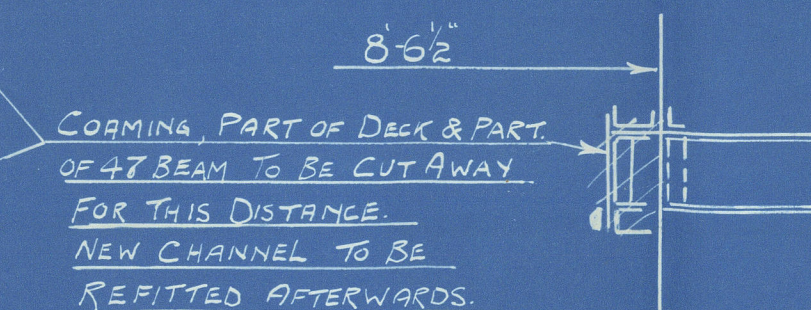


NOTE: - PART OF 48 BHP SCORED OUT IN RED TO BE REMOVED & RE-FITTED AT 4'-6 3/4" FURTHER AFT (46 1/2")


PLAN AT "D" DECK.

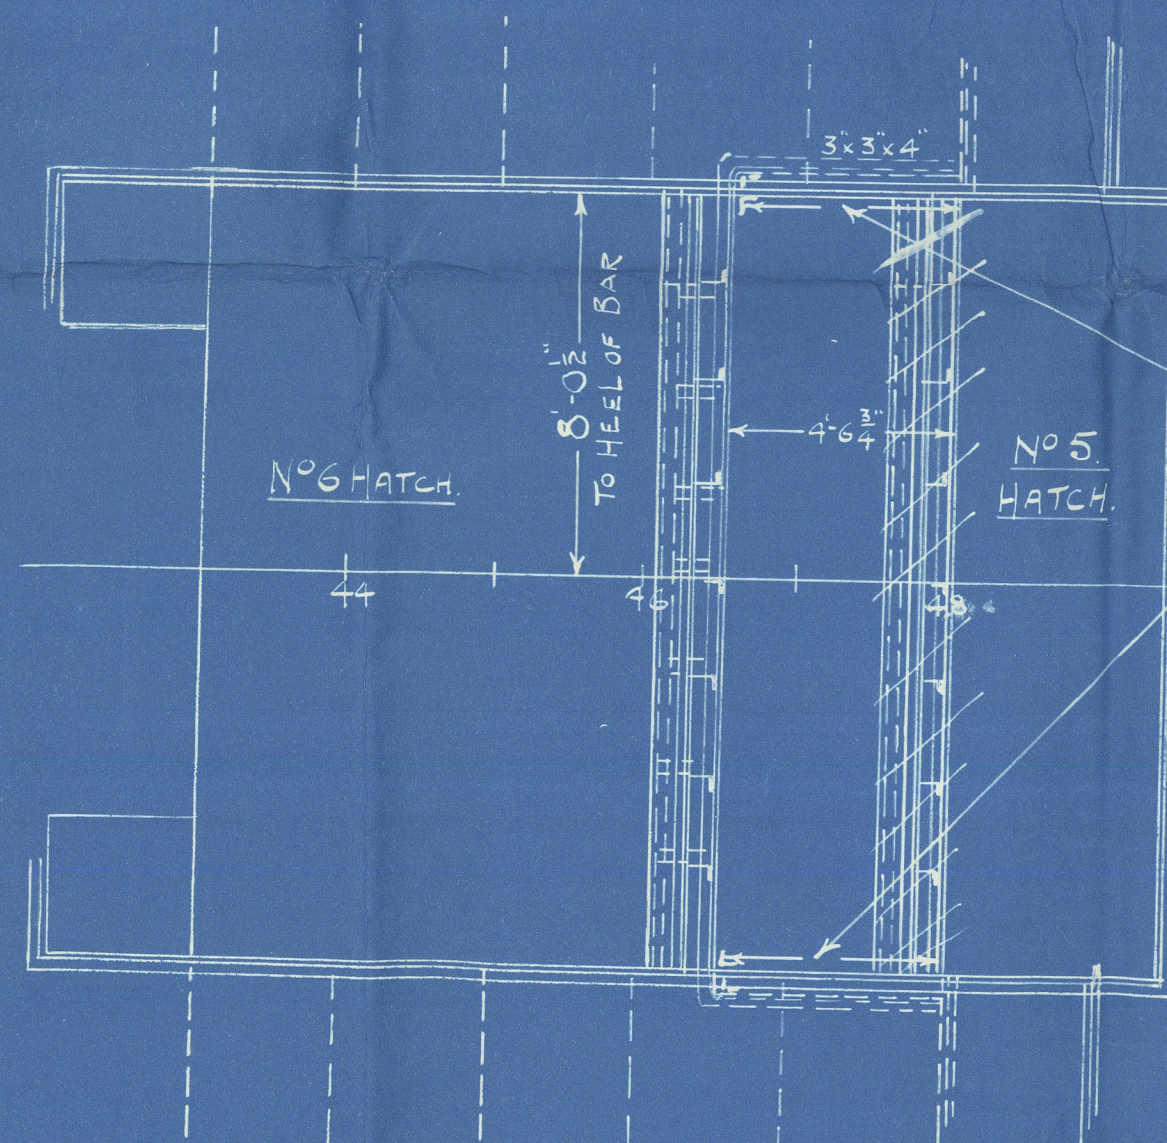


SECTION AT 47 BEAM "D" DECK.
LOOKING AFT.

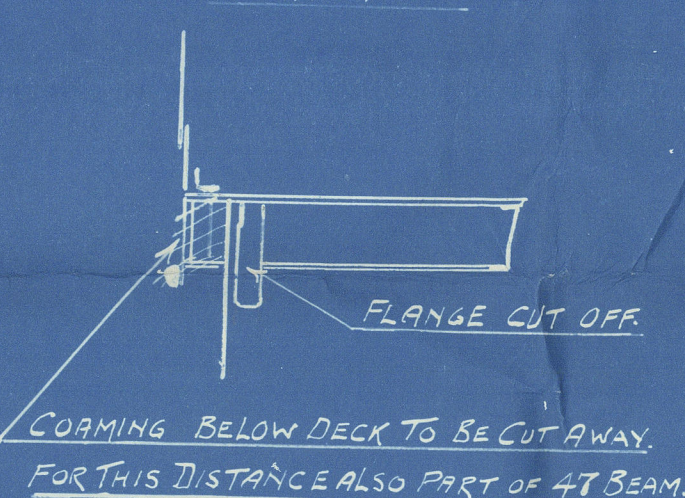



PLAN AT "F" DECK.

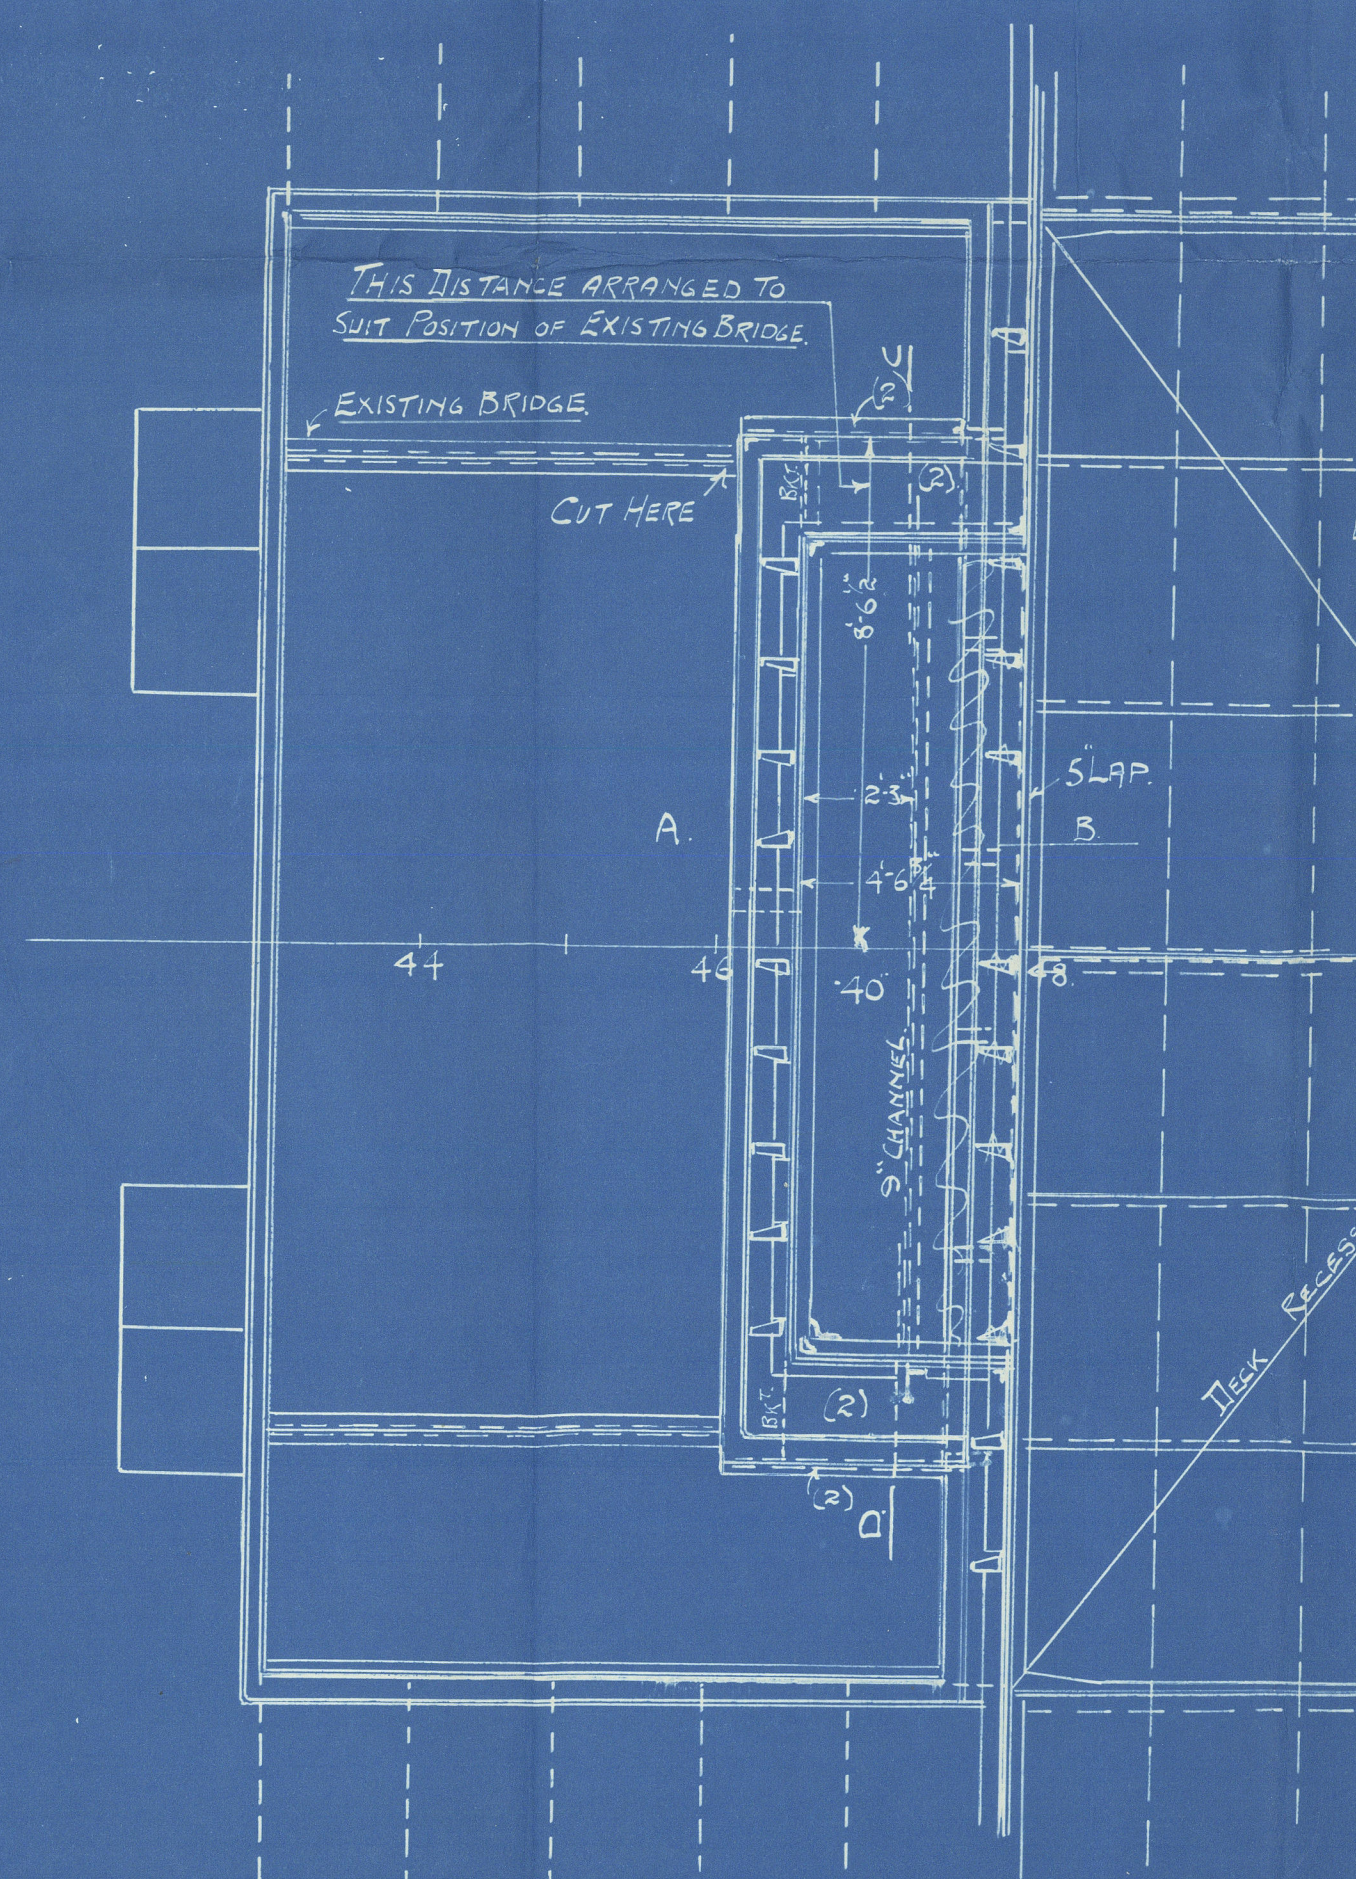

SECTION AT A.B.

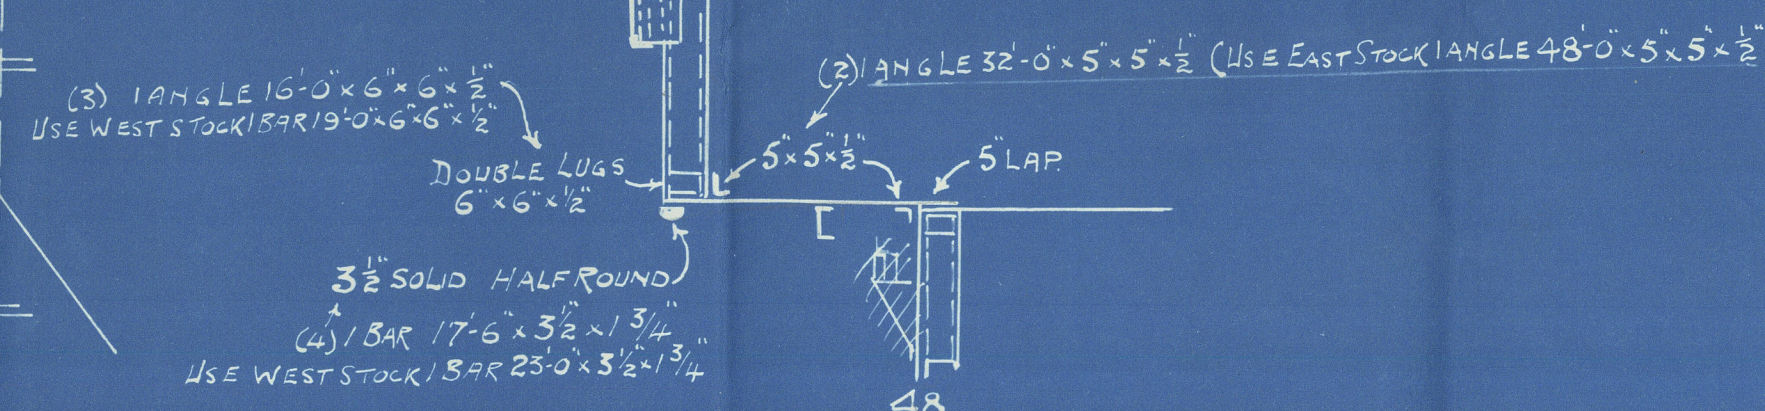

SECTION AT C.D.
LOOKING FORWARD

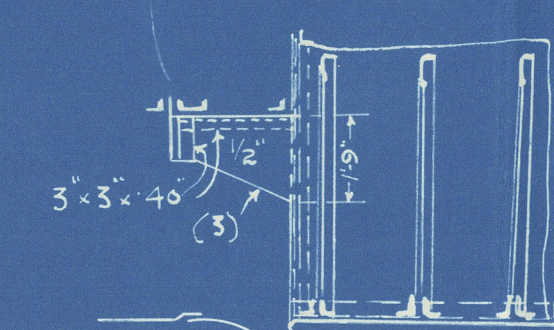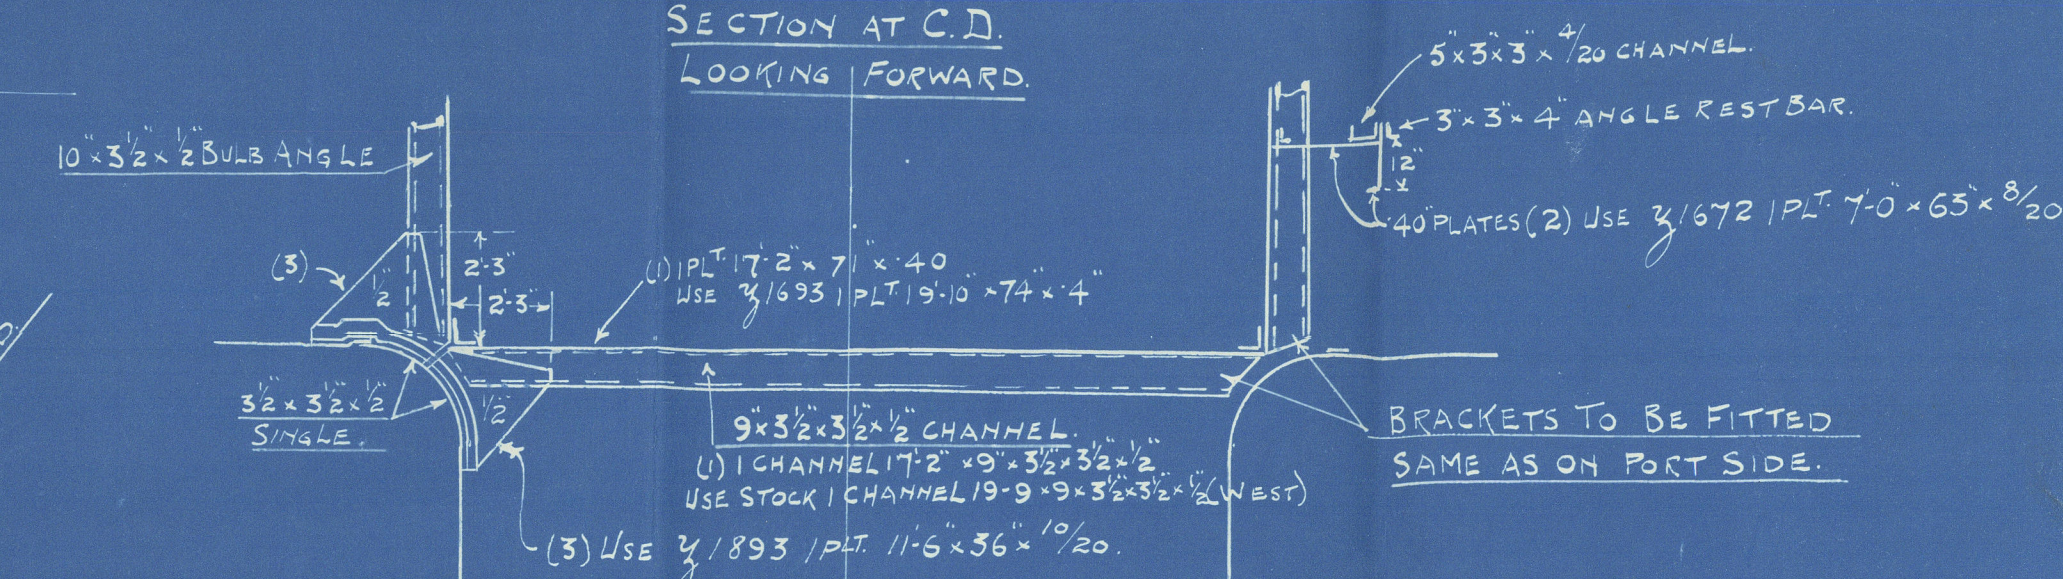

26-10-22


S/s "Montrose"

Alterations in way
of Nos 5 & 6. Cargo Hatches

S. S. *Montcalm*

LIVERPOOL.

Report No. *84766*

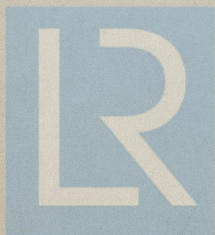

© 2021

Lloyd's Register
Foundation

009522-009526-0046



© 2021

Lloyd's Register
Foundation



009522-009526-0046



© 2021

Lloyd's Register
Foundation