


Nos 464-5.

(RULE) 548-8' x 70'-0" x 43'-3" M^{LD} TO SHELTER DECK.


34'-6" " " UPPER DECK.

PROFILE.

SCALE 1/8" = 1 FOOT.

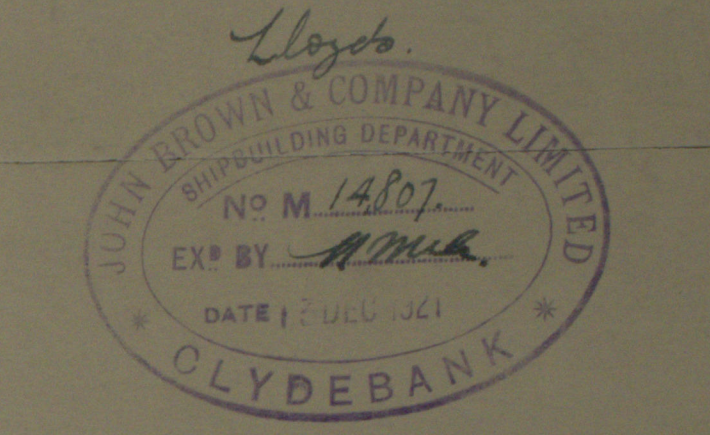


SECTION IN WAY OF MT PIPE TUNNEL
BETWEEN FRG 118-120
SCALE 1/4" = 1 FOOT

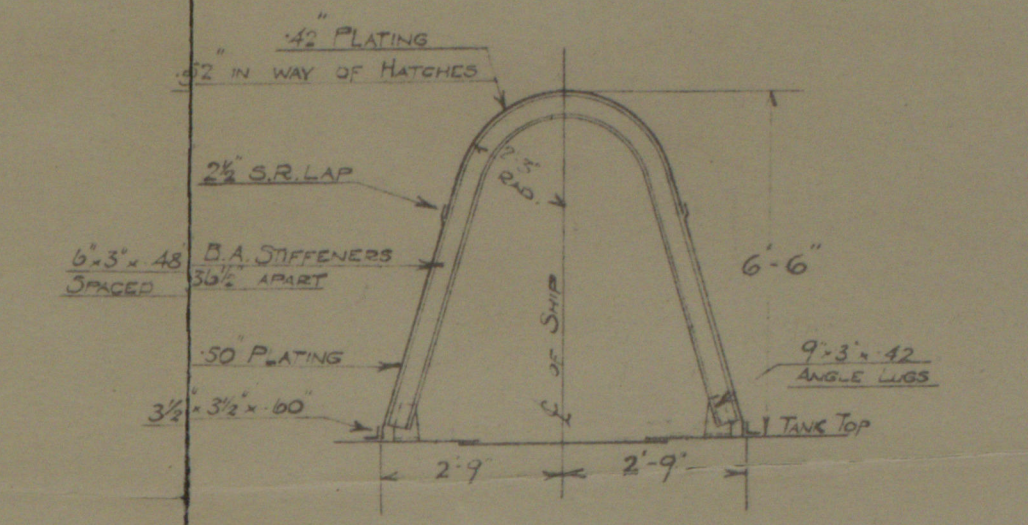

SKETCH OF HATCHWAYS TO BE SUBMITTED
SHOWING ADDITIONAL STRENGTHENING IN VIEW
OF DISTANCE OF SIDE COAMINGS FROM GIRDERS.

SKETCH SHOWING STRENGTHENING AT BREAKS
OF REELINGS TO BE SUBMITTED.

 

John Brown & Co. Ltd

Profile

(As built)

Nº 666.

TSS' MONTCALM

GLASGOW REPORT No. 41592

Sister to Montclare



© 2021

Lloyd's Register
Foundation

009522-009526-0055