


SCALE  $\frac{1}{8} = 1$  FOOT



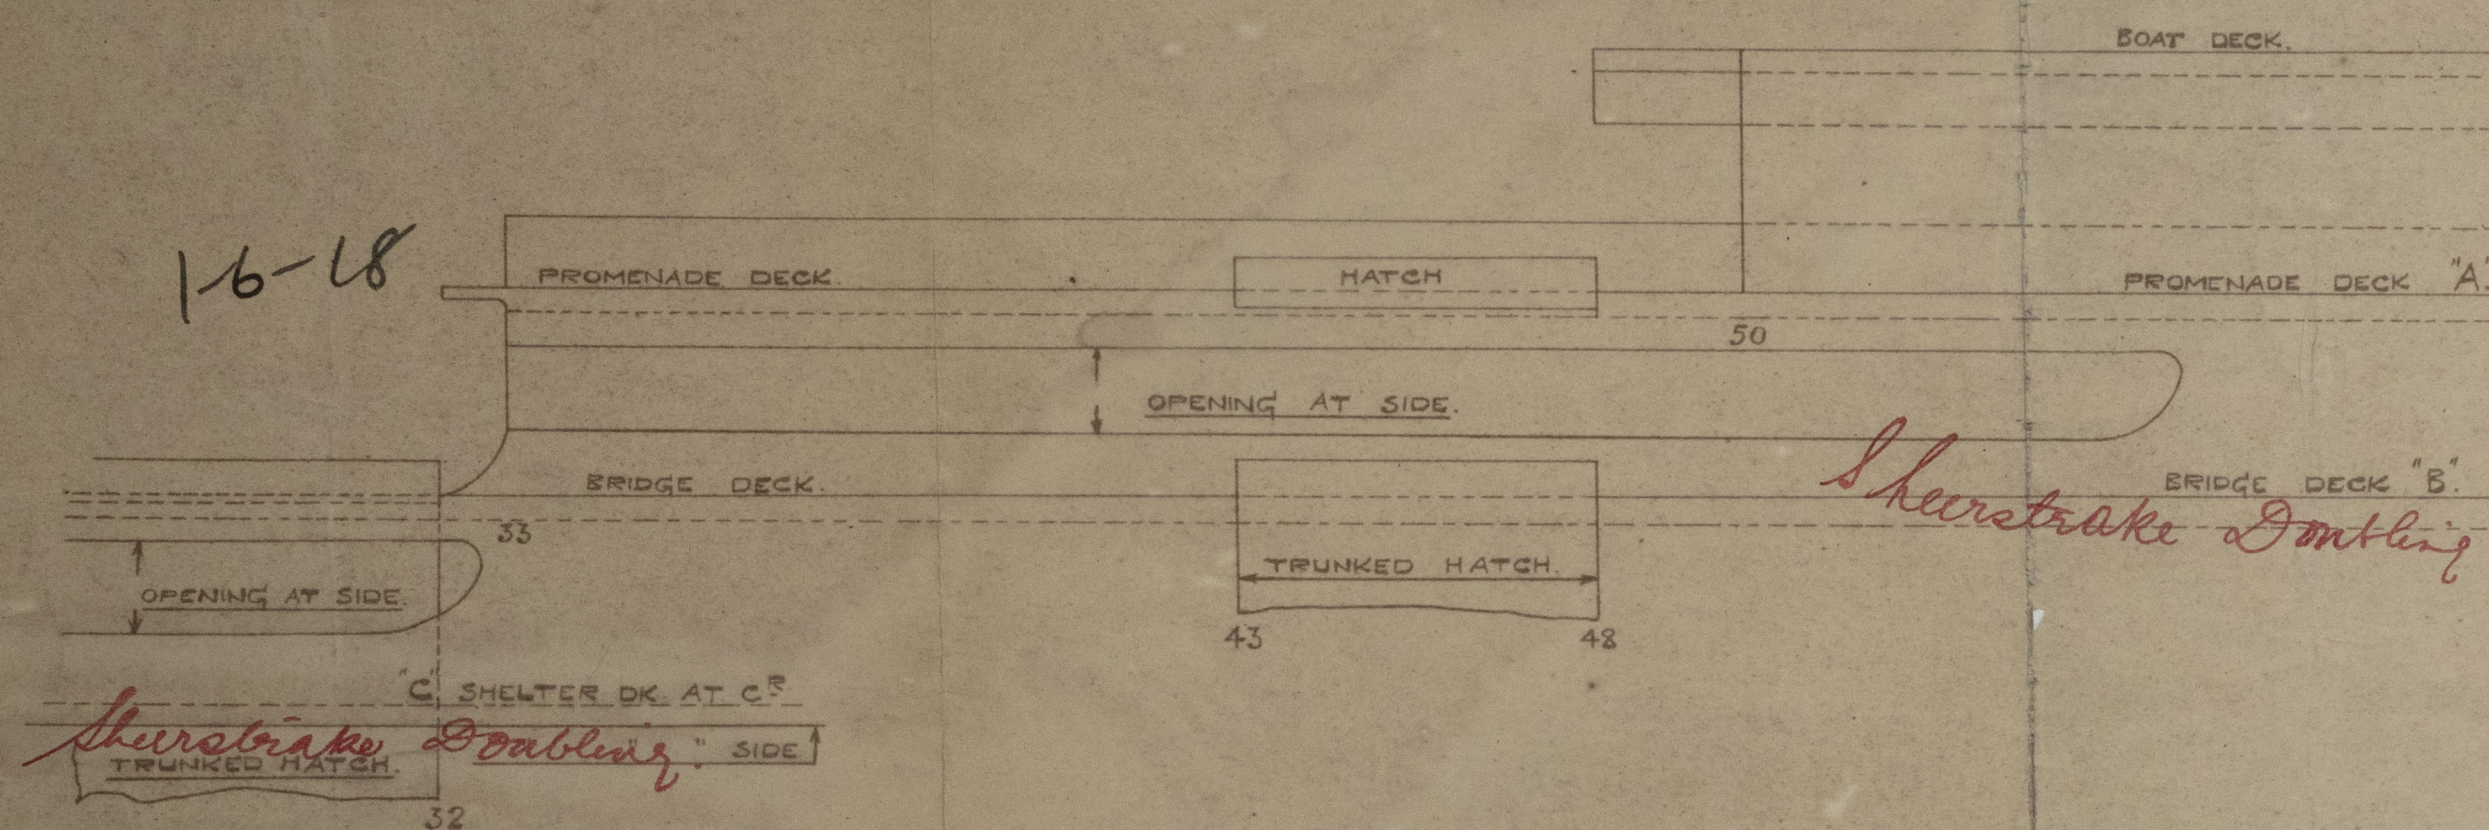


BUTTS OF STRINGER T.R. ALL FORE & AFT  
" " DECK PLATING D.R. ALL FORE & AFT  
EDGES " " " S.R. " " " "

BEAMS 8 ~~6~~" x 3" x ~~30~~ BULB ANGLES

T. S. S. N<sup>OS.</sup> 464-5.  
PROMENADE DECK. "A"

SCALE  $\frac{1}{8}"$  = 1 FOOT.

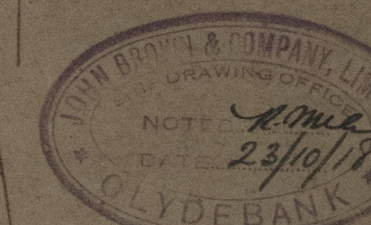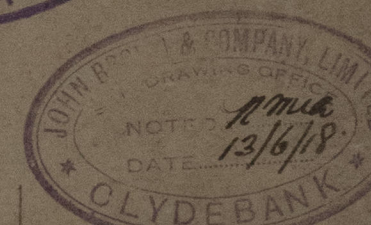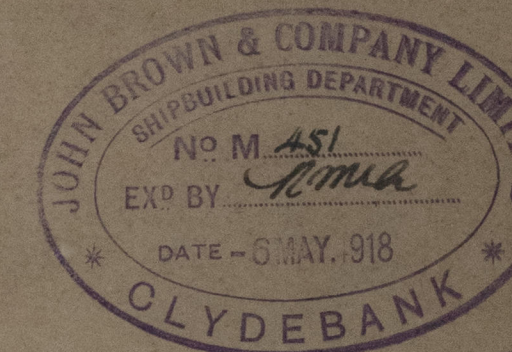



✓  
BUILDERS. Messrs John Brown & Co. Ltd.

YARD NO. S. 464-5

PLAN. PROMENADE DECK "A"

SHIP'S NAME, T.S.S. "Montcalm"

GLASGOW REPORT No. 41592

S.S. "Montrose"

GLASGOW REPORT No. 41829

T.S.S. "Montclair"

GLASGOW REPORT No. 42102



© 2021

Lloyd's Register  
Foundation

009522-009526-0058