


COPY

Approved
J. Montgomery
Lloyd's Register
of Shipping
10-2-18

Approved
Benjamin Taylor
British Corporation
Register of Shipping
18/2/18

PROFILE & DECK PLANS. STANDARD VESSEL TYPE "H".

SCALE 1/8" = 1 FOOT

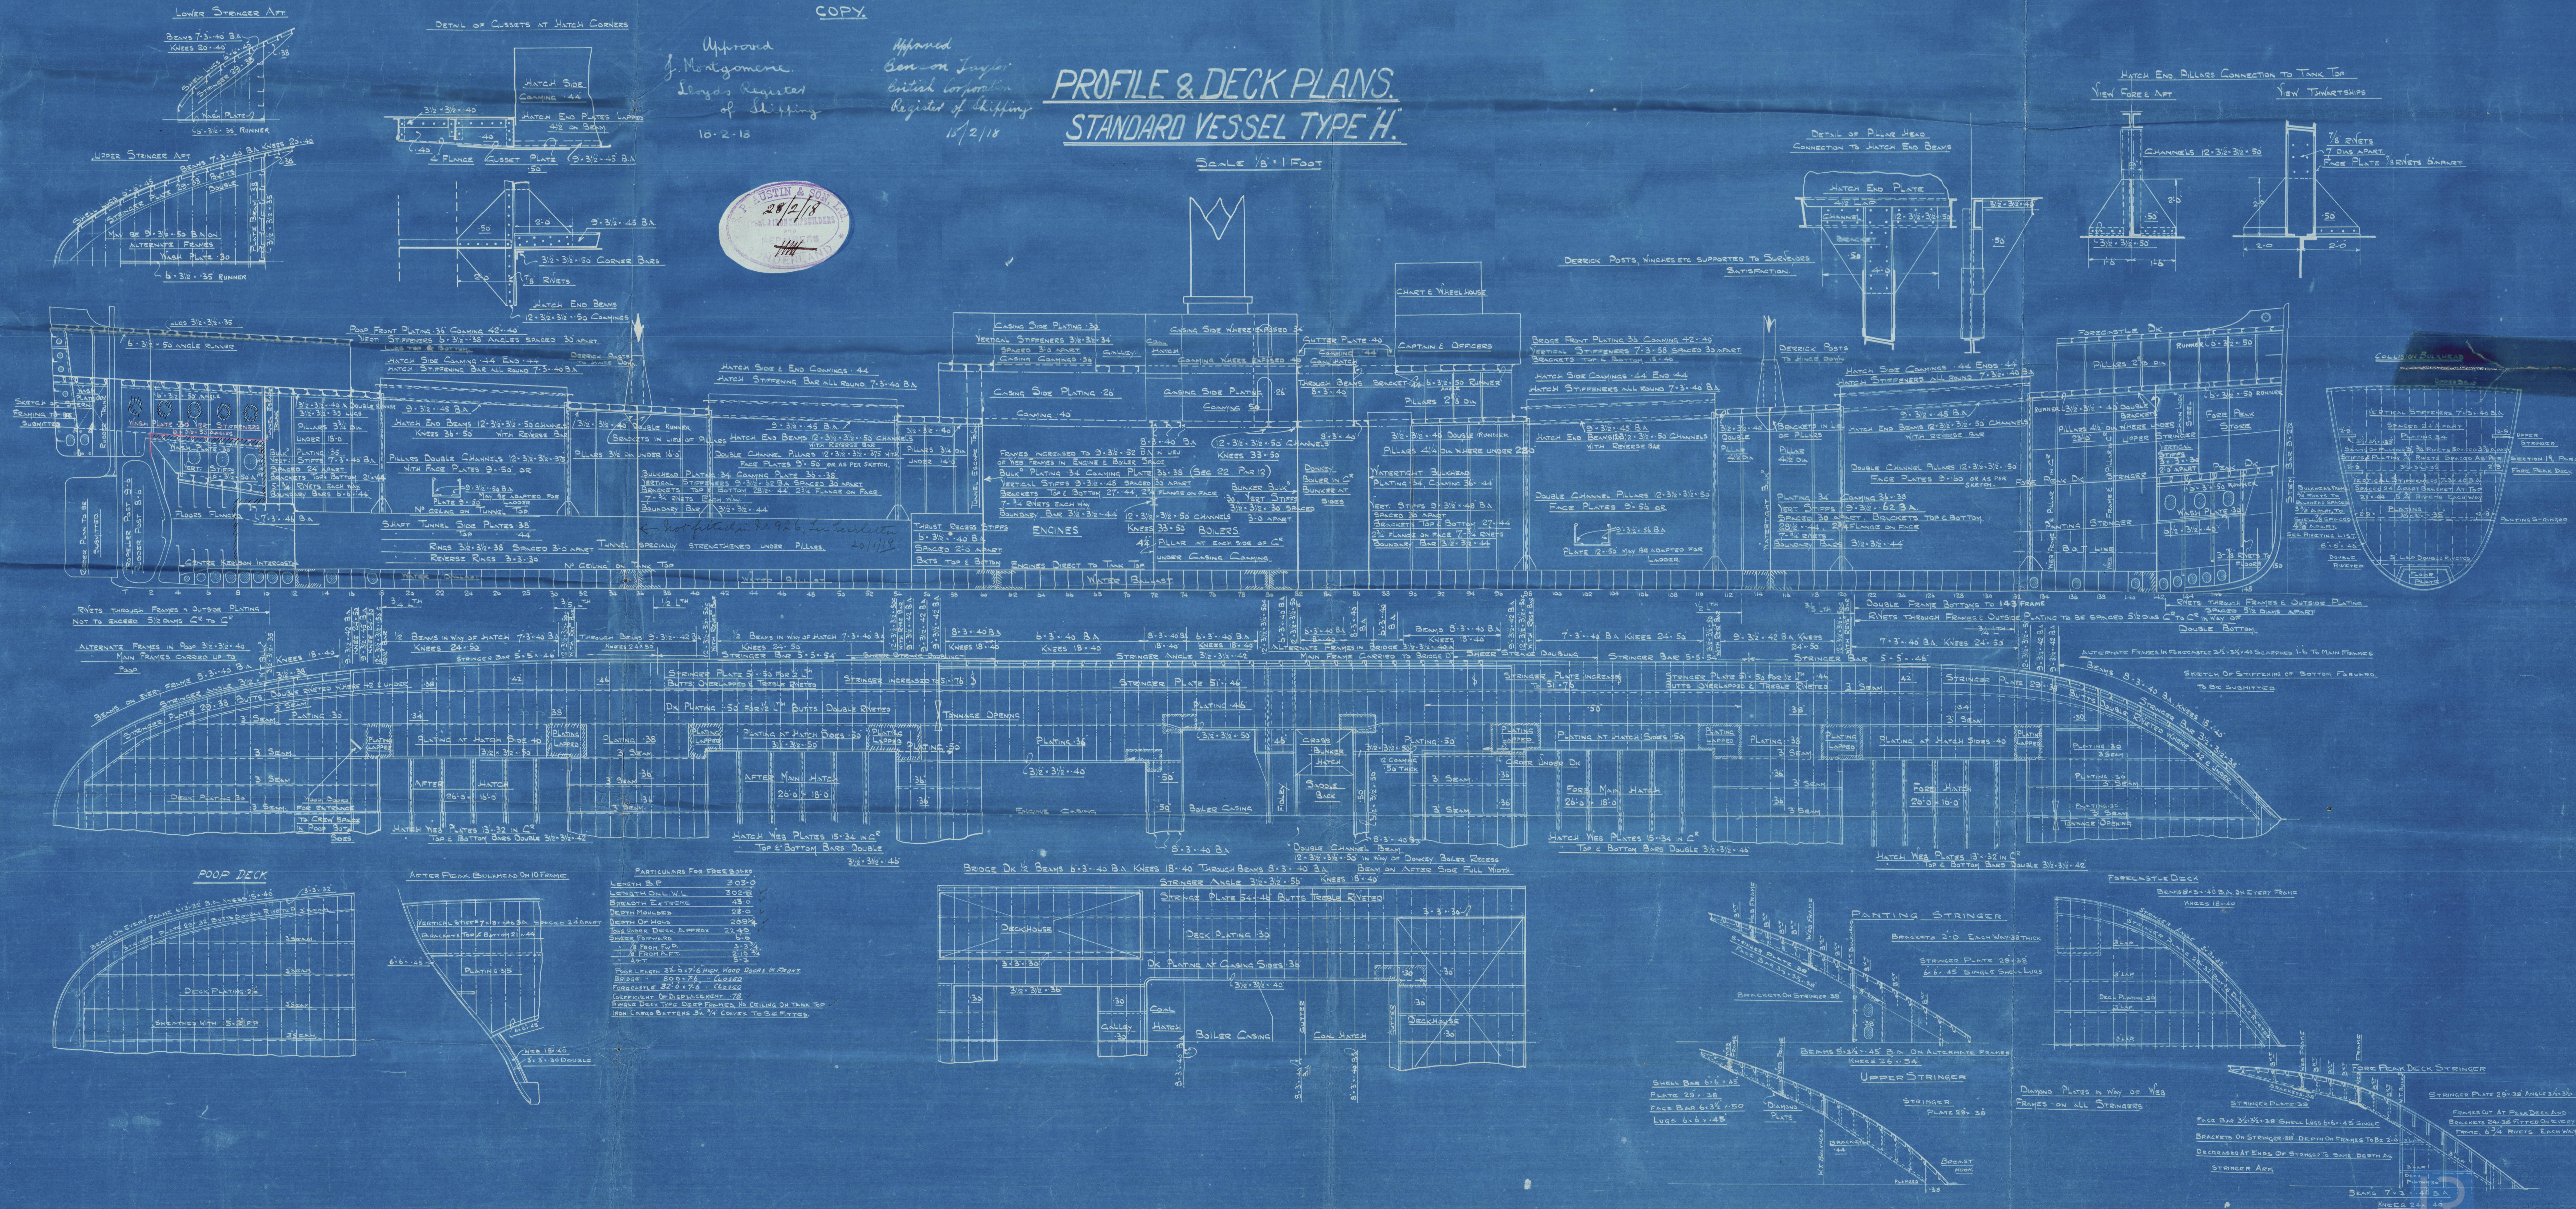

009557-009569-0001

Mr. W. Gray & Co.
Profile & Deck Plans.

No. 908, 912, 916 & 922. 926

S.S. "WAR MANGO" (No. 908)
TYPE "H"


Report No. 15554.

912: S. War Apricot (912)

West Hartlepool Report 15564.

916: S. War Currant (916)

West Hartlepool Report 15611.

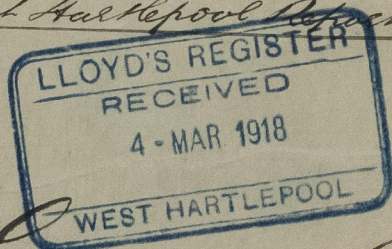

S. Erodo (922)
West Hartlepool report
No. 15644

S. Kara (926)
West Hartlepool rht
No. 15685



© 2020

Lloyd's Register
Foundation

004557 009569-0001