


SCALE  $\frac{1}{2}'' = 1 \text{ FOOT.}$

CLASS 100 A.I. LLOYDS &  
~~P.S. & ASSOCIATES~~

" " STEEL 30 " " " DOUBLE " ✓

FILE + POOP ON SPRINGER PLATE 29" x 32 BUTTS LAPPED + DOUBLE

FILE OF STEEL 30 SHEATHED IN WAY OF WINDLASS ONLY

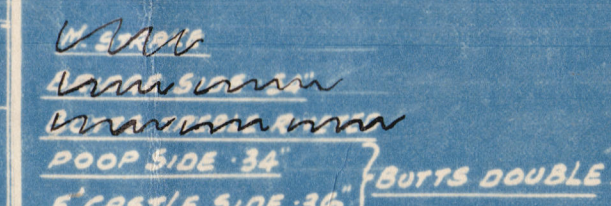

Wm  
 K5 STRAKE 85 1/2" WIDE  
 BRIDGE SIDE 54" BUTTS QUAD. OVERLAPS.  
Wm Wm  
 DOOR SIDE 34" } BUTTS DOUBLE RIV?  
 F. CASTLE SIDE 36" }  
 54" LAP

J  
N. 50° - 54°  
SHEER STRAKE BUTTS TRIBLE  
IN WAY OF BRIDGE.  
 5 1/2 LAR.

H. 70

54 LAP.

G. 70

54 LAP

F 70

55-100



100

908.

908

© 2020  
Lloyd's Register  
004557-001564-0002




"EREGLI" DS 173  
S.S. "WAR MANGO"

Midship Section of  
vessel as built.

Imp: W. Gray & Co.

S.S. N: 908.

TYPE "H"

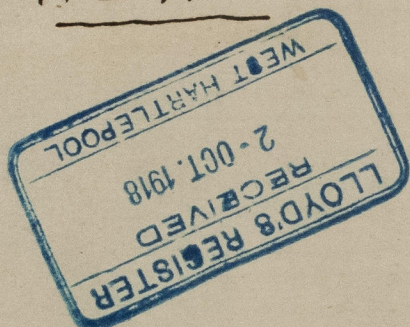

West Hartlepool Regd. 15352.

009557-009559-0002



© 2020

Lloyd's Register  
Foundation