

31.12.14
12.1.15
18.3.16.

PLAN OF BULKHEADS, HATCHES AND CASINGS TO BE SUBMITTED


S.S. No 227.

PROFILE AND DECK PLANS.





385 O.B.P. x 52'8" M^{LD} x 28'9" M^{LD}

SCALE 1" = 1 FOOT

LLOYDS 100 A1 CLASS

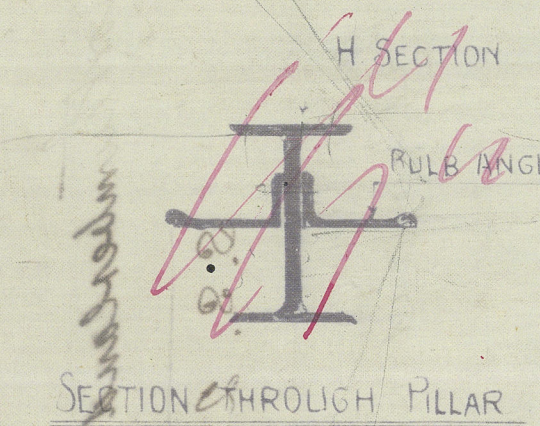

See Section 22 para B

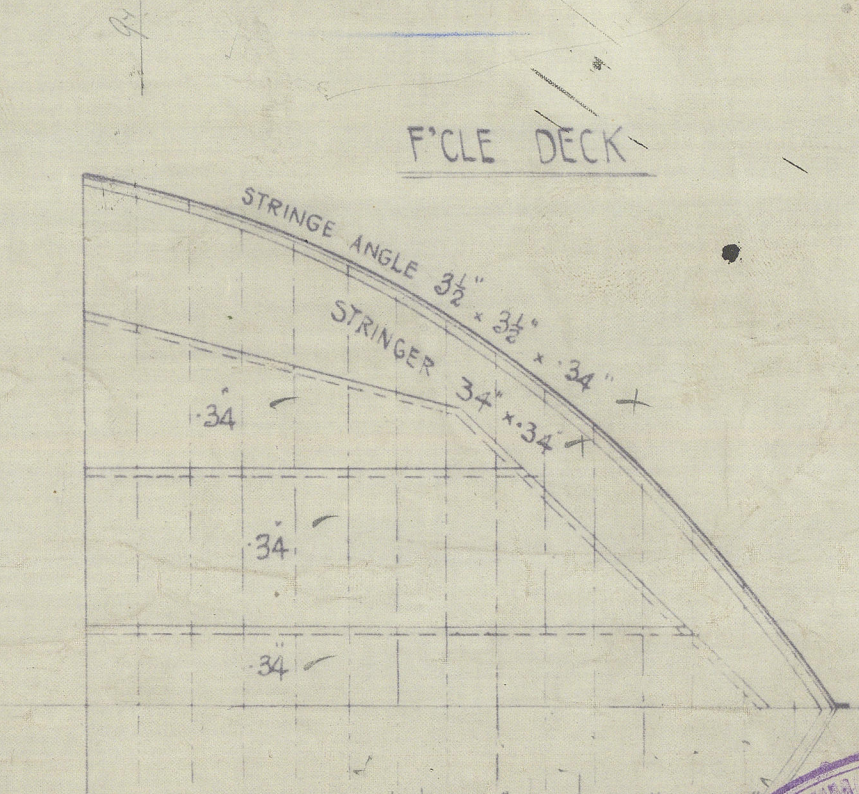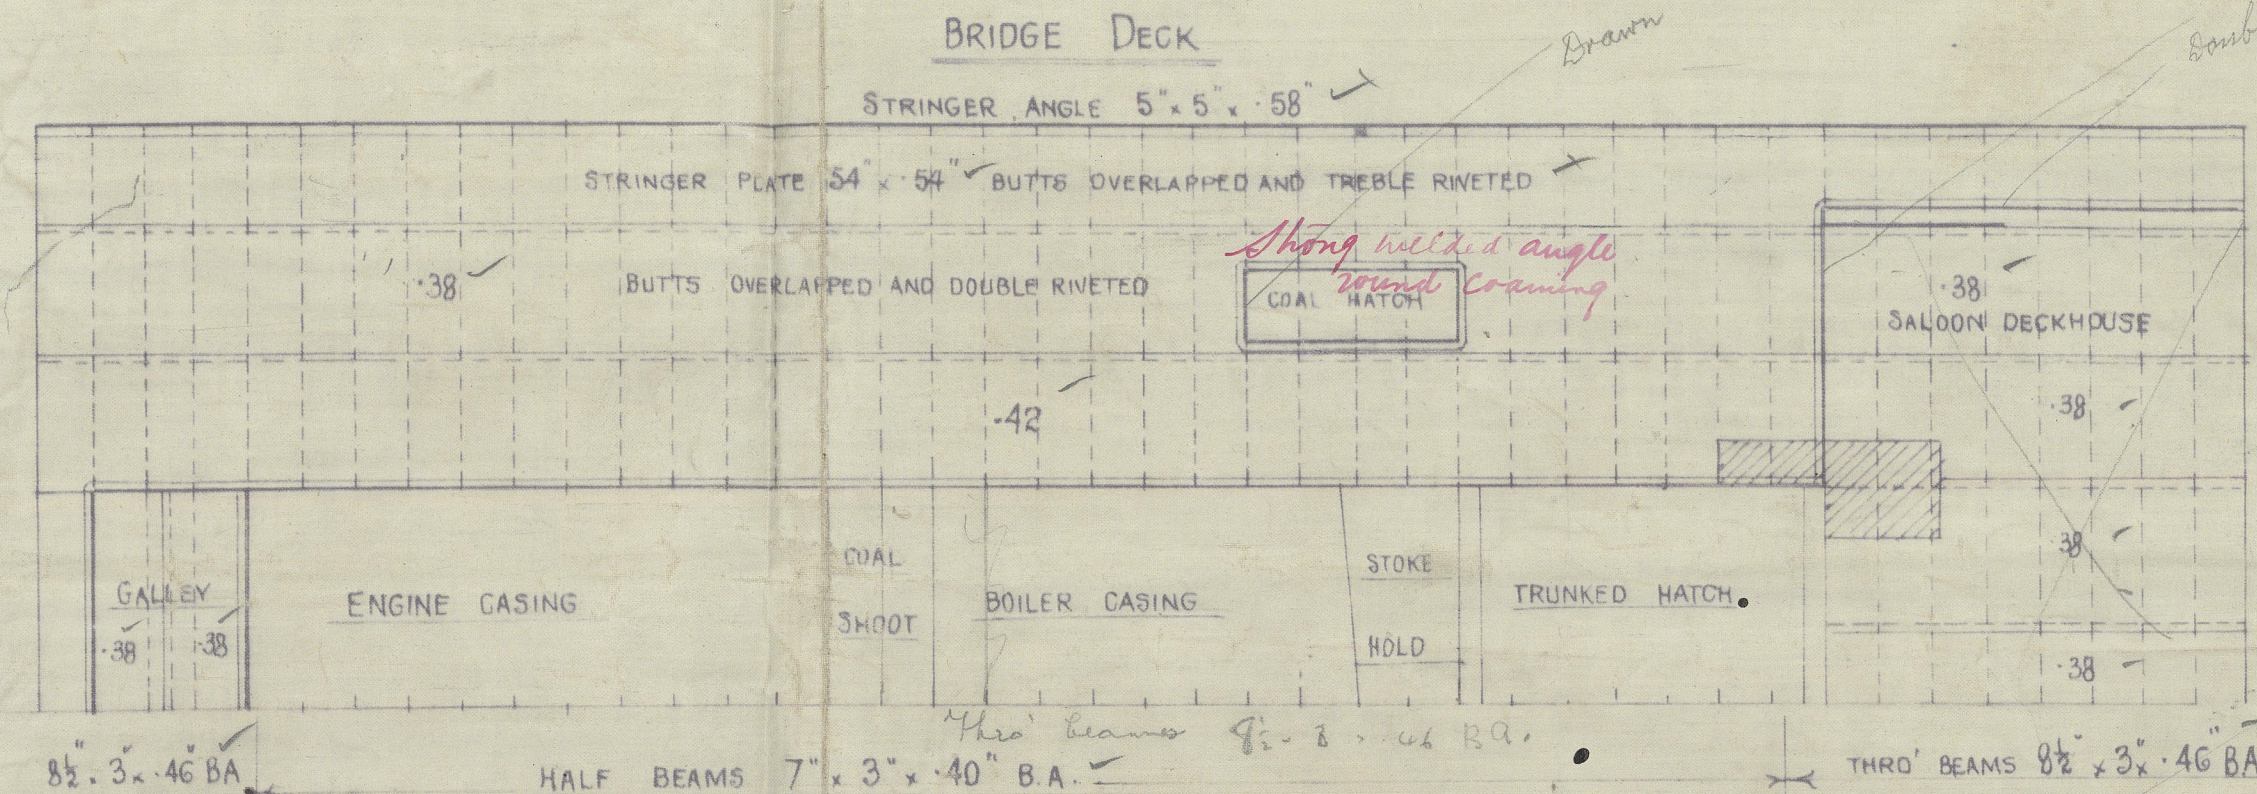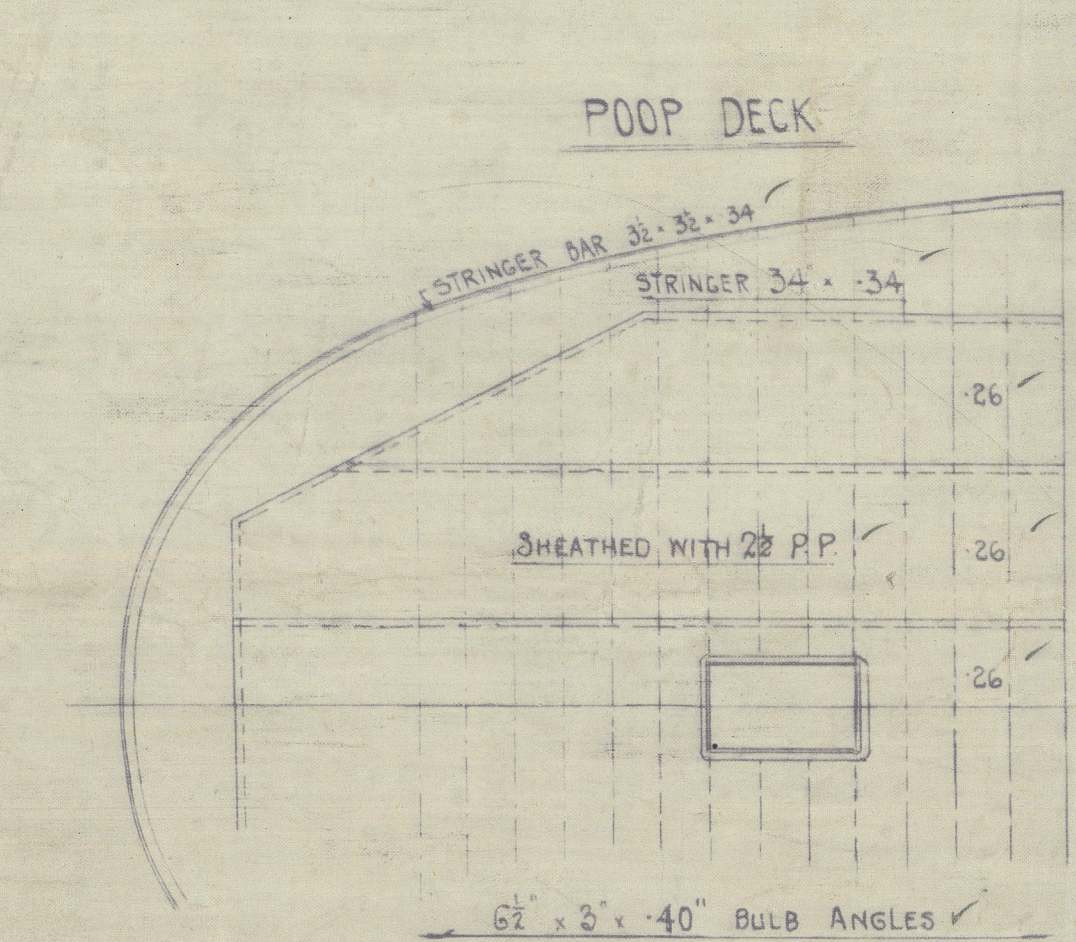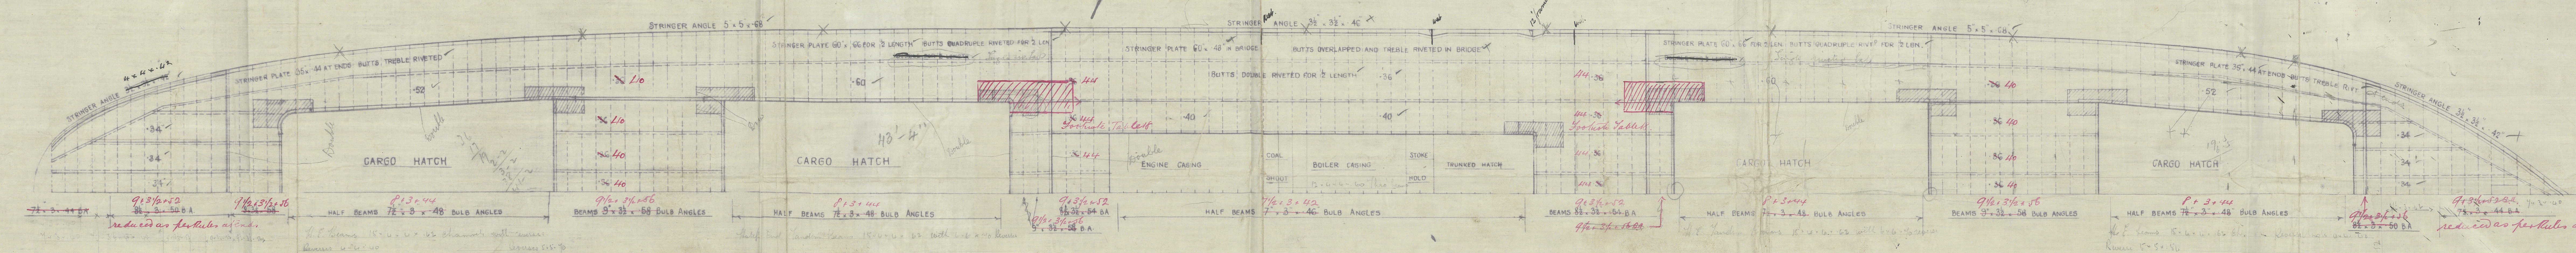




Northumberland S. Co

S.S. 224

Profile and Deck plan

SS "TANFIELD"
NEWCASTLE ON TYNE.

Report No. 68844

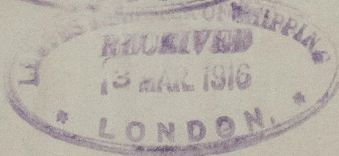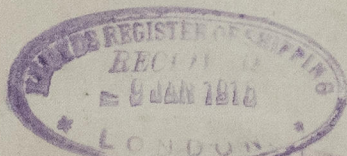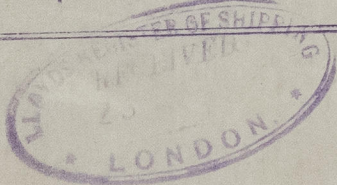

© 2021

Lloyd's Register
Foundation