

Lloyd's Register of Shipping.

SURVEYS FOR FREEBOARD.—STEAM SHIPS.

PARTICULARS RELATING TO ALL STEAM SHIPS EITHER FLUSH DECKED, OR WITH TOP GALLANT FORECASTLES, SHORT POOPS AND BRIDGE HOUSES DISCONNECTED, OR WITH TOP GALLANT FORECASTLES HAVING LONG POOPS, OR RAISED QUARTER DECKS CONNECTED WITH BRIDGE HOUSES, OR OTHERWISE.

Port of Survey Baleia.
Date of Survey 25.8.28.
Name of Surveyor S. J. G. G. G.

Ship's Name. "Tanfield"	Port of Registry and Nationality. <u>Glasgow British</u>	Official Number. <u>137816</u>	Gross Tonnage. <u>4538</u>	Date of Build. <u>1916</u>	Particulars of Classification. <u>+100A.1.</u>
-----------------------------------	---	-----------------------------------	-------------------------------	-------------------------------	---

Registered dimensions from Ship's Register.	LENGTH. <u>385.2</u>	BREADTH. <u>52.95</u>	DEPTH. <u>26.25</u>	UNDER DECK TONNAGE. <u>4235.41</u>
Length on LOADLINE.	<u>385.2</u>	Frame Depth Rule <u>12</u> <u>6</u> <u>2 = 11.0</u>	Ceiling + .20 Sheer <u>11.10</u>	Peak Tanks } Incl. } Tanks
CORRECTED DIMENSIONS.	<u>385.2</u>	<u>51.95</u>	<u>27.55</u>	<u>4235.41</u>

Moulded Depth as measured..... 28'-9"
wood dk less SH. - 3 1/2"
 Addition for Keel below base line for draught record..... 28'-5 1/2" 6 in

NOTE.—If the depth is measured when vessel is afloat, the details of measurement should be reported.

CORRECTION FOR LENGTH

Length of Ship on Loadline.....	<u>385.2</u>
Length in Table	<u>341.5</u>
Difference	<u>43.7</u>
Correction for 10ft., Table A.	<u>1.5</u> Table C.
× Difference divided by 10	<u>6.55</u> (if required.)
If 1/10ths length covered divide by 2	<u>+ 6 1/2"</u> <u>+ 3"</u>

CORRECTION FOR IRON DECK.

Proportion covered, if less than 1/10ths length covered In med. depth.
 Thickness of usual wood deck, less stringer

CORRECTION FOR ROUND OF BEAM.

Breadth at Gunwale amidships.....	<u>50.66</u>
Round of Beam	<u>12 1/2"</u>
Normal round.....	<u>12 1/2"</u>
Difference	<u>✓ ÷ 2 =</u>
Proportion of Deck uncovered (Para. 19)	

NOTE.—The round of beam should be reported on the full breadth of vessel at the gunwale.

Freeboard, Table A	<u>6'-10 1/4"</u>
Correction for Sheer	<u>- 9 3/4"</u>
Correction for Length	<u>6'-0 1/2"</u>
Allowance for Deck Erections	<u>+ 6 1/2"</u>
Correction for Round of Beam.....	<u>6.4</u>
Correction for fall in Sheer (if any).....	<u>- 4 1/2"</u>
Correction for Steel Deck (if required)	<u>5'-11 1/2"</u>
Additions for non-compliance with provisions of Para. 11 (d) and (e) †	
Other Corrections (if any)	

Efficient of fineness..... .44 .768
 Modification necessary (Para. 4 (a) to (e))* C.O.B
 Efficient as corrected75 .741

Stem..... 105" 174 ÷ 2 = 87 ...Mean
 Sternpost ... 69"

Stem 59 } 97 ÷ 2 = 48.5 Mean
 Sternpost 38 } ÷ .55 = 88.18
 allowed 87.59

Standard mean Sheer [Table, Para. 18] 48.52 Correction
 Difference..... 39.07 ÷ 4 = 9.76
 If limited as Para. 18 (f) - 9 3/4"

Rise in Sheer from amidships [Para. 18 (e)]
 At front of bridge house..... ✓
 At after end of forecastle ✓

Fall in Sheer [Para. 18 (d)]
 ✓ ÷ 2 =
 Length uncovered Correction

ALLOWANCE FOR DECK ERECTIONS:—

Freeboard, Table C.....	<u>3'-8 3/4"</u>
Correction for Length, if required (Para. 12, 13, and 14)	<u>+ 3</u>
Freeboard by Table A, corrected for sheer, and for length, if required (Para. 12, 13, and 14)	<u>3'-11 3/4"</u>
Difference	<u>6.4</u>
Percentage as below.....	<u>2.4 1/4"</u>

Correction for R. Q. Dk. if engine and boiler openings not covered by bridge house (Para. 11) }
 Allowance for Deck Erections - 7 1/2"

	Length.	Length allowed.	Height.
Forecastle.....	<u>30.8</u>	<u>30.66</u>	<u>7.0</u>
Bridge House	<u>91.0</u>	<u>91.00</u>	<u>7.0</u>
† Raised Qr. Dk.....			
Poop.....	<u>26.4</u>	<u>26.33</u>	<u>7.0</u>
Total		<u>148.00</u>	<u>38.42</u>
Length of Ship		<u>385.2</u>	

Corresponding percentage (Para. 11, 12, 13, or 14) 24.01%

FREEBOARD recommended amidships from centre of Disc to top of Statutory Deck Line, Wood (Steel) Deck:—

Fresh Water Line above centre of Disc	
Indian Summer Line " " "	
Winter Line below " "	
Winter North Atlantic Line " " "	

Winter Freeboard	<u>5'-11 1/2"</u>
Summer Freeboard	<u>5'-6 1/2"</u>
Indian Summer Freeboard	<u>5'-1 1/2"</u>
N. A. Winter Freeboard	
Correction necessary because clearside amidships, measured in accordance with the Statute is not taken at the intersection of the wood or steel deck with side.	<u>2"</u>
Winter Freeboard from deck line	<u>6'-1 1/2"</u>
Summer " " " "	<u>5'-8 1/2"</u>
Indian Summer " " " "	<u>5'-3 1/2"</u>
N. A. Winter " " " "	<u>5'-8 1/2"</u>
Wood (Steel) Deck:—	
.....	<u>5 1/2"</u>
.....	<u>5"</u>
.....	<u>5"</u>

† If the frames, skin planking, or ceiling are of unusual thickness the breadth of vessel to inside of ceiling should be reported if possible.
 ‡ In vessels obtaining an allowance for deck erections under Para. 11 where the sheer drops abaft amidships the height of the R.Q.D. is to be taken from the level of the top of the amidship beam.
 § In flush-decked vessels the total standard mean sheer means the sheer measured at the stem and sternpost. In vessels having poops and forecastles, it means the sheer measured at points distant one-eighth of the vessel's length from stem and sternpost.


Do all the Frames extend to the top height in the Poop? *Yes* Raised Quarter Deck? *Yes* Bridge House? *Yes* Forecastle? *Yes*
 To what height do the Reverse Frames extend? *Bulk Angle frames*
 Has the Poop or Raised Quarter Deck an efficient Iron Bulkhead at the fore end? *Yes*
 Give particulars of the means for closing the openings in Bulkhead *Hinged wood doors*
 Is the Poop or Raised Quarter Deck connected with the Bridge House? *No* Has the Bridge House an efficient Bulkhead at the fore end? *Yes*
 Give particulars of the means for closing the openings in Bulkhead *No openings*
 What is the thickness of the Bridge Front plating? *.40* and Coaming plate? *.44*
 Give scantlings and spacing of the Stiffeners *8 x 3 1/2 x .64 Bulk angles spaced 30"*
 Are bracket plates fitted at each end of the Stiffeners? *Yes* Are hor'l. brackets fitted connecting Bridge Bulk'd. with Bulwarks? *Yes*
 Has the Bridge House an efficient Iron Bulkhead at the after end? *Yes*
 How are the openings closed? *Storm boards in riveted channels full height*
 Is the Forecastle at least as high as the main or top-gallant rail? *7'-0"* Has the Forecastle an efficient Iron or Wood Bulk'd. at after end? *Yes*
 Are the Engine and Boiler openings covered by a Bridge, Poop, Raised Quarter Deck, or enclosed by a Strong Iron or Steel Deckhouse? *Covered by Bridgehouse*
 If the openings are not so protected are the exposed parts of the Casings efficiently constructed? *Yes*
 Give thickness of plating; scantlings and spacing of Stiffeners
 What is the height of the exposed Casings? Are suitable means provided for closing all openings in them in bad weather? *Yes*
 Are the Weather Deck Hatchways efficiently constructed and at least equal to the requirements of Section 28 of the Rules for 1904-5? Give particulars below:— *Yes*

Position and Size.	No. 1: 39'-0" x 28'-0"		No. 2: 39'-0" x 28'-0"		No. 3: 13'-2" x 18'-0"		No. 4: 43'-4" x 28'-0"		No. 5: 41'-2" x 28'-0"	
	Ship.	Rule.	Ship.	Rule.	Ship.	Rule.	Ship.	Rule.	Ship.	Rule.
COAMING. Height above top of DECK	30"		30"		30"		42"		42"	
Thickness	Sides	.64	.64		.40		.60		.54	
	Ends	.40	.40		.36		.40		.40	
SHIFTING BEAMS OR WEB PLATES.	Number	7	7		2		8		8	
	Section and Scantlings	Plate 33 x 36 Angles 4 x 3 x 40 Flange 6"	Plate 35 x 36 Angles 4 x 3 x 40 Flange 6"		Plate 22 x 34 Angles 4 x 3 x 40 Flange 6"		Same as No. 2.		Same as No. 1.	
	Material	Steel	Steel		Steel					
* FORE AND AFTERS.	Number									
	Section and Scantlings	✓	✓		✓		✓		✓	
HATCHES	Thickness	3"	3"		3"		3"		3"	
	Remarks	Fitted fore mast.								

* The depth of Fore and Afters should be stated from the underside of the hatches in all cases.
 (If the sill of the lowest side scuttle will be less than 6 inches above the Indian Summer Load Line if assigned under the tables, state vertical distance from top of deck at side amidships to lower edge of lowest side scuttle.)

The following information is to be given in all Cases of vessels dealt with under Paras. 11, 12 (under 15 feet Moulded depth) and under Shelter Deck Rules.

What is the thickness of the Bridge Sheerstrake? _____ Strake between Main and Bridge Sheerstrakes? _____
 Delete the words *The Crew are, are not, berthed in the bridge house.*
 that do not apply *The arrangements to enable them to get backwards and forwards from their quarters are, are not satisfactory.*
 Length of Bulwarks in well _____
 Area of Freeing Ports required by Para. 11 (e) each side of vessel = _____ Sq. ft.
 Ft. Tenths. Ft. Tenths. No. } Freeing Ports (each side of vessel) = _____ Sq. ft.
 Total deficiency or excess = _____ Sq. ft.

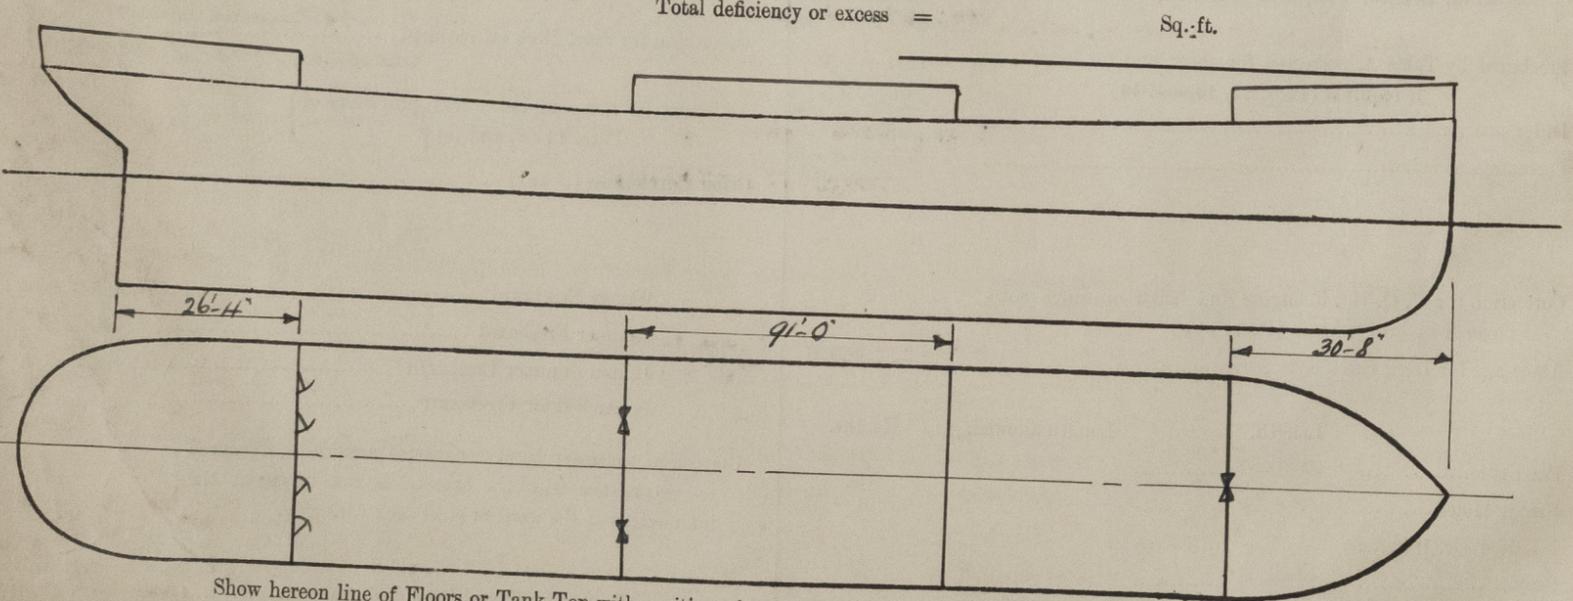

Show hereon line of Floors or Tank Top with position of any Breaks in same; also height of Peak Tank tops, &c., &c.

State any special features in the construction of the Vessel _____
 Builder's name and yard number _____
 Names of sister vessels _____
 Owners _____

Address _____
 See Rupees: 150/-
 Received by me _____

