
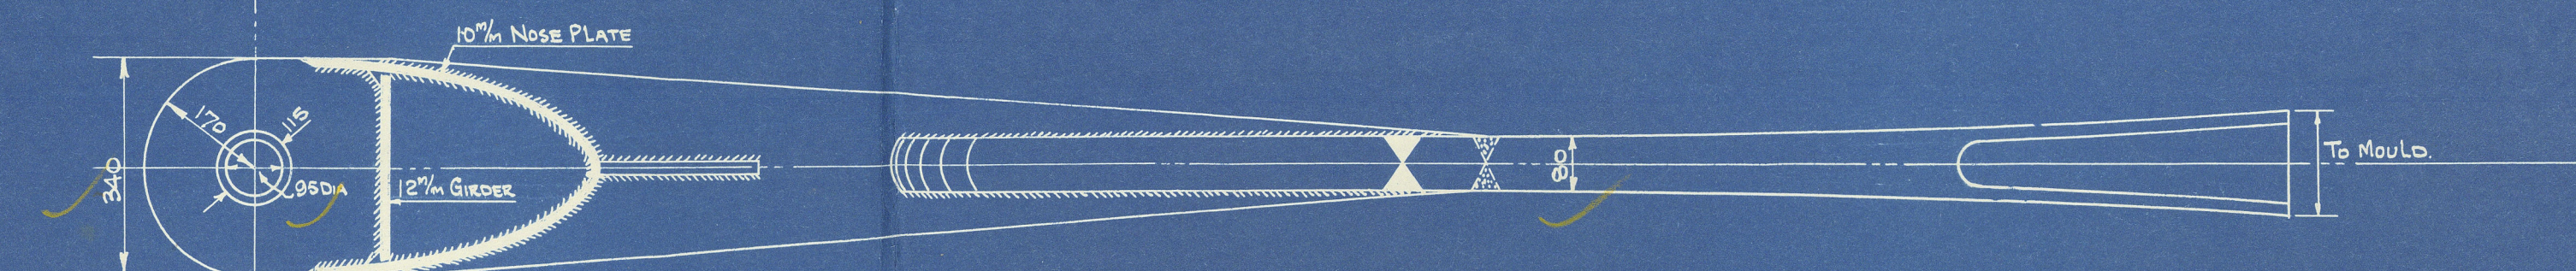
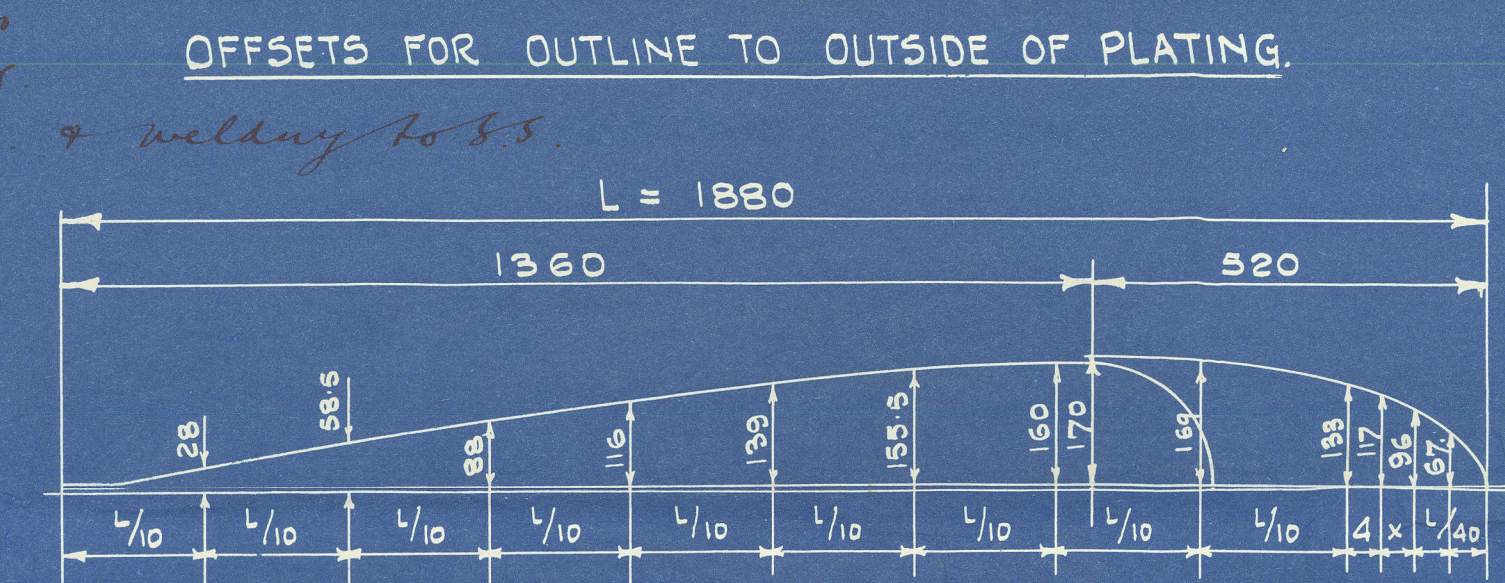
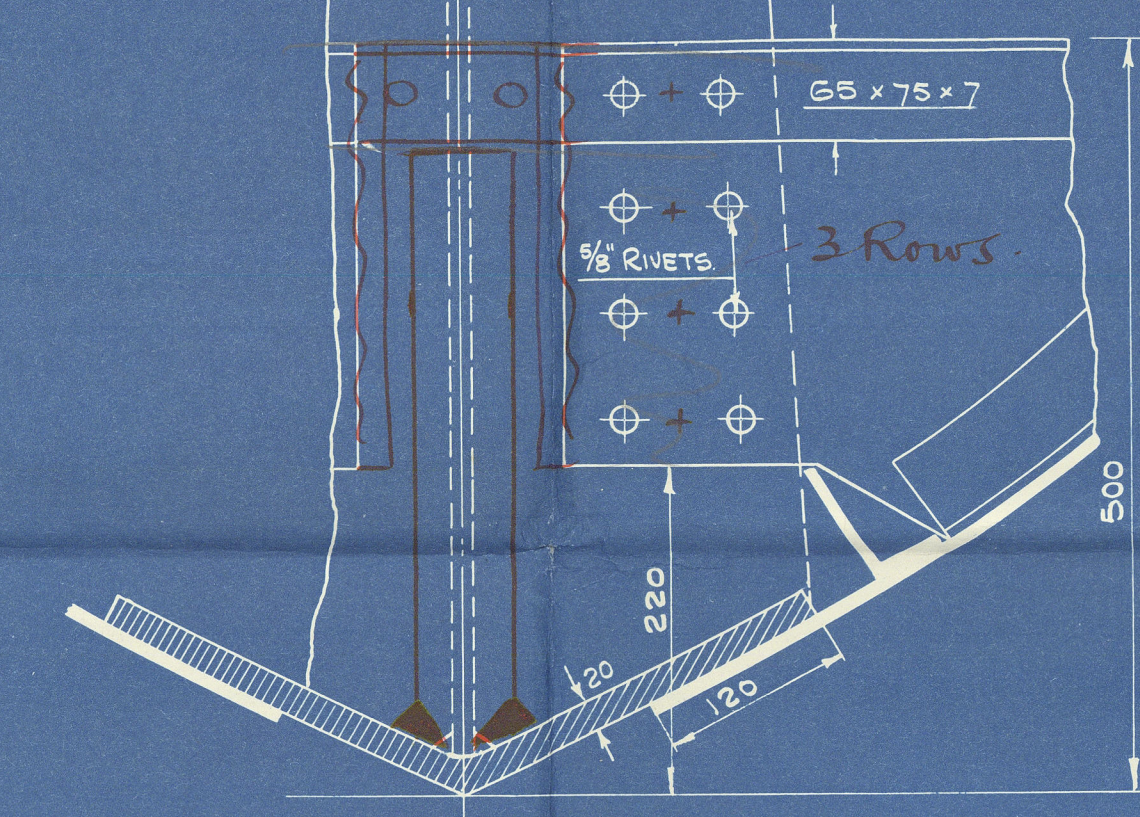
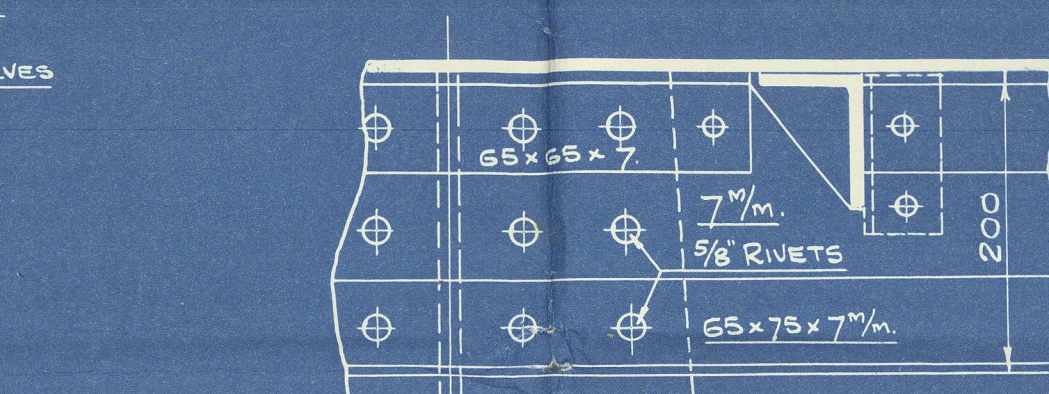
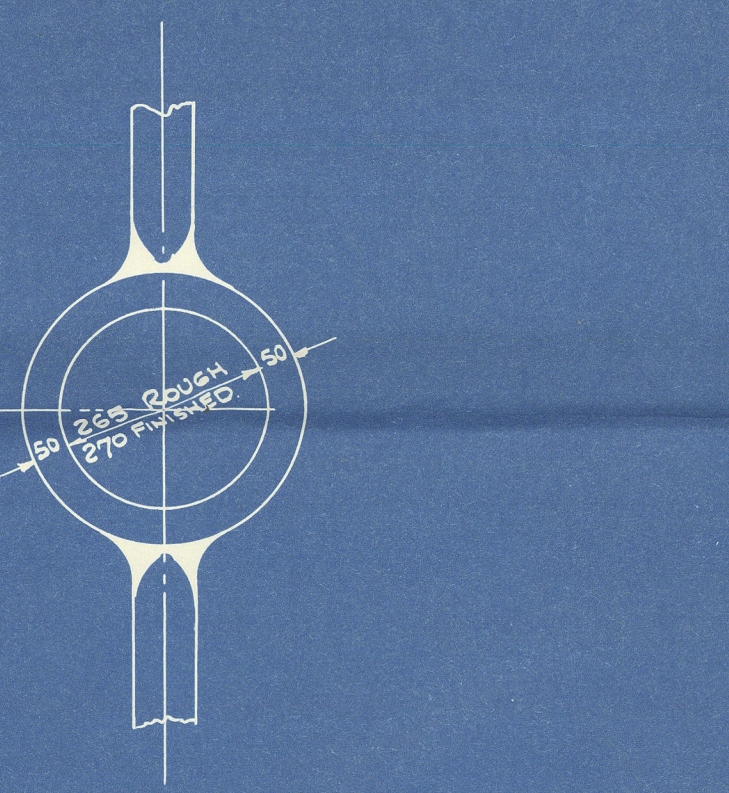
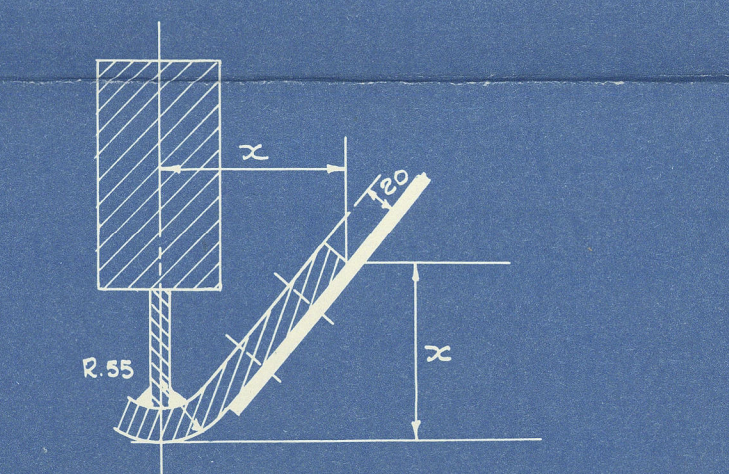
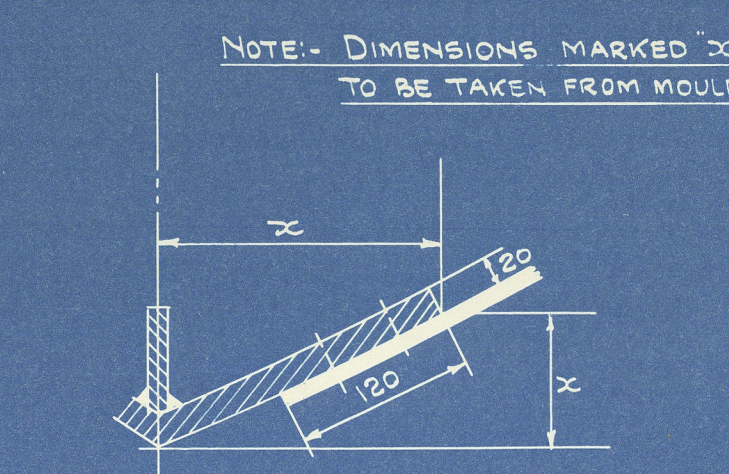
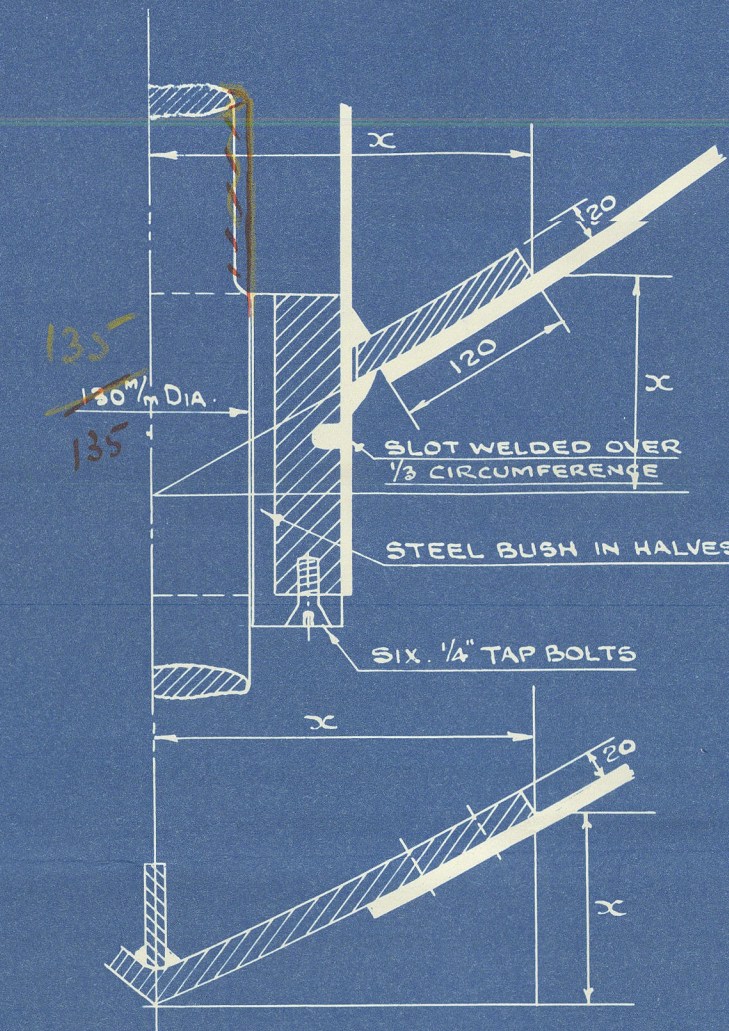
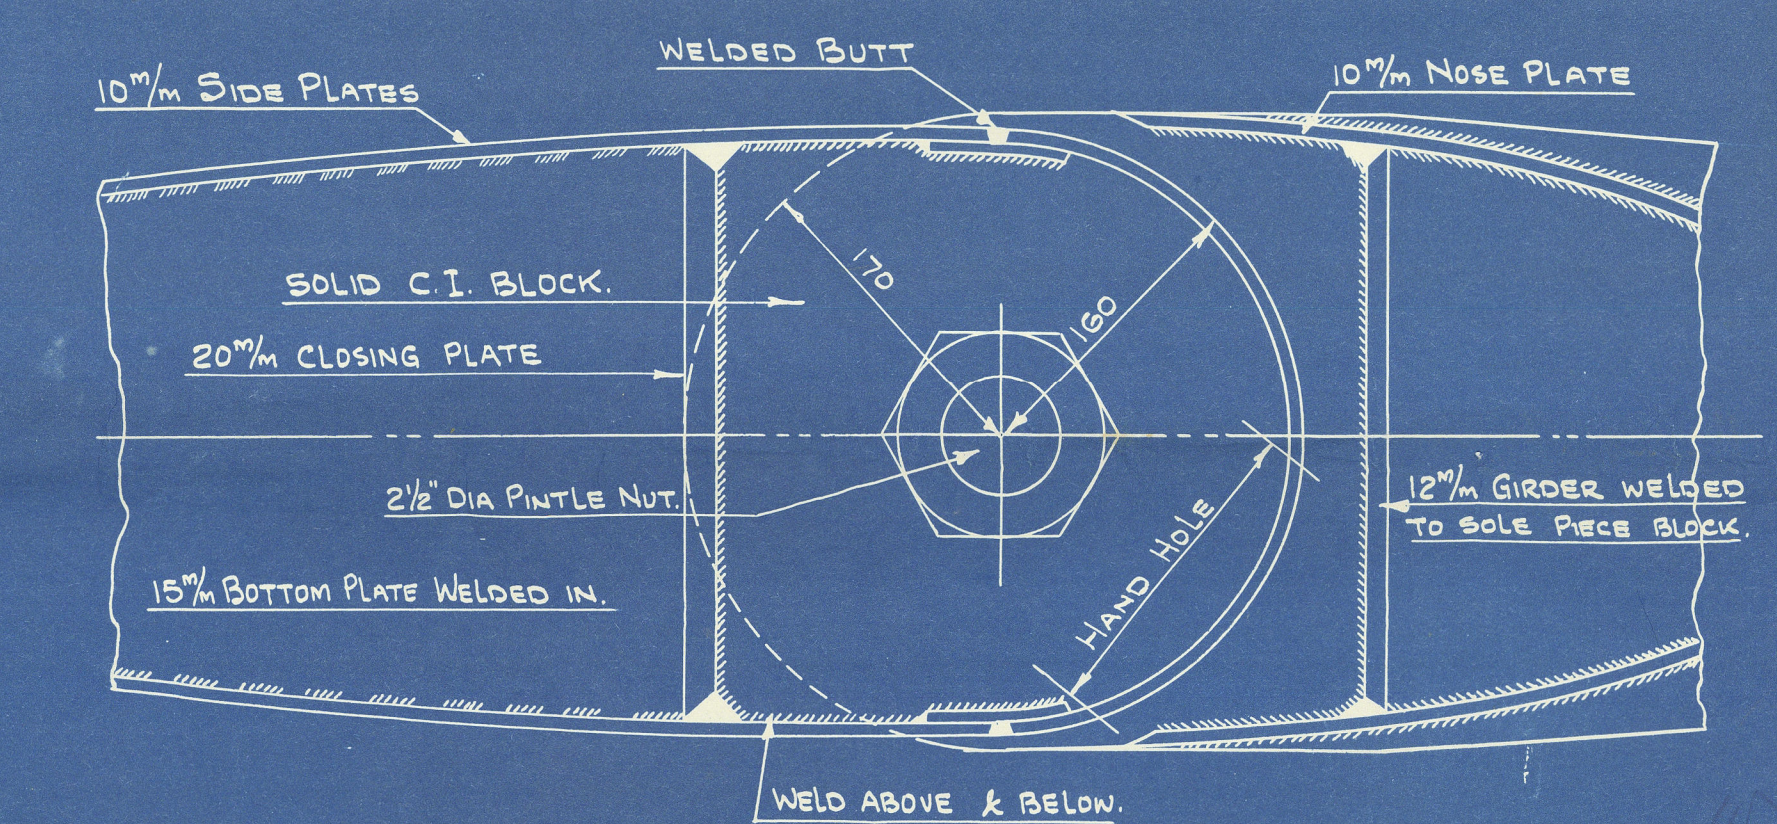
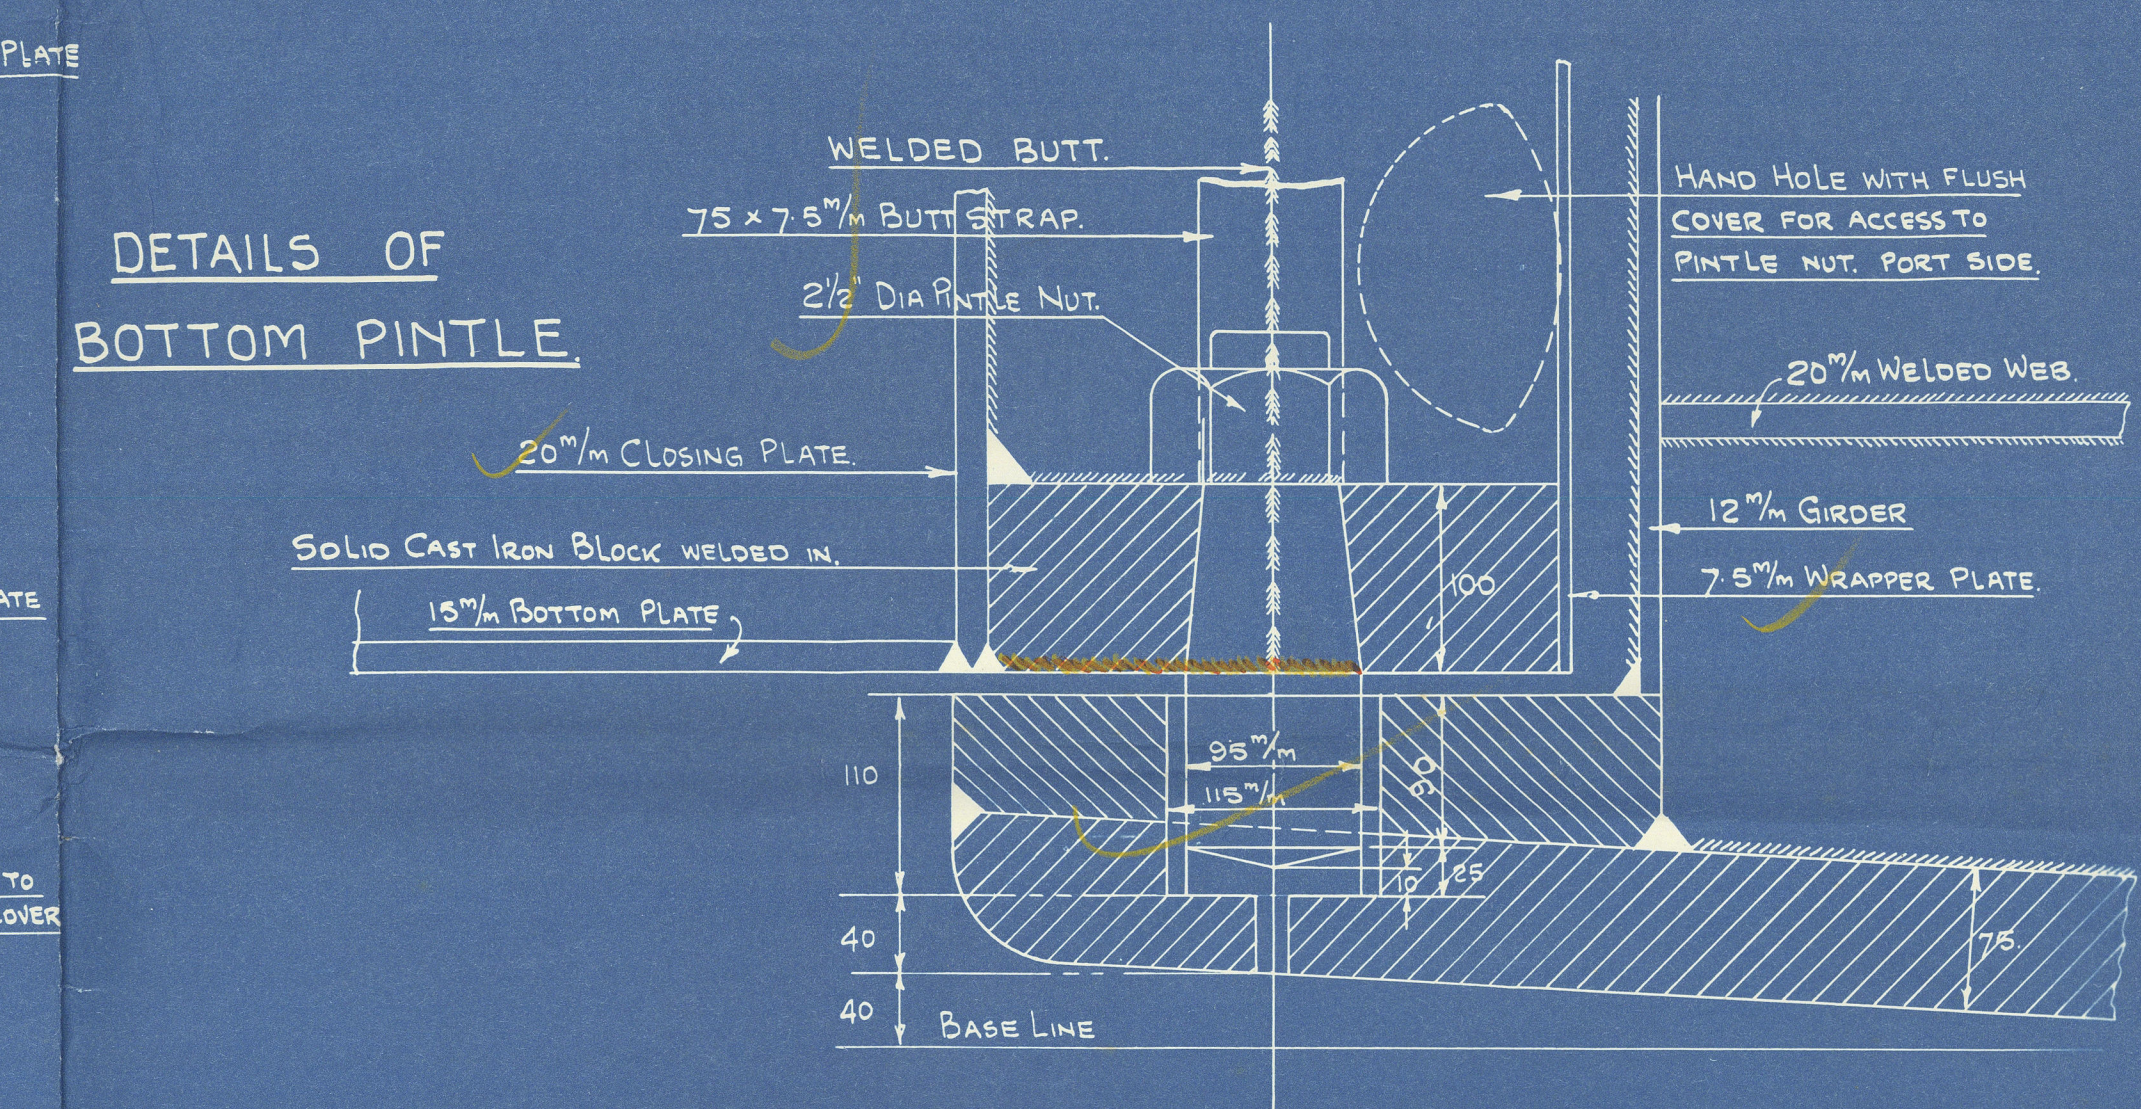
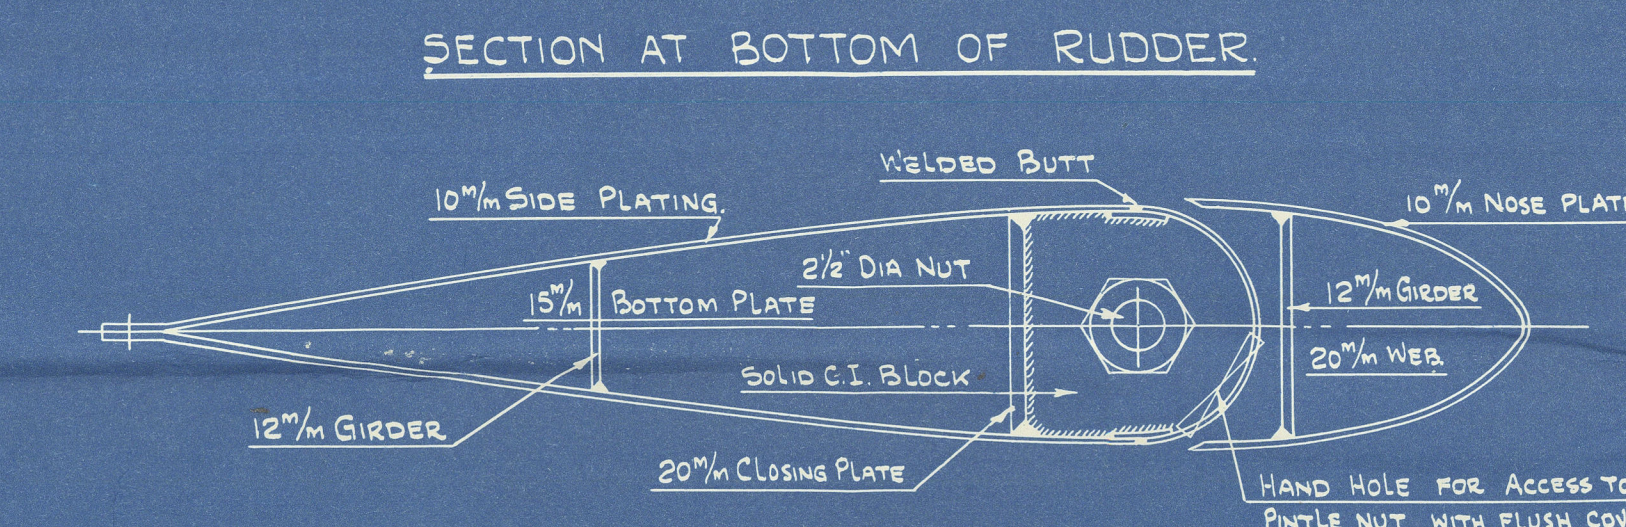
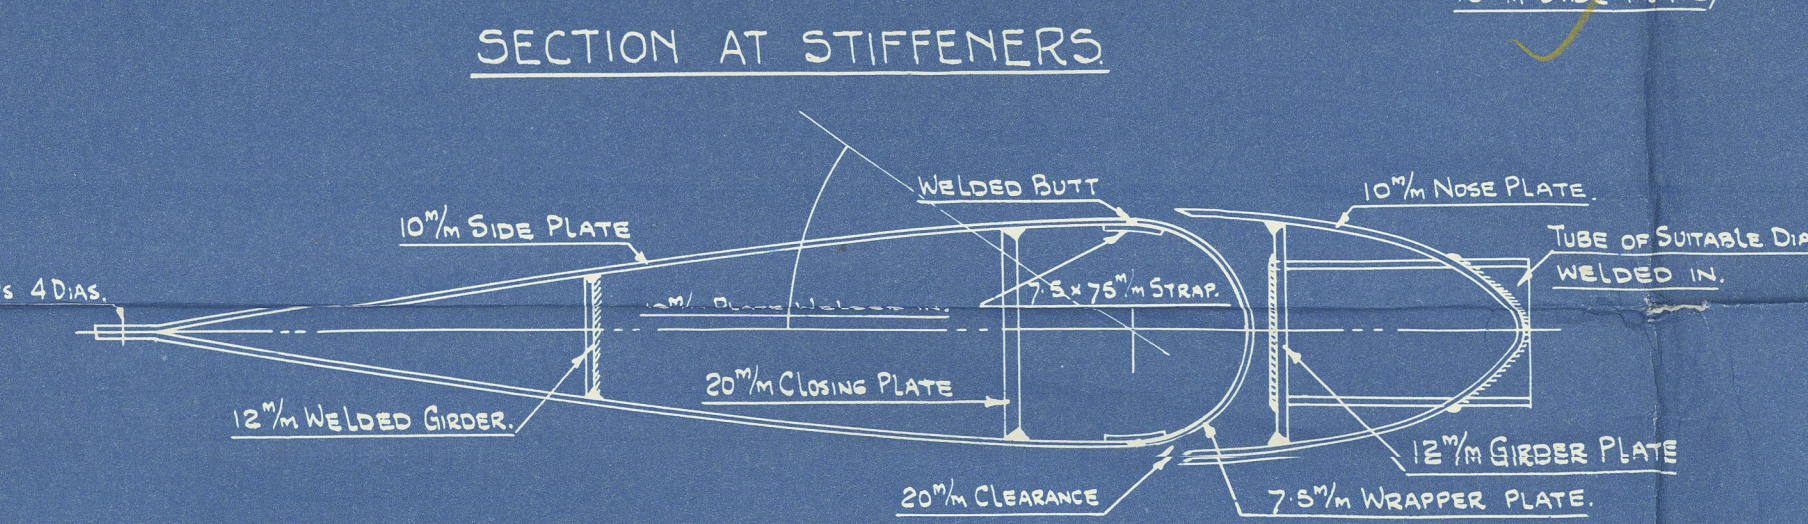
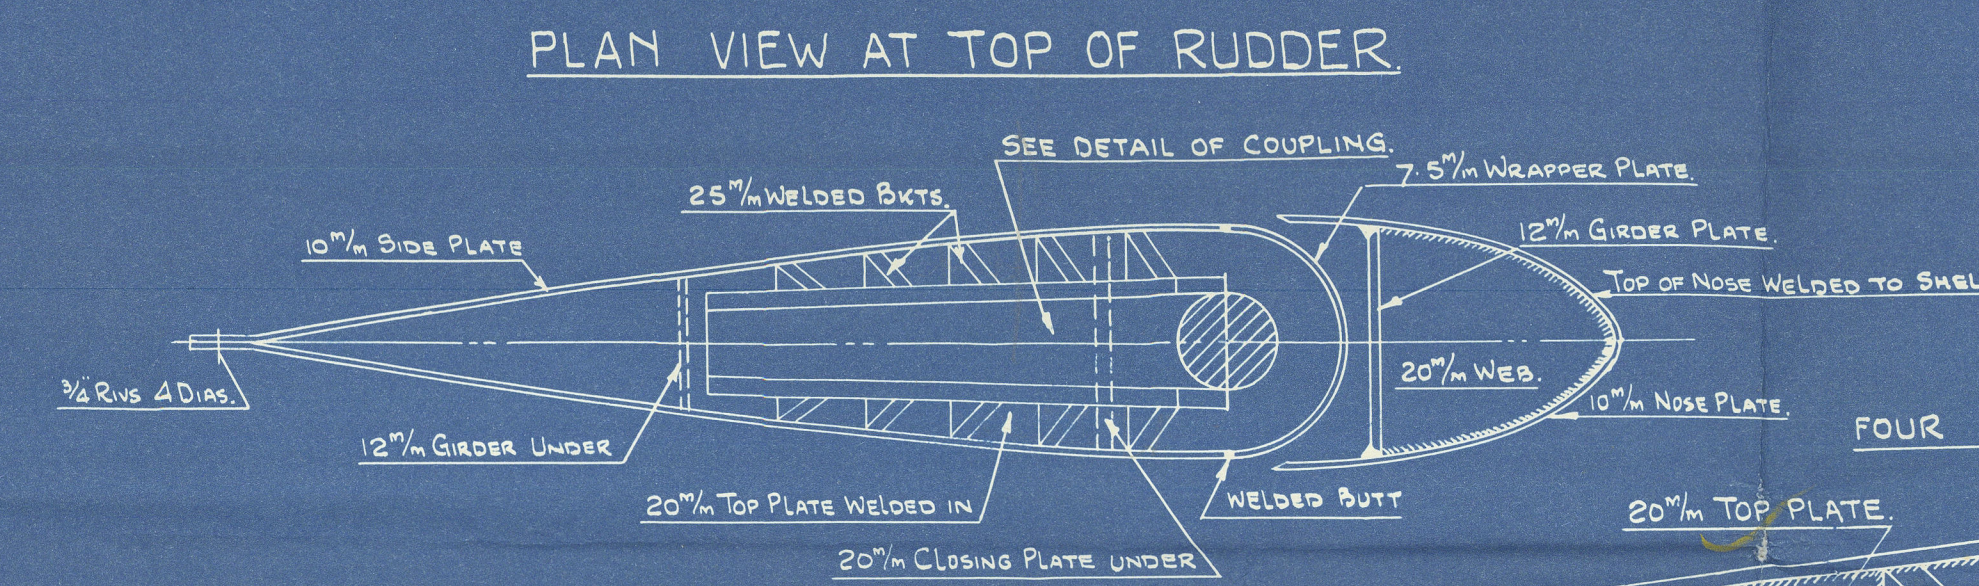
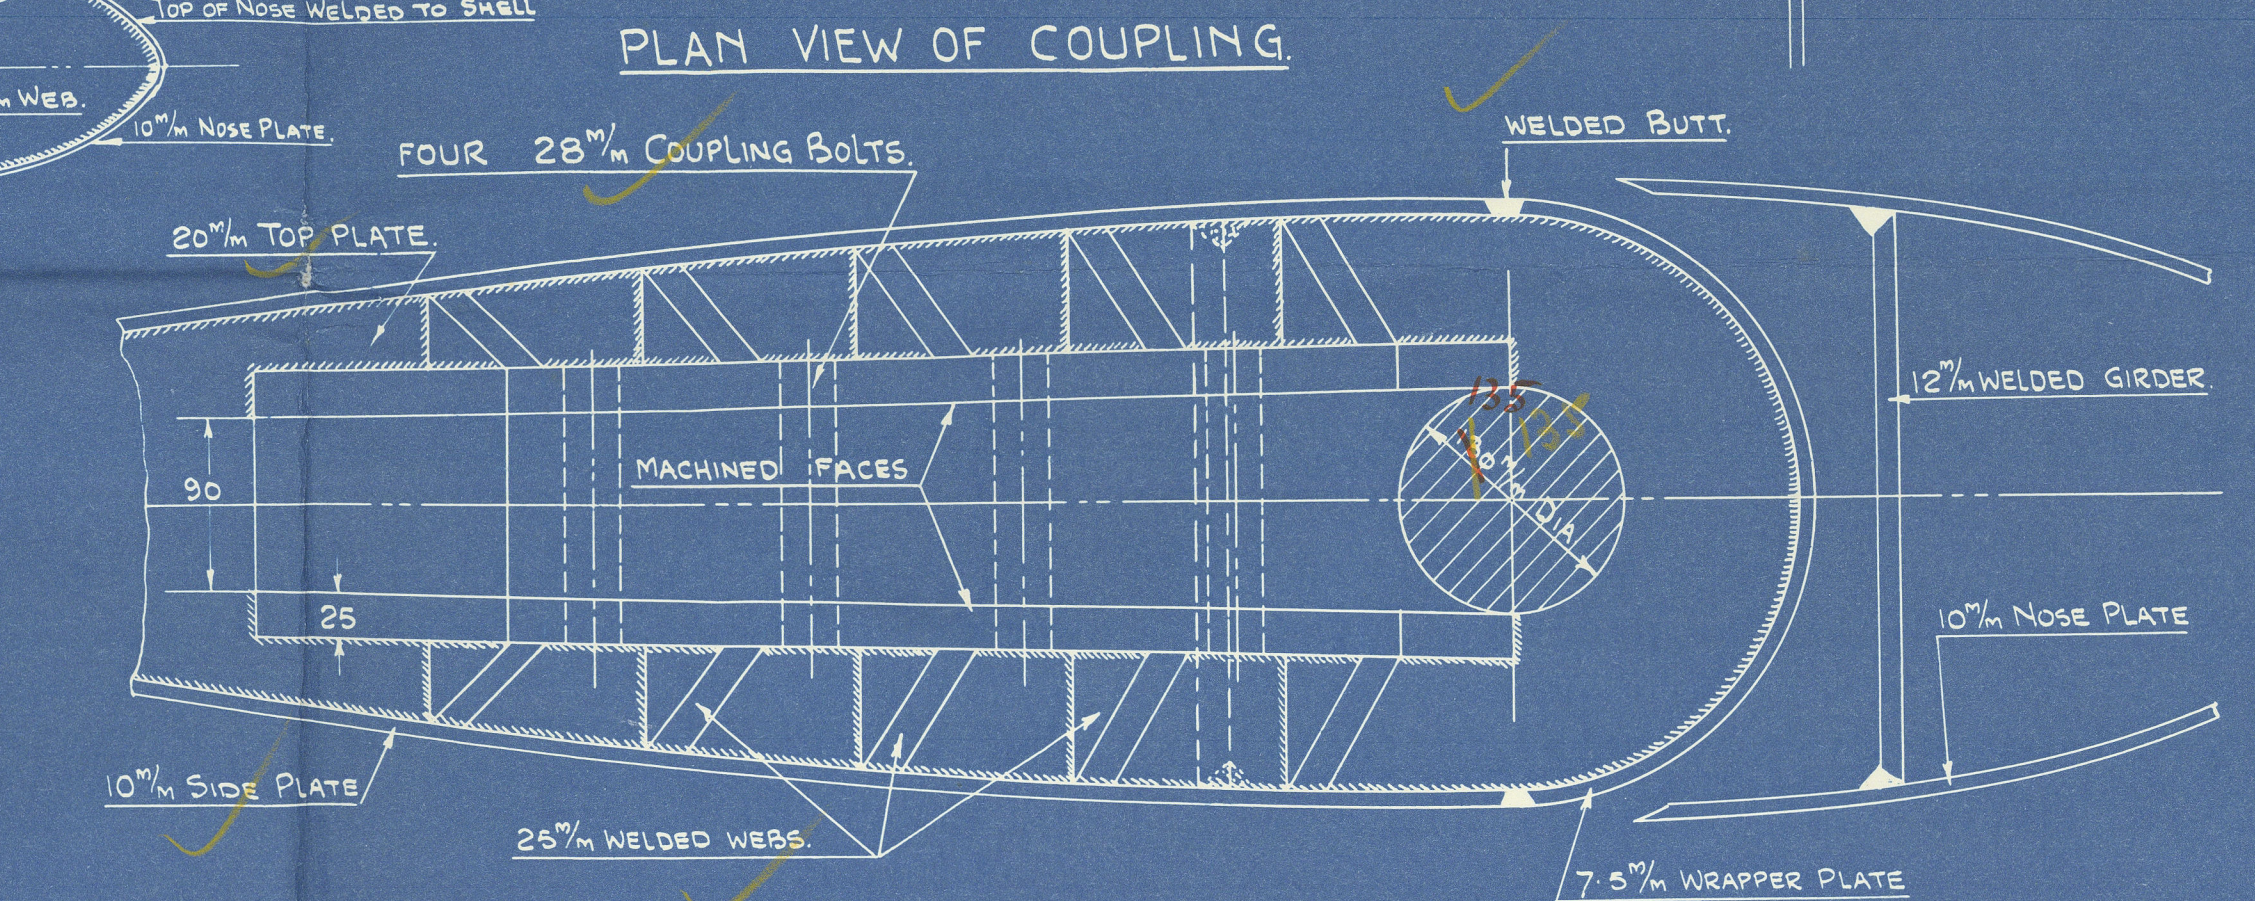


DIMENSIONS:- LENGTH 44 M. BREADTH 8 M. DEPTH 3.1 M.
DRAFT 3.05 M. MAX SPEED 9 KNOTS.

DIMENSIONS:- LENGTH 44 M. BREADTH 8 M. DEPTH 3.1 M.
DRAFT 3.05 M. MAX SPEED 9 KNOTS.

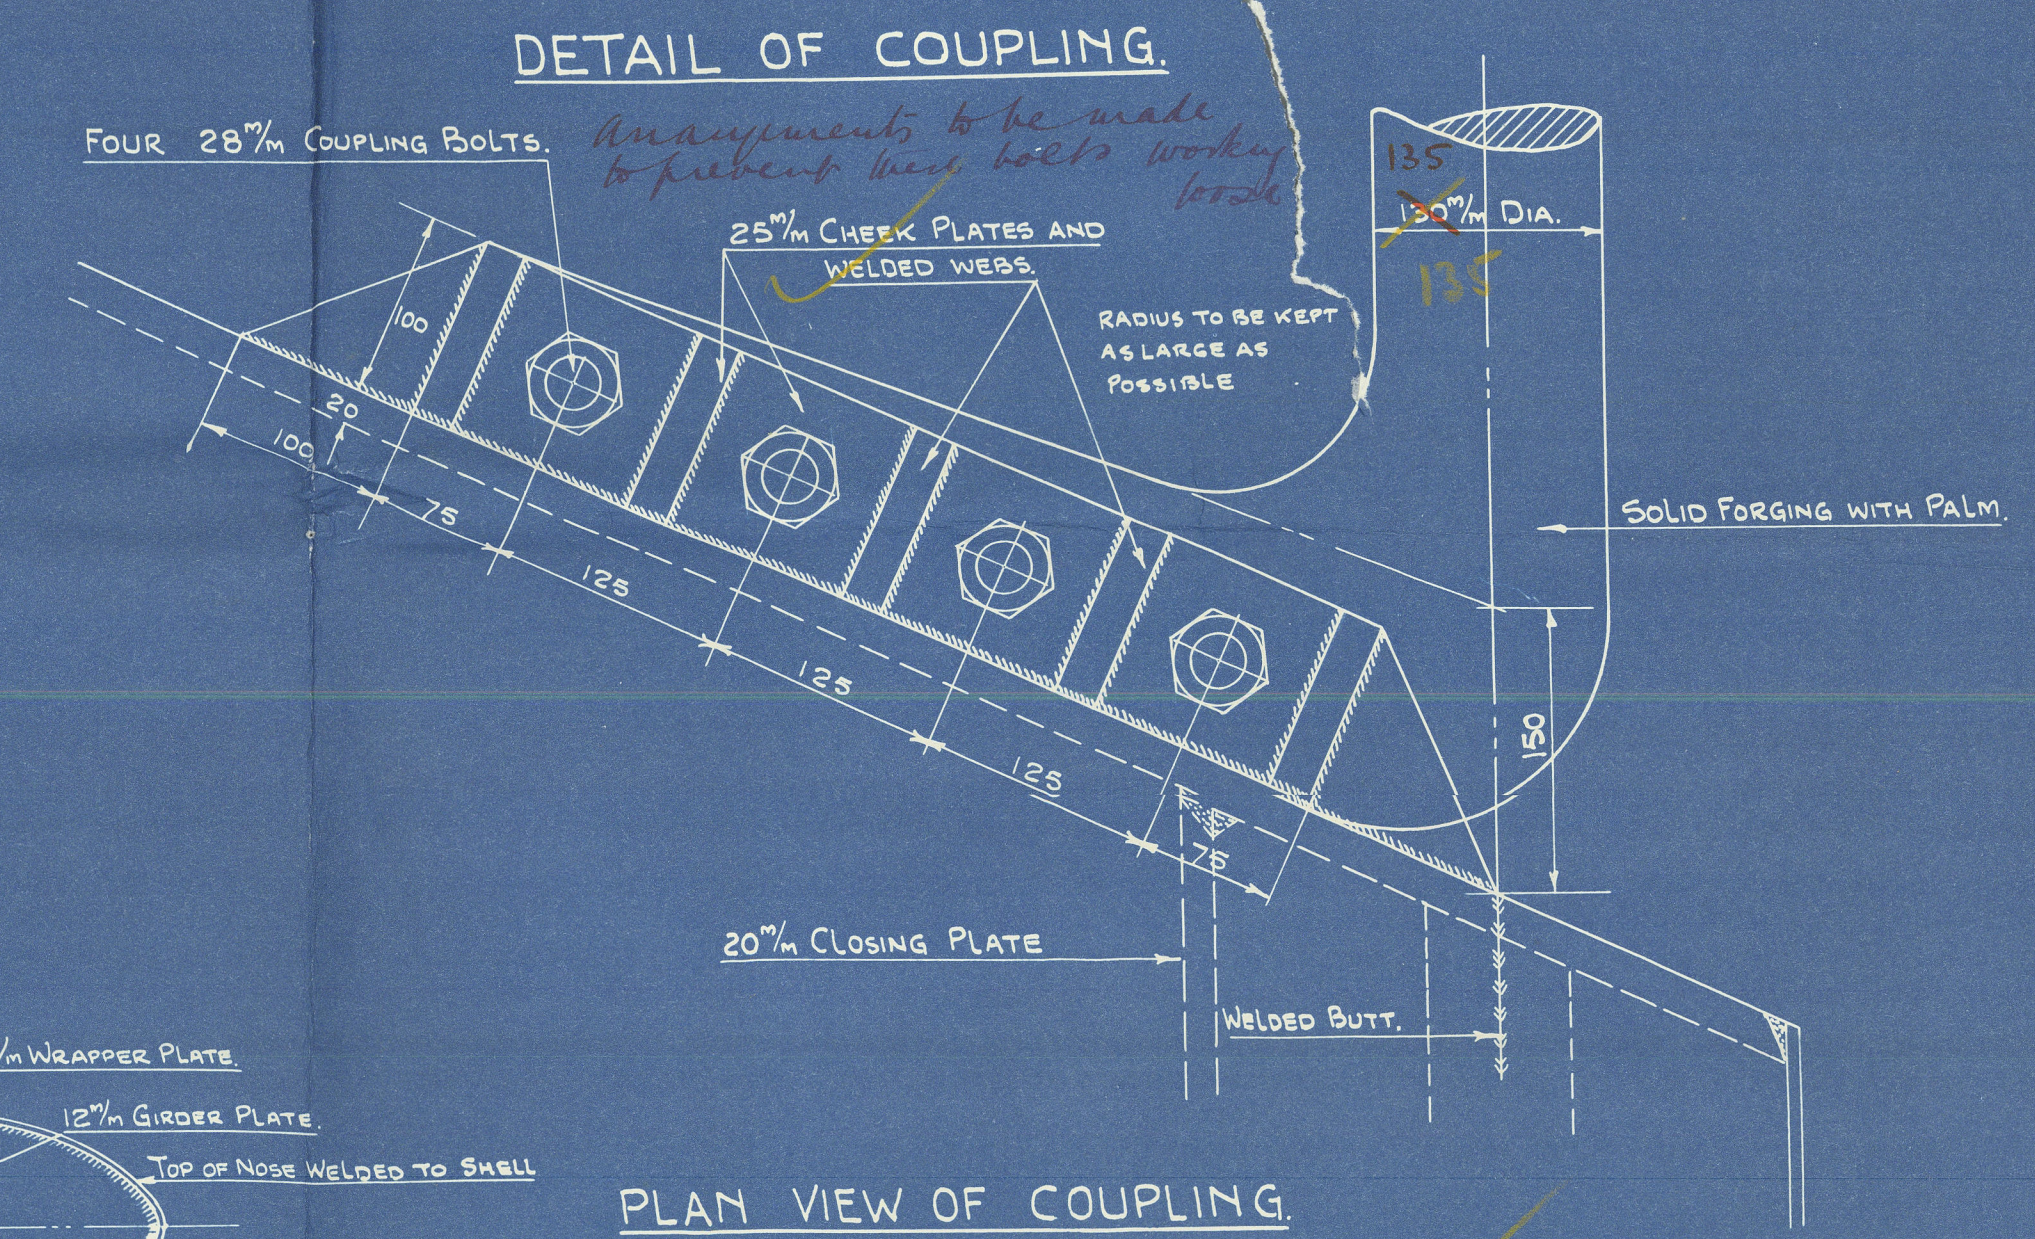

DUTCH. PAT. N° 19506.

C. 69.

59

~~729~~

112th

"Mr Luthorst Thomas"

Oerfz middel

for Van der Werf

25th