

MIDSHIP SECTION.

SCALE $\frac{1}{2}'' = 1$ FOOT.

CLASS LLOYDS 100 A.I.M.

ALL BULB ANGLES ARE NEW BRITISH STANDARD SECTIONS.

DIMENSIONS:-

LENGTH BETWEEN PERPENDICULARS 305'-0"
BREADTH MOULDED 45'-0"
DEPTH MOULDED TO UPPER DECK 23'-4 1/2"
DEPTH MOULDED TO BRIDGE DECK 30'-4 1/2"


NUMERALS:-

1st LONGITUDINAL N^o L x D = 305 x 23.375 = 7129.38
2nd LONGITUDINAL N^o L x (B+D) = 305 x (45 + 23.375) = 20,854.38
D = 23'-4 1/2" = 281.66" = 19' 10 1/2"
40 TO UPPER DECK = 305 ÷ 23.38 = 13.04
40 TO BRIDGE DECK = 305 ÷ 30.38 = 10.04
PERCENTAGE OF FRECTIONS = 39.7

EQUIPMENT.

L x (B + D) = 20,854.4
POOP 24.75 x 7.75 x 75 = 143.8
BRIDGE 68 x 7 x 75 = 357.0
FORECASTLE 28.33 x 7 x 75 = 148.7
CASING 50 x 7.75 x 5 = 193.8
SALOON HOUSE 11 x 7.5 x 5 = 41.3
EQUIPMENT N^o 21,753.0
LETTER

2 BOWER ANCHORS (Stockless) 49 cmts.
1 " " (EX. STOCK) 11 "
240 FATHOMS STUB CHAIN CABLE 1 1/8 "
15 " STREAM STEEL WIRE 4 1/2 "
100 " TONLINE " 4 "
2 @ 90 " HANGERS " 2 1/2 "
2 @ 90 " WARPS MANILLA 7 "
1 @ 90 " " 6 "

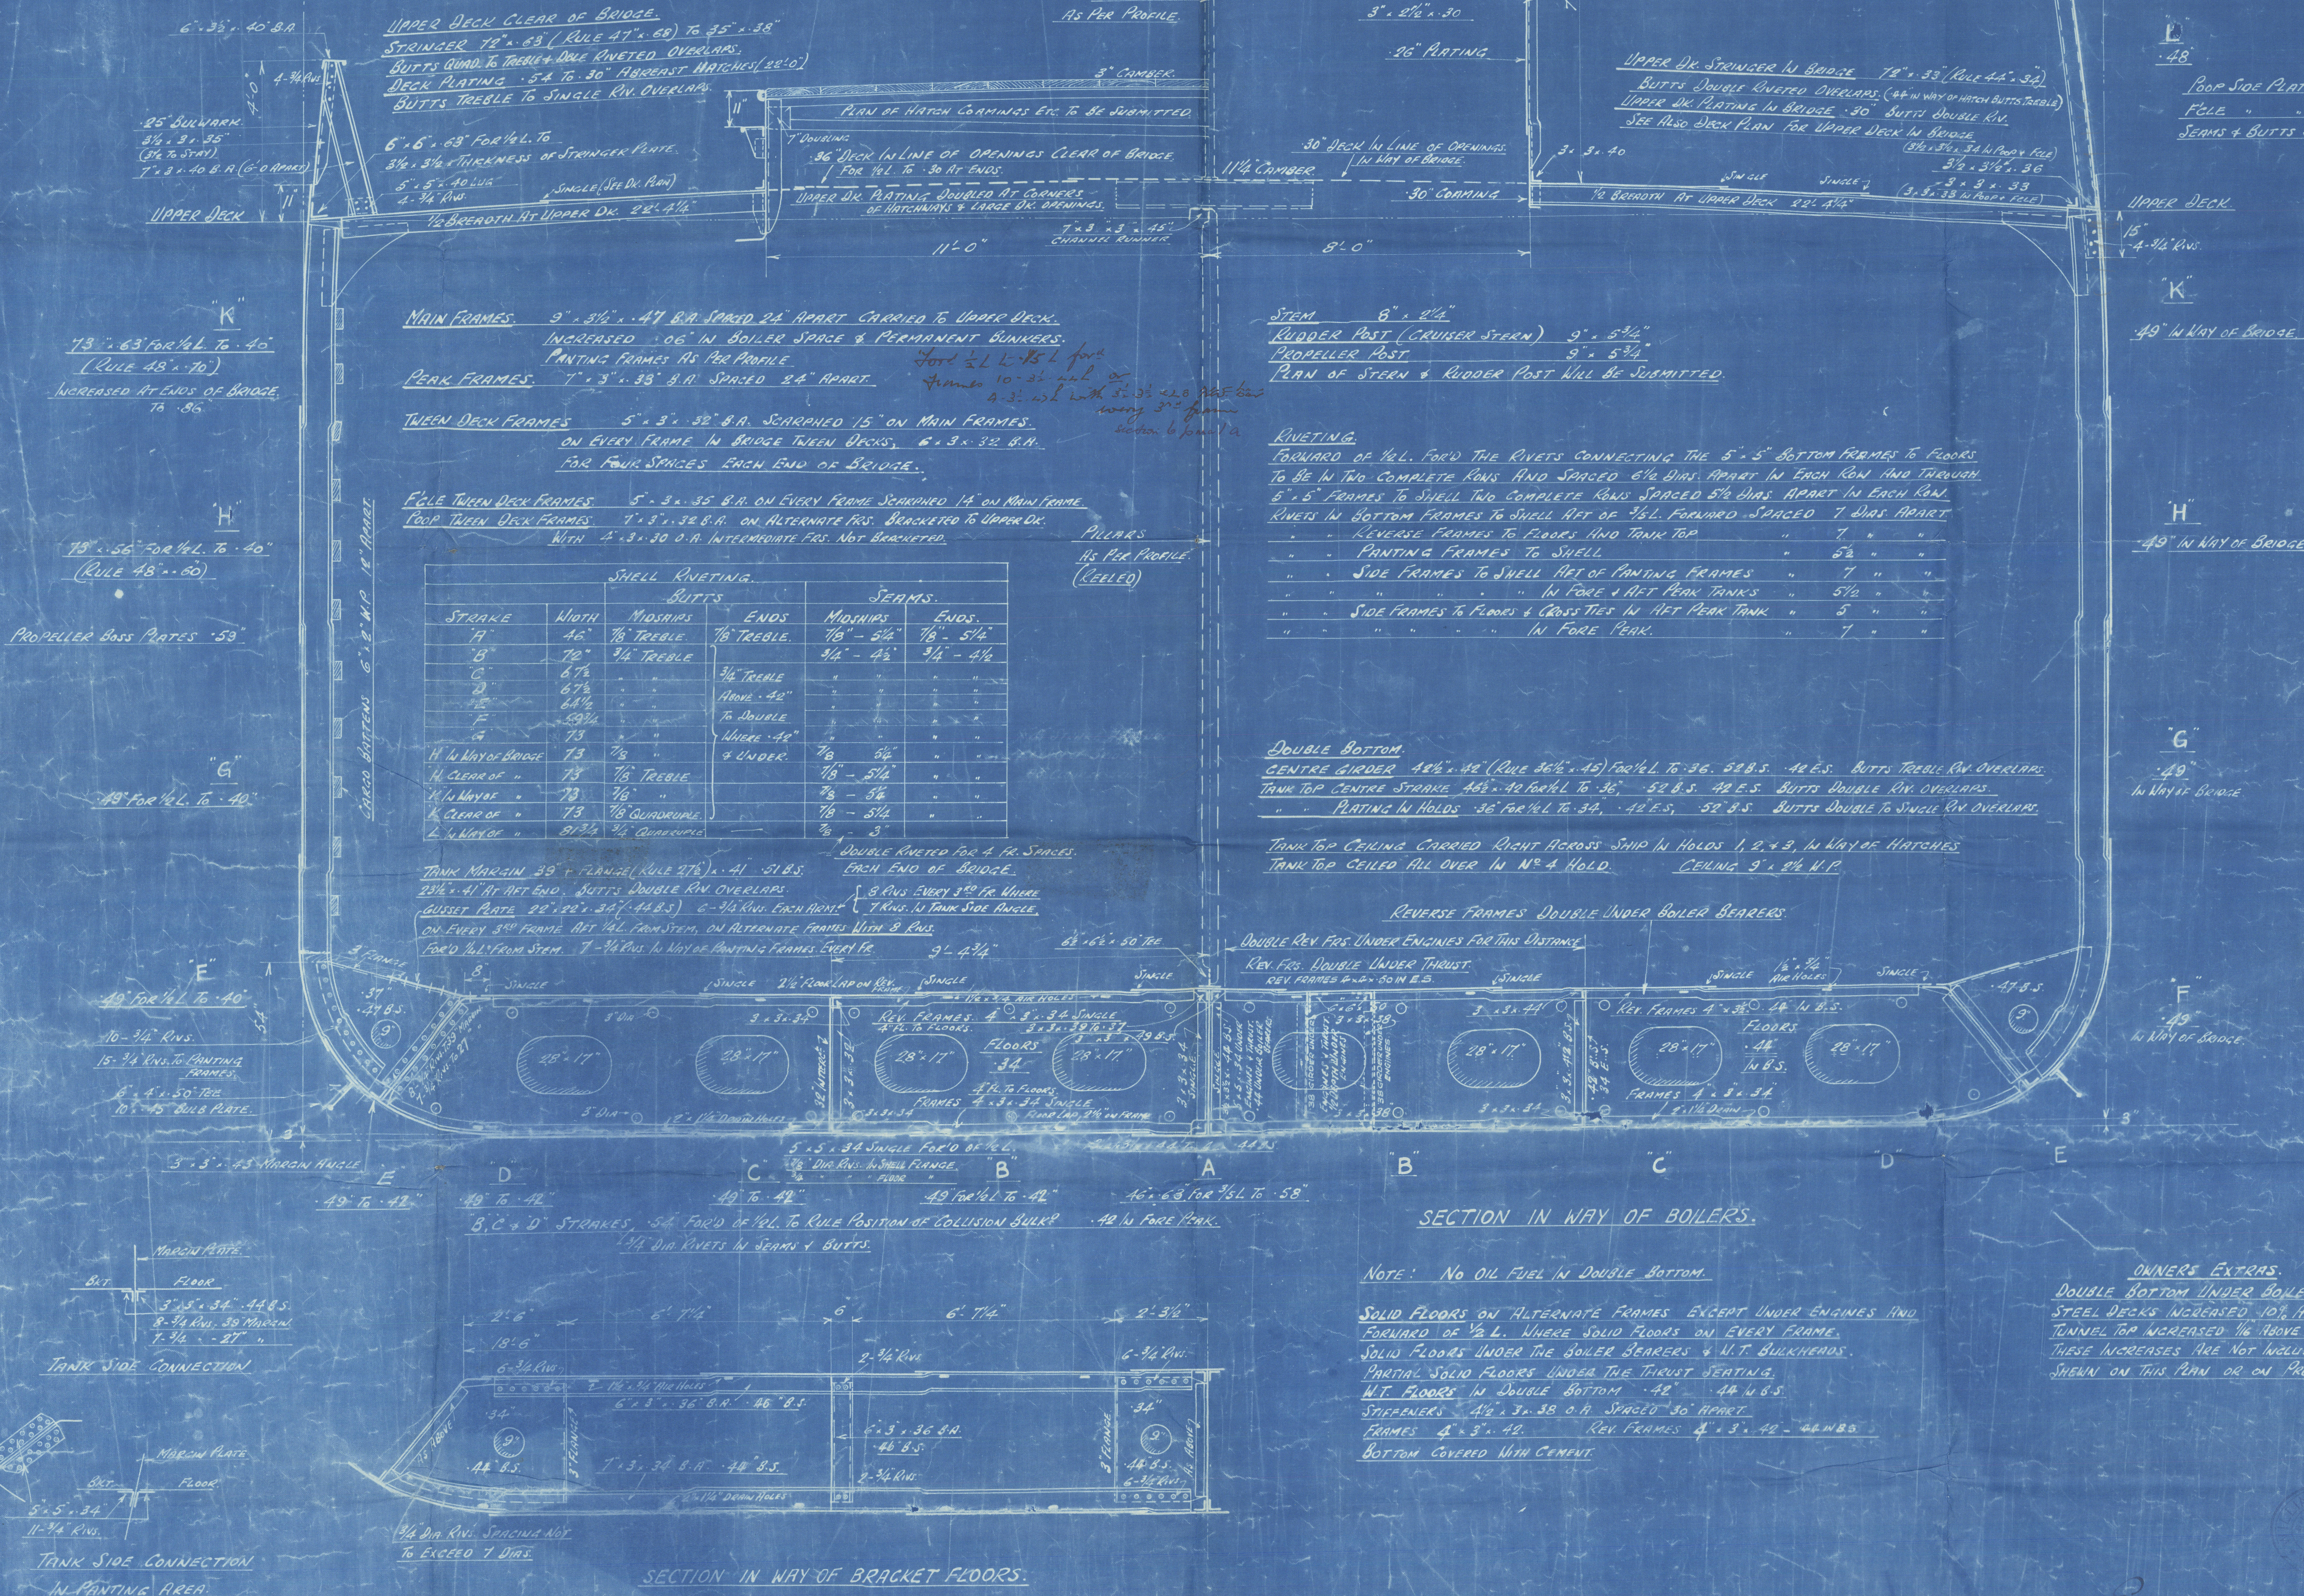

1085

1085

William Gray Mould

yard No 1085 ¹⁹⁰

①

Midship Section,

N/N "FLOREAL SECONDO"

1090

"TINTERN ABBEY"

M/M 9685

WEST HARTLEPOOL REPORT No: 17940

PLANS TRANSFERRED
TO SISTER VESSEL

Beatrice

LR

© 2021

Lloyd's Register
Foundation

009682-009688-0132