


Lloyd's Register of Shipping.
SURVEYS FOR FREEBOARD.
(CONDITIONS OF ASSIGNMENT.)

2nd 4511.
13 MAY 1942


Ship's Name R.N AIR 2A Port of Survey Northwich
Official Number _____ Surveyor's Signature M. Boylan
Nationality and Port of Registry British Admiralty Date of Survey During Construction

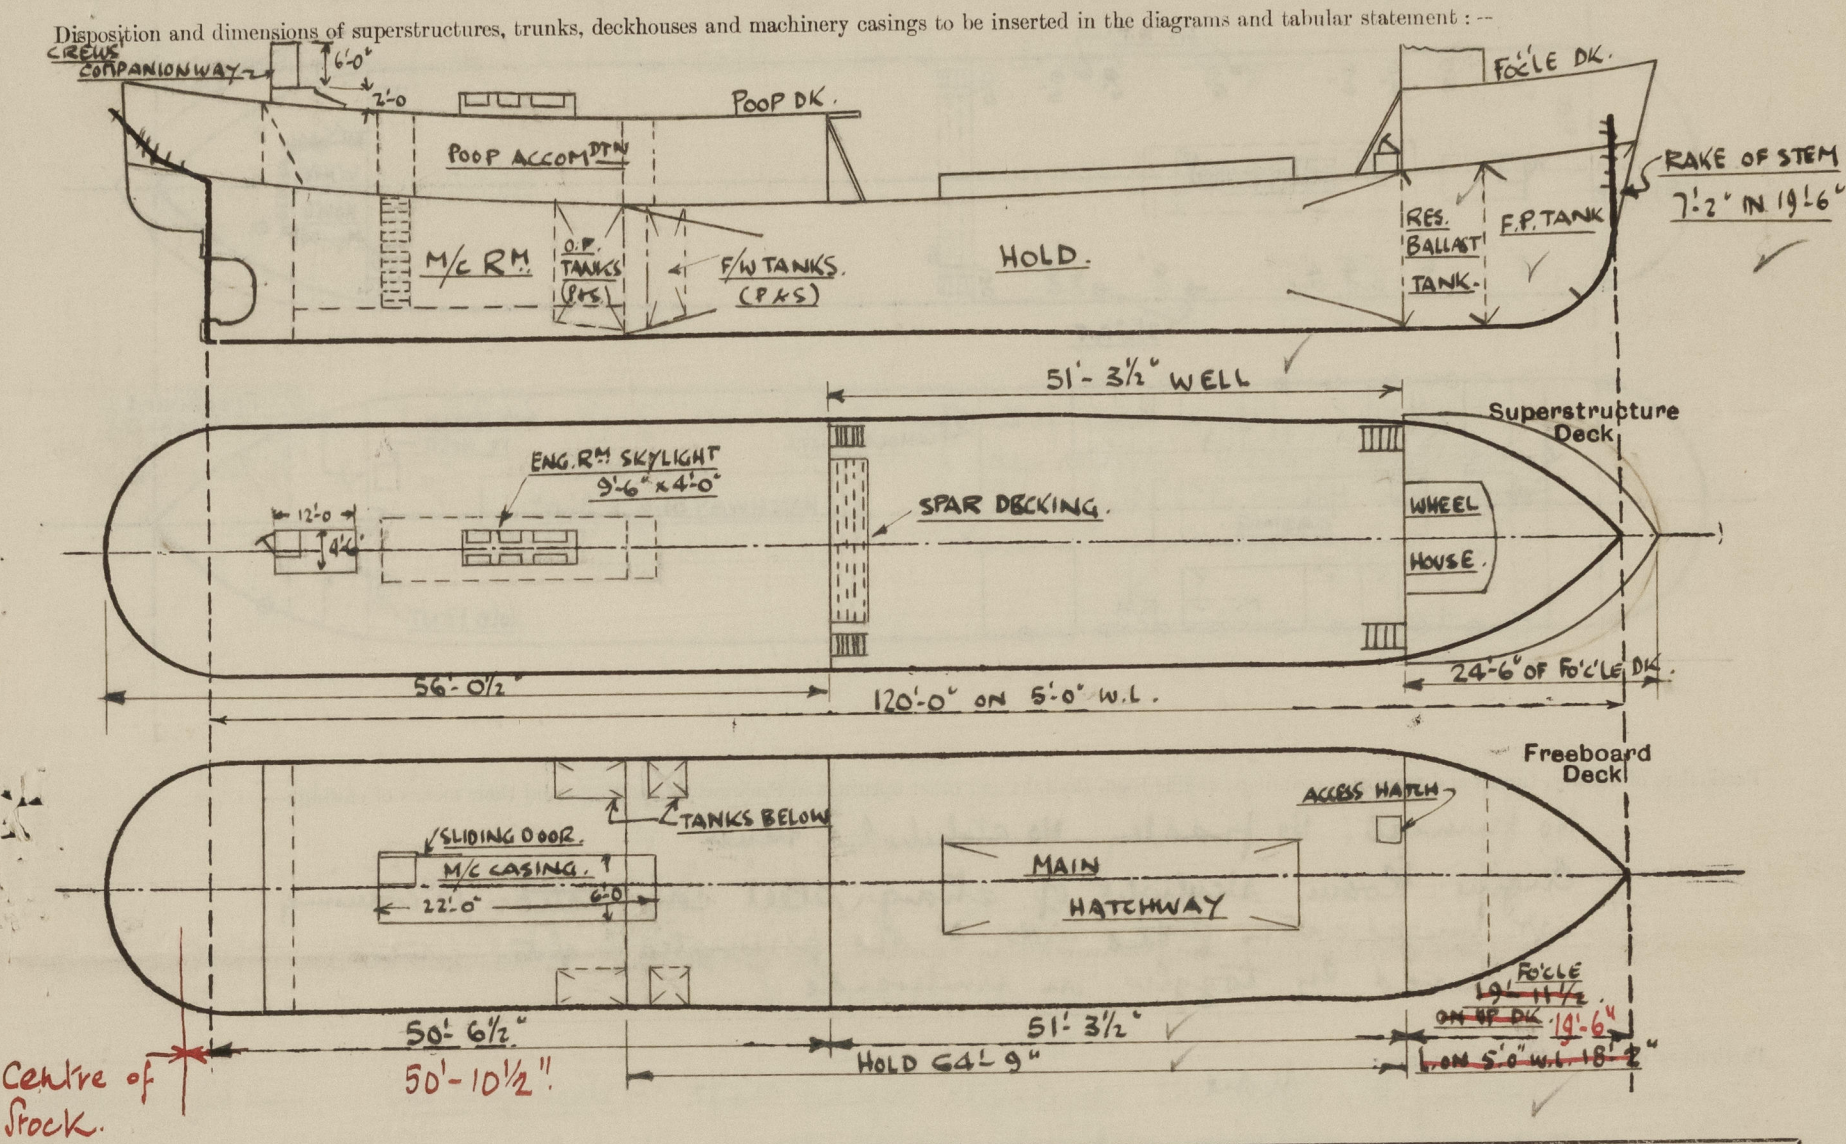

Particulars of Superstructures, Trunks, Casings, Deckhouses.								
	Coaming	Plating	Stiffeners	Spacing	End Attachments of Stiffeners	Size of Openings	Height of Sills	Height of Casings
Poop Bulkhead	32"	32"	5x3x.34 B.A.	27	LOGGED TOP & BOTTOM	4'-6" x 2'-1"	2'-0"	7'-0" ✓
Raised Quarter Deck Bulkhead ...	✓							
Bridge, After Bulkhead	✓							
Bridge, Forward Bulkhead	✓							
Forecastle Bulkhead	30"	1/4"	2 1/2 x 2 1/2 x 1/4 A.	30" & 42"	NONE	4'-6" x 2'-11"	2'-0"	6'-3" ✓
Trunk, Aft	✓							
Trunk, Forward	✓							
Exposed Machinery Casings on Freeboard or Raised Quarter Decks ...	✓							
Exposed Machinery Casings on Superstructure Decks	Engine Room skylight only. See over. ✓							
Machinery Casings within Superstructures not fitted with Class I Closing Appliances	✓							
Deckhouses on Flush Deck Ships ...	✓							

Particulars of Closing Appliances (state if capable of being manipulated from both sides).	
Poop Bulkhead	Watertight steel door (Mechan's) operated from both sides ✓
Raised Quarter Deck Bulkhead ...	✓
Bridge, After Bulkhead	✓
Bridge, Forward Bulkhead	✓
Forecastle Bulkhead	Steel weathertight door, operated from both sides - ✓
Exposed Machinery Casings on Freeboard or Raised Quarter Decks ...	✓
Exposed Machinery Casings on Superstructure Decks	✓
Machinery Casings within Superstructures not fitted with Class I Closing Appliances	✓
Deckhouses on Flush Deck Ships ...	✓

The following diagrams should be used to indicate the positions of cargo and coaling hatchways, gangway, cargo and coaling ports, ventilators, companionways, etc., which would affect the seaworthiness of the ship:—

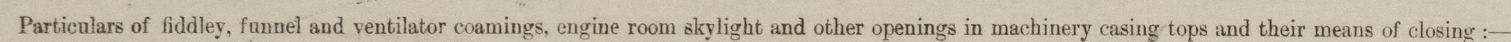

Particulars of Flush Bunker Scuttles :—

Particulars of Companionways :—

Particulars of Ventilators in exposed positions on freeboard and superstructure decks :—

Note 1

Particulars of Air Pipes in exposed positions on freeboard, raised quarter, or superstructure decks :—

- Particulars of Gangway Cargo and Coaling Ports :—

NONE

Particulars of Scuppers and Sanitary Discharge Pipes :—

Particulars of Side Scuttles:—

Vertical distance of Sill of lowest Side Scuttle above top of keel 14'-0⁵/₁₆"

Particulars of Guard Rails :—

Particulars of Gangways, Lifelines, etc. :—

© 2021
Lloyd's Register
Foundation

PARTICULARS OF PROTECTION TO OPENINGS, ETC.

HATCHWAYS ON FREEBOARD AND SUPERSTRUCTURE DECKS.									
Description of Hatchway		MAIN CARGO HATCHWAY	SMALL HATCH To Hold						
Dimensions of Hatchway		31'-6" x 8'-0"	2'-6" x 2'-6"						
COAMINGS	Height above Deck	24"	24"						
	Thickness	.38"	.38"						
	Sides	7 x 3 x 1/2" BA	✓						
	Ends	30 PLG. PLATE	✓						
	Stiffeners	5'-3" APART	✓						
	Brackets, Stays		✓						
HATCH BEAMS	Number	5							
	Spacing	5'-3"							
	Scantling and Sketch	3" x 3" x .38" 2	10"						
	Bearing Surface	2" x 1" CONVEX	3"						
FORE AND AFTERS	Number	7	7						
	Spacing								
	Unsupported Lengths								
	Scantling and Sketch								
	Bearing Surface								
HATCH COVERS	Material	FIR	W/T. HINGED						
	Thickness	2 1/2"	STEEL						
	How fitted	F.A.A.	COVER						
	Bearing Surface	3							
Spacing of Cleats		24"	2 TOGGLES						
Number of Tarpaulins		2	EACH SIDE.						

*Are wood fore and afters steel shod at all bearing surfaces? ☒

Are battens and wedges efficient and in good condition? ☒ YES.

Are tarpaulins in good condition and in accordance with rule requirements? ☒ YES.

Are lashings provided in accordance with rule requirements? ☒ Hatch locking bars fitted to main hatch.

Particulars of any special features:—

Special Type of Vessel for carrying
Aircraft on Deck. ✓

omit

Endorsement at first survey and at surveys for renewal of Certificate:—

The fittings and appliances are in accordance with the particulars shown on this form (or as now modified) and are in good condition.



© 2021

Lloyd's Register
Foundation