

14 JAN 1942

32714


Lloyd's Register of Shipping.

Ship's Name "INNESMOOR"

Official No. 160474.

Memorandum of alterations reported since ship was surveyed for assignment of Load Lines in

UPPER DECK (AFT.) - 35" steel companionway built on top of after hatchway, starboard side, 4 ft. (F&A) x 5 ft. (ATW^{9"}) x 3'-10" above hatch coaming. Companionway electrically welded to hatch coaming and hatch web. Hinged steel doorway - 3'-7" x 2'-0" - sill 2'-8" above steel deck. Door operated from both sides. Cleats provided on sides of companionway for bolting of hatchway.

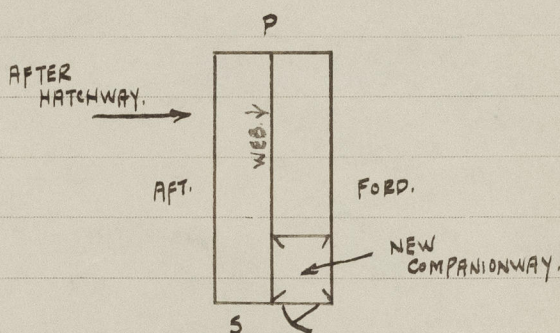

TWEEN DECK (AFT.) STARBOARD SIDE - 5 extra side scuttles fitted on ship's side, 9" diam. with hinged deadlights. Storm Valve B.W.C. fitted above 2nd Deck, through ship's side.

R. M. Scott,
Greenock,
5/1/42.