
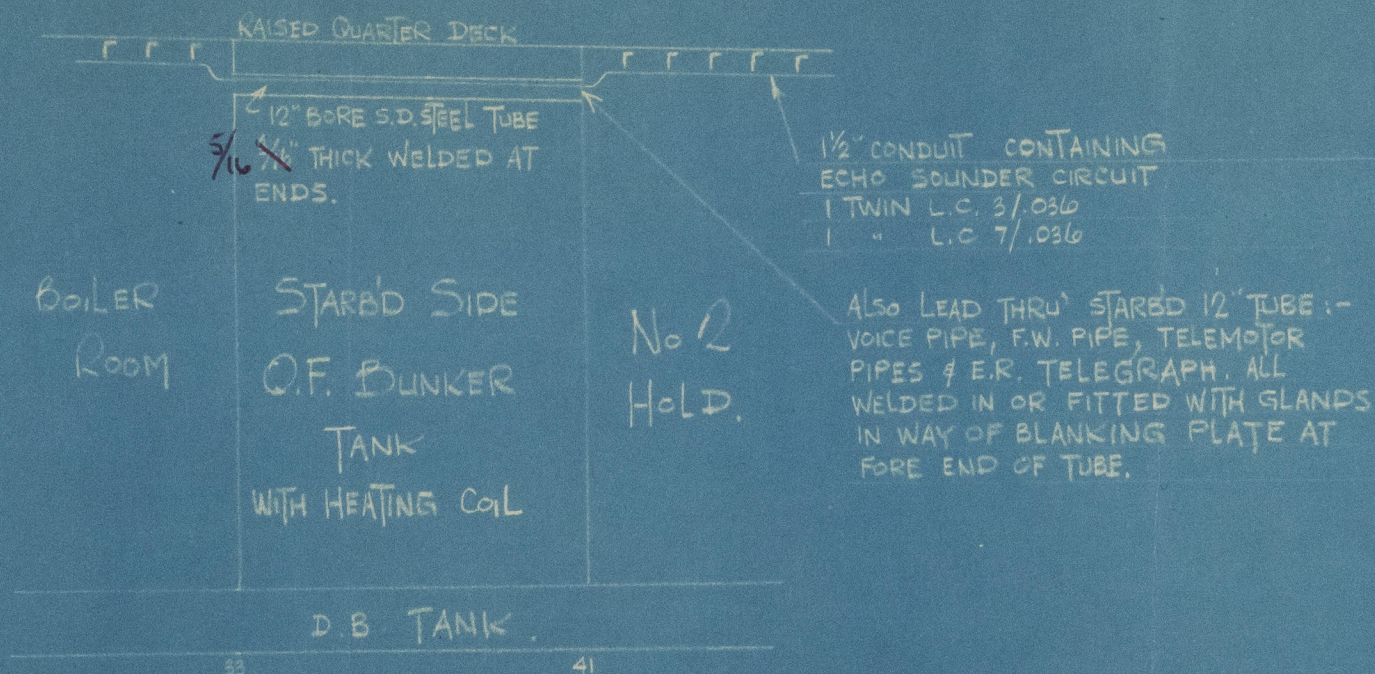


S/S "HOLMSIDE"

ELECTRICAL LEADS FROM E.R. TO MIDSHIP HOUSE

THROUGH OIL FUEL BUNKER TANKS P. & S.

23 MAR 1956

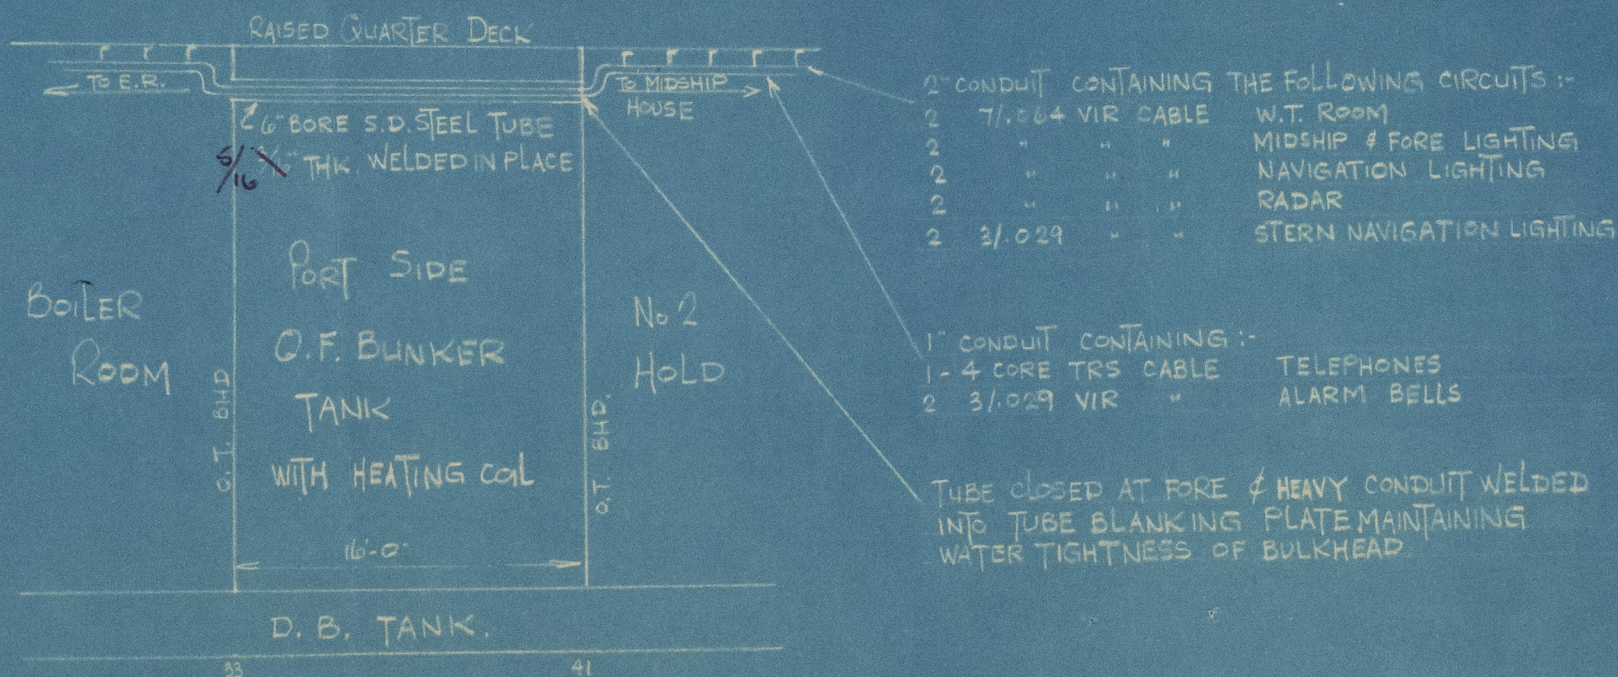

HOLMSIDE B. 20705

SMITHS Dock Co. LTD

SOUTH BANK-ON-TEES

15/3/56 R.L.A.



© 2073/56

Lloyd's Register
Foundation

009789-009795-0079