
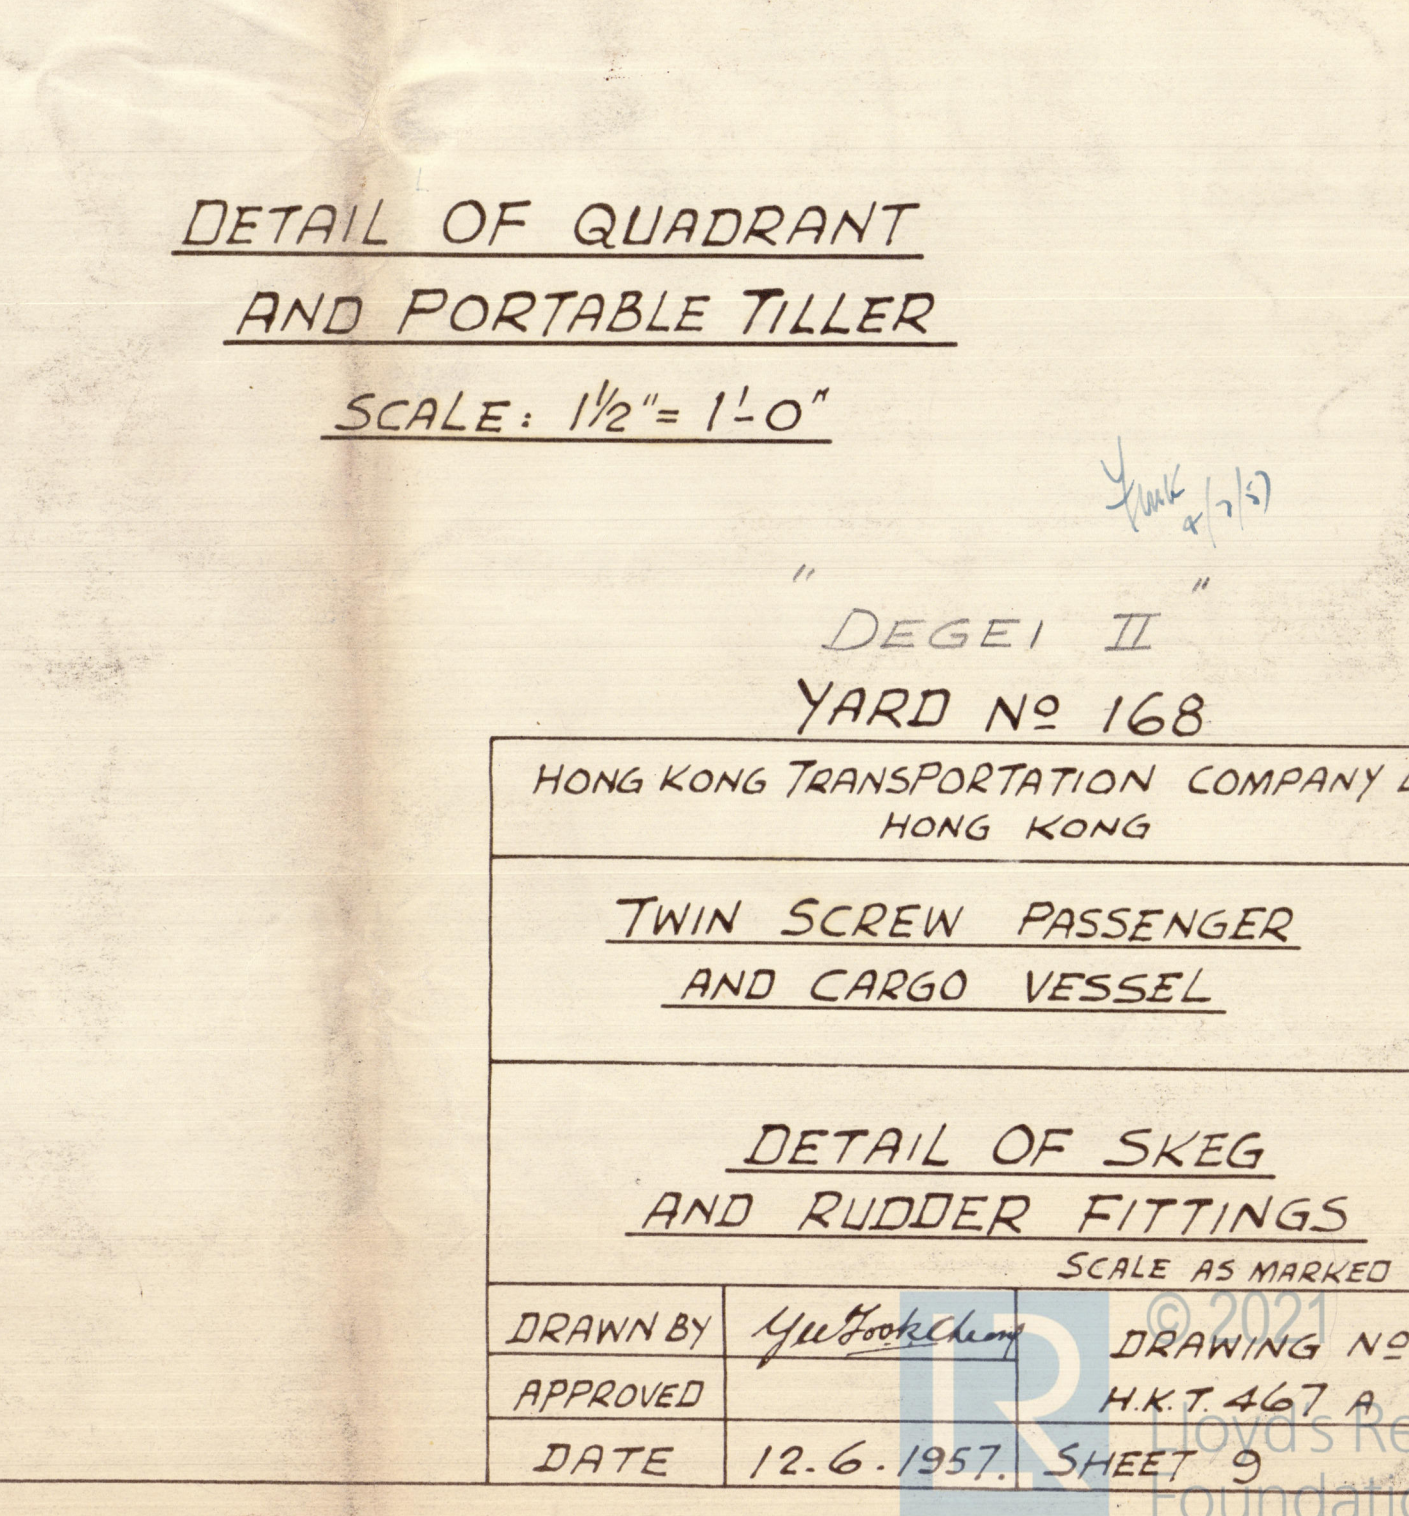
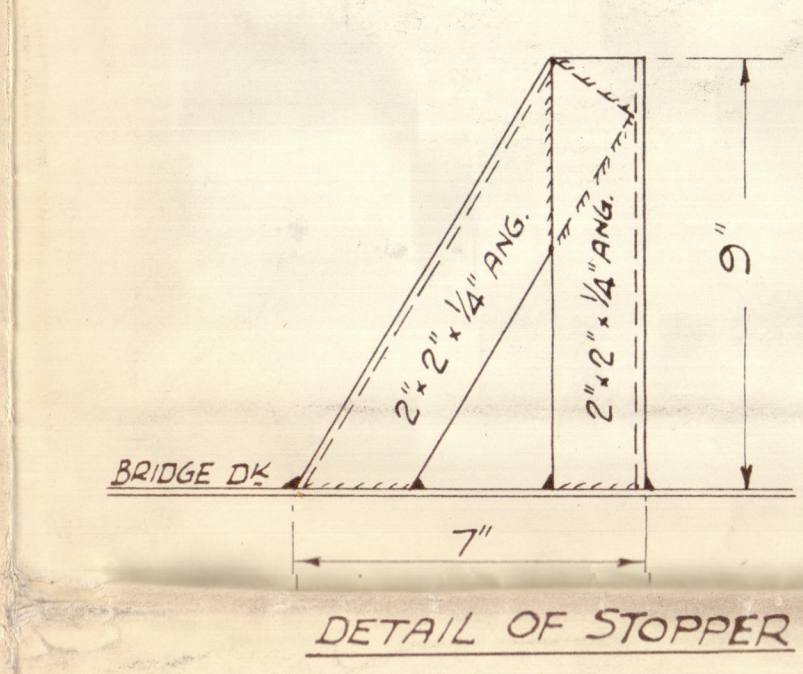
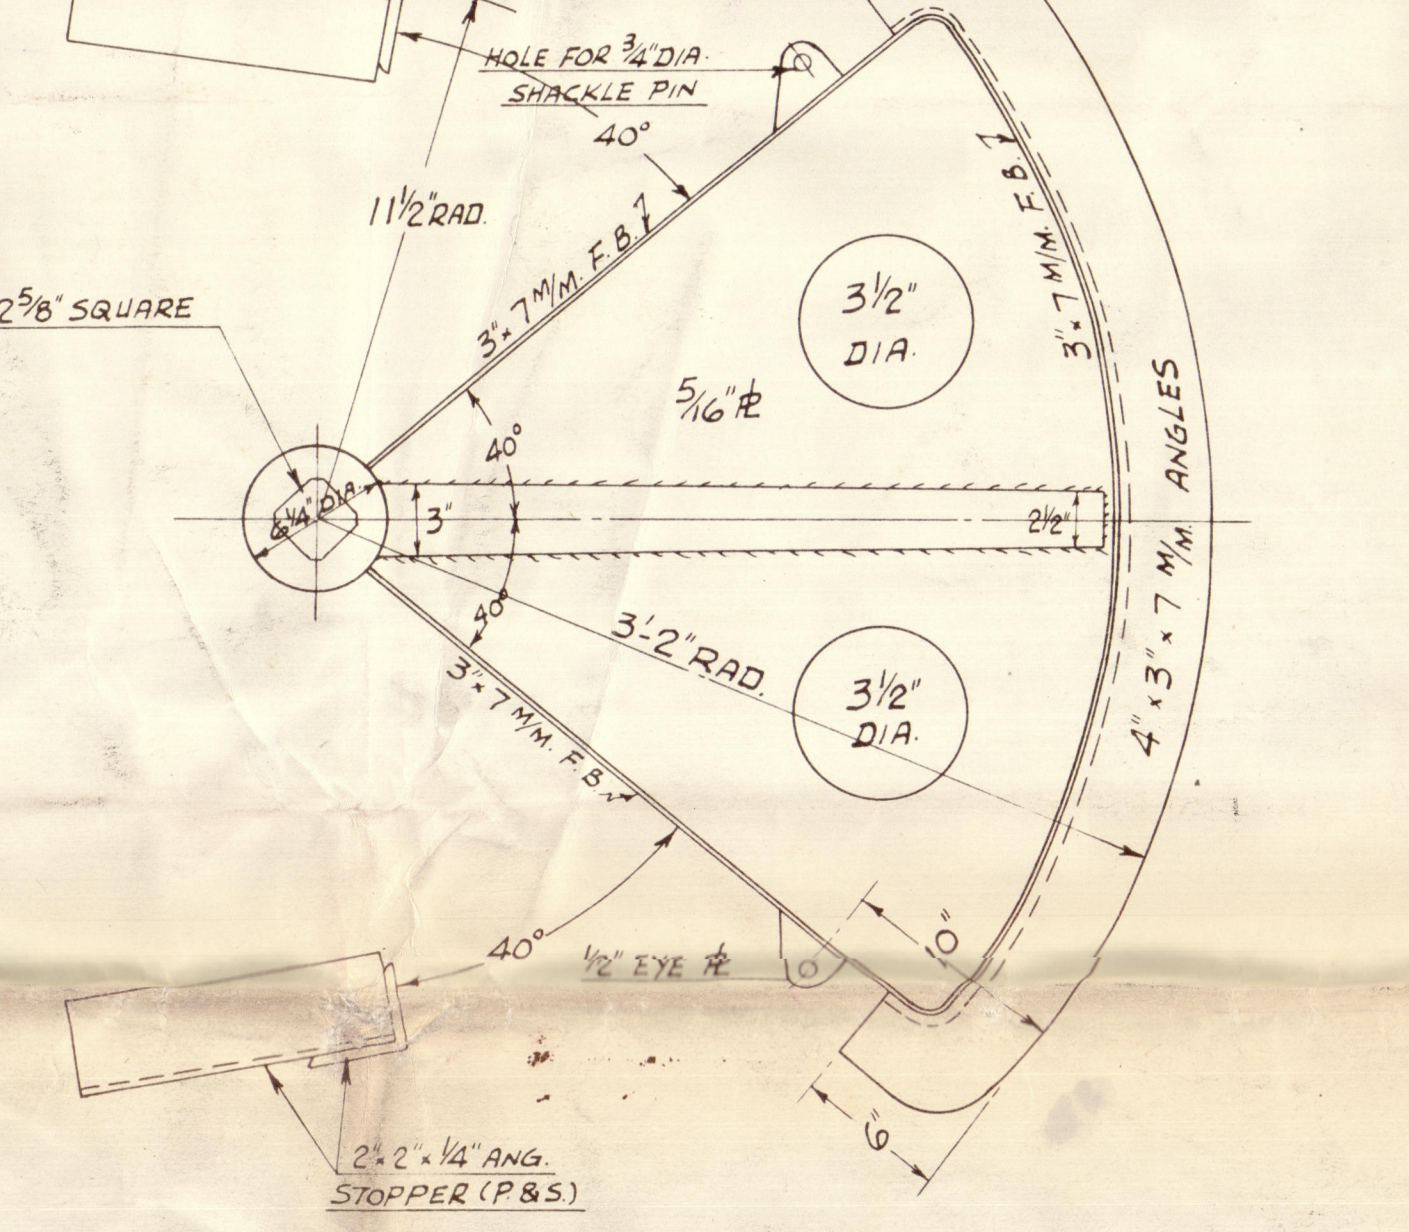
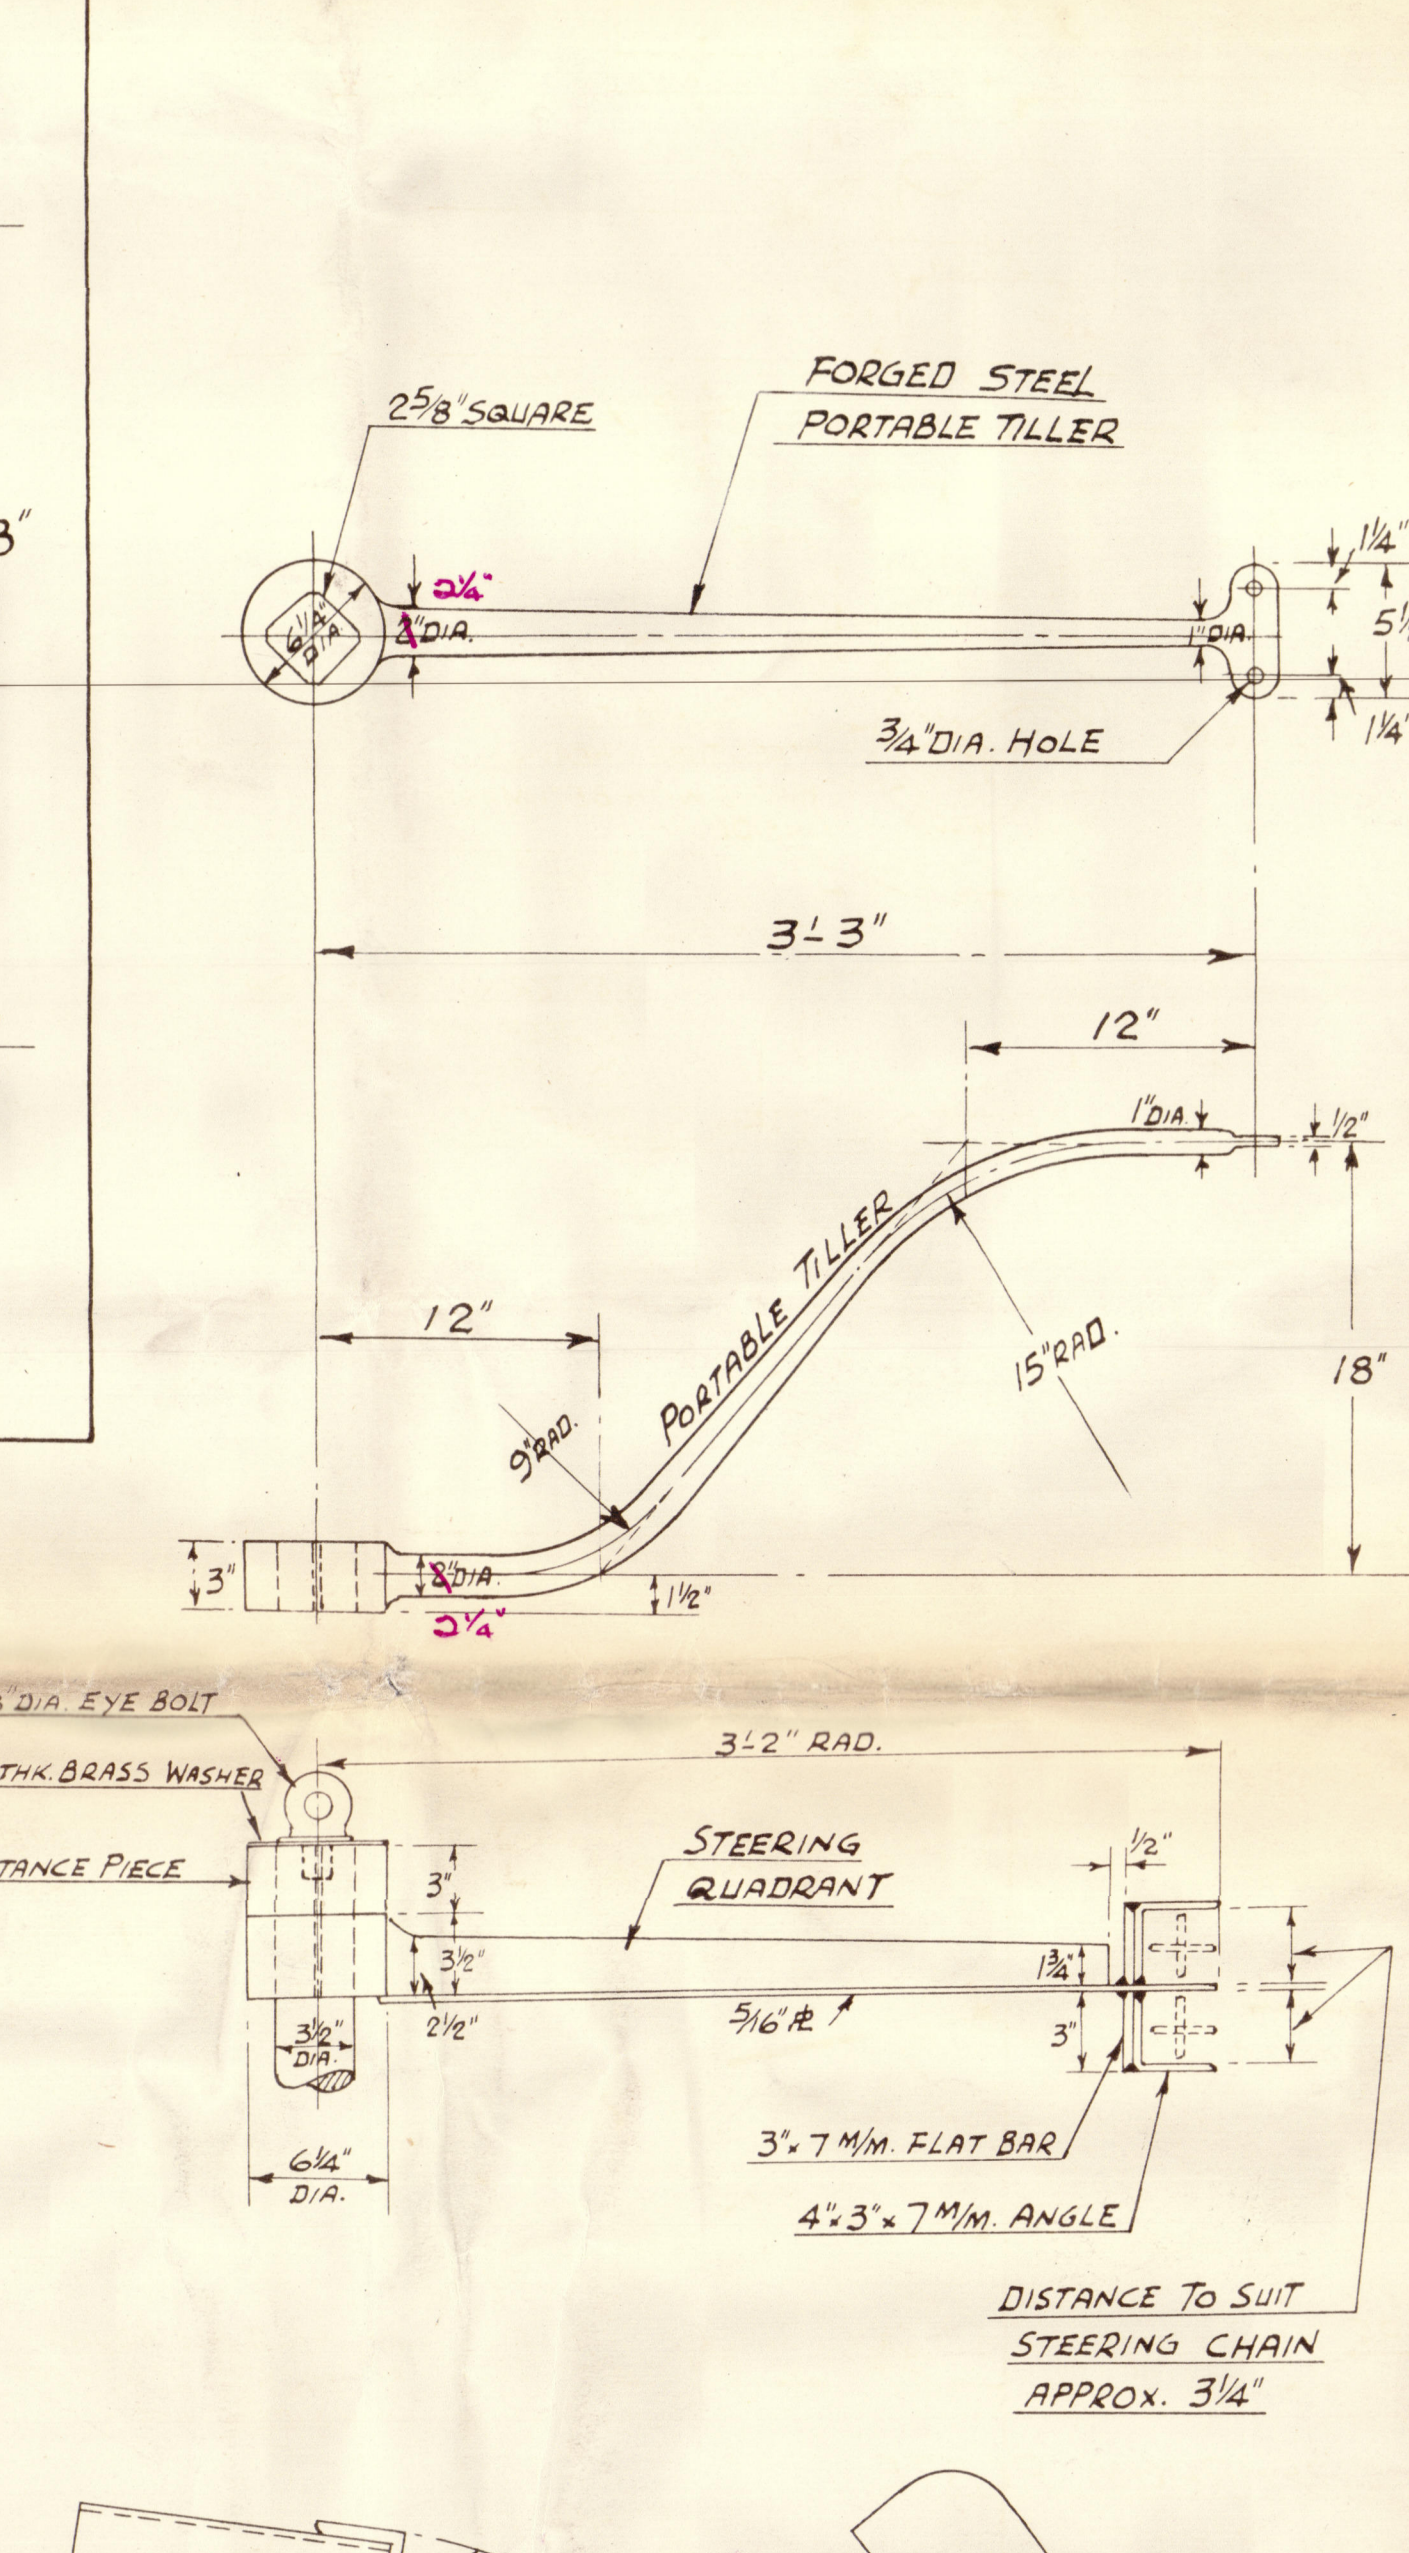
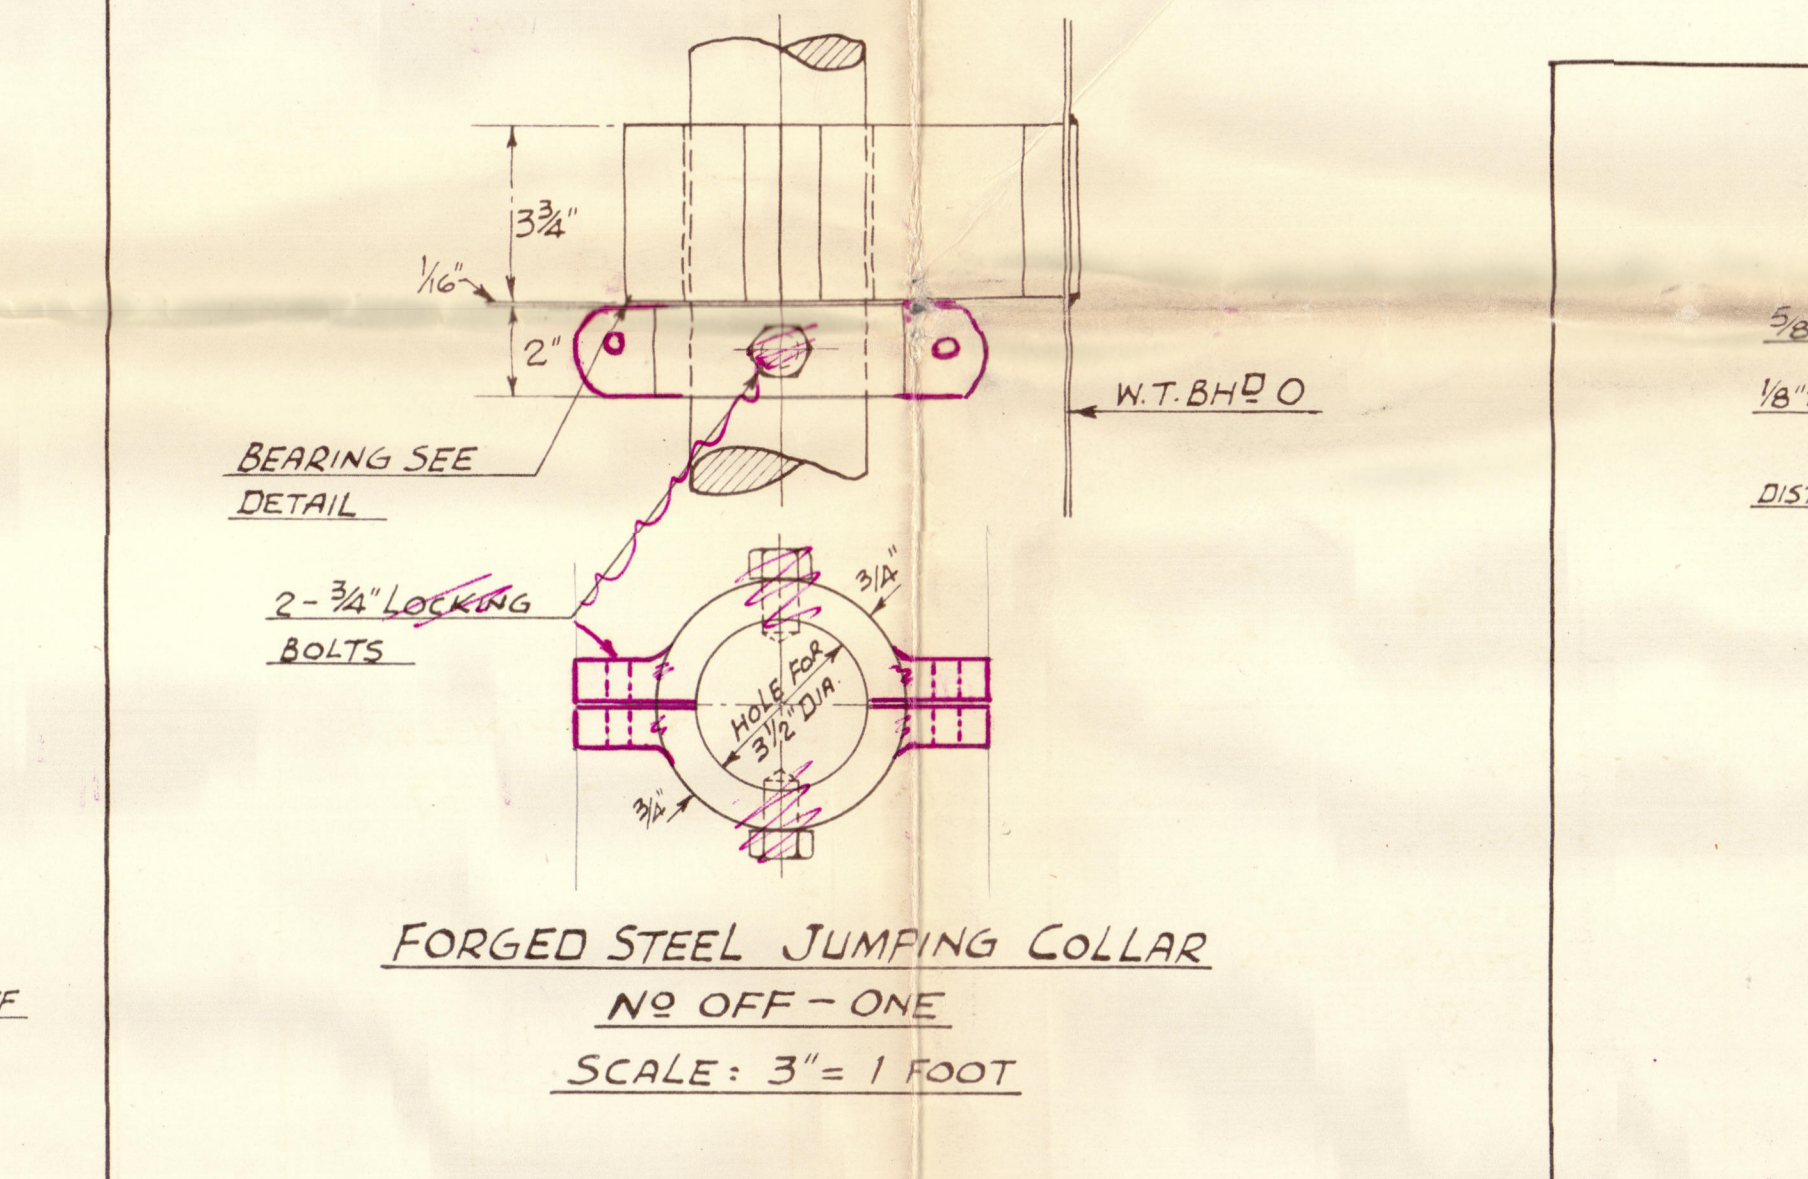


NOTE :-  
RUDDER TO BE PRESSURE TESTED  
ON COMPLETION TO A HEAD OF  
12 FEET  
RUDDER TO BE FILLED WITH BETUMASTIC  
AND DRAIN OFF

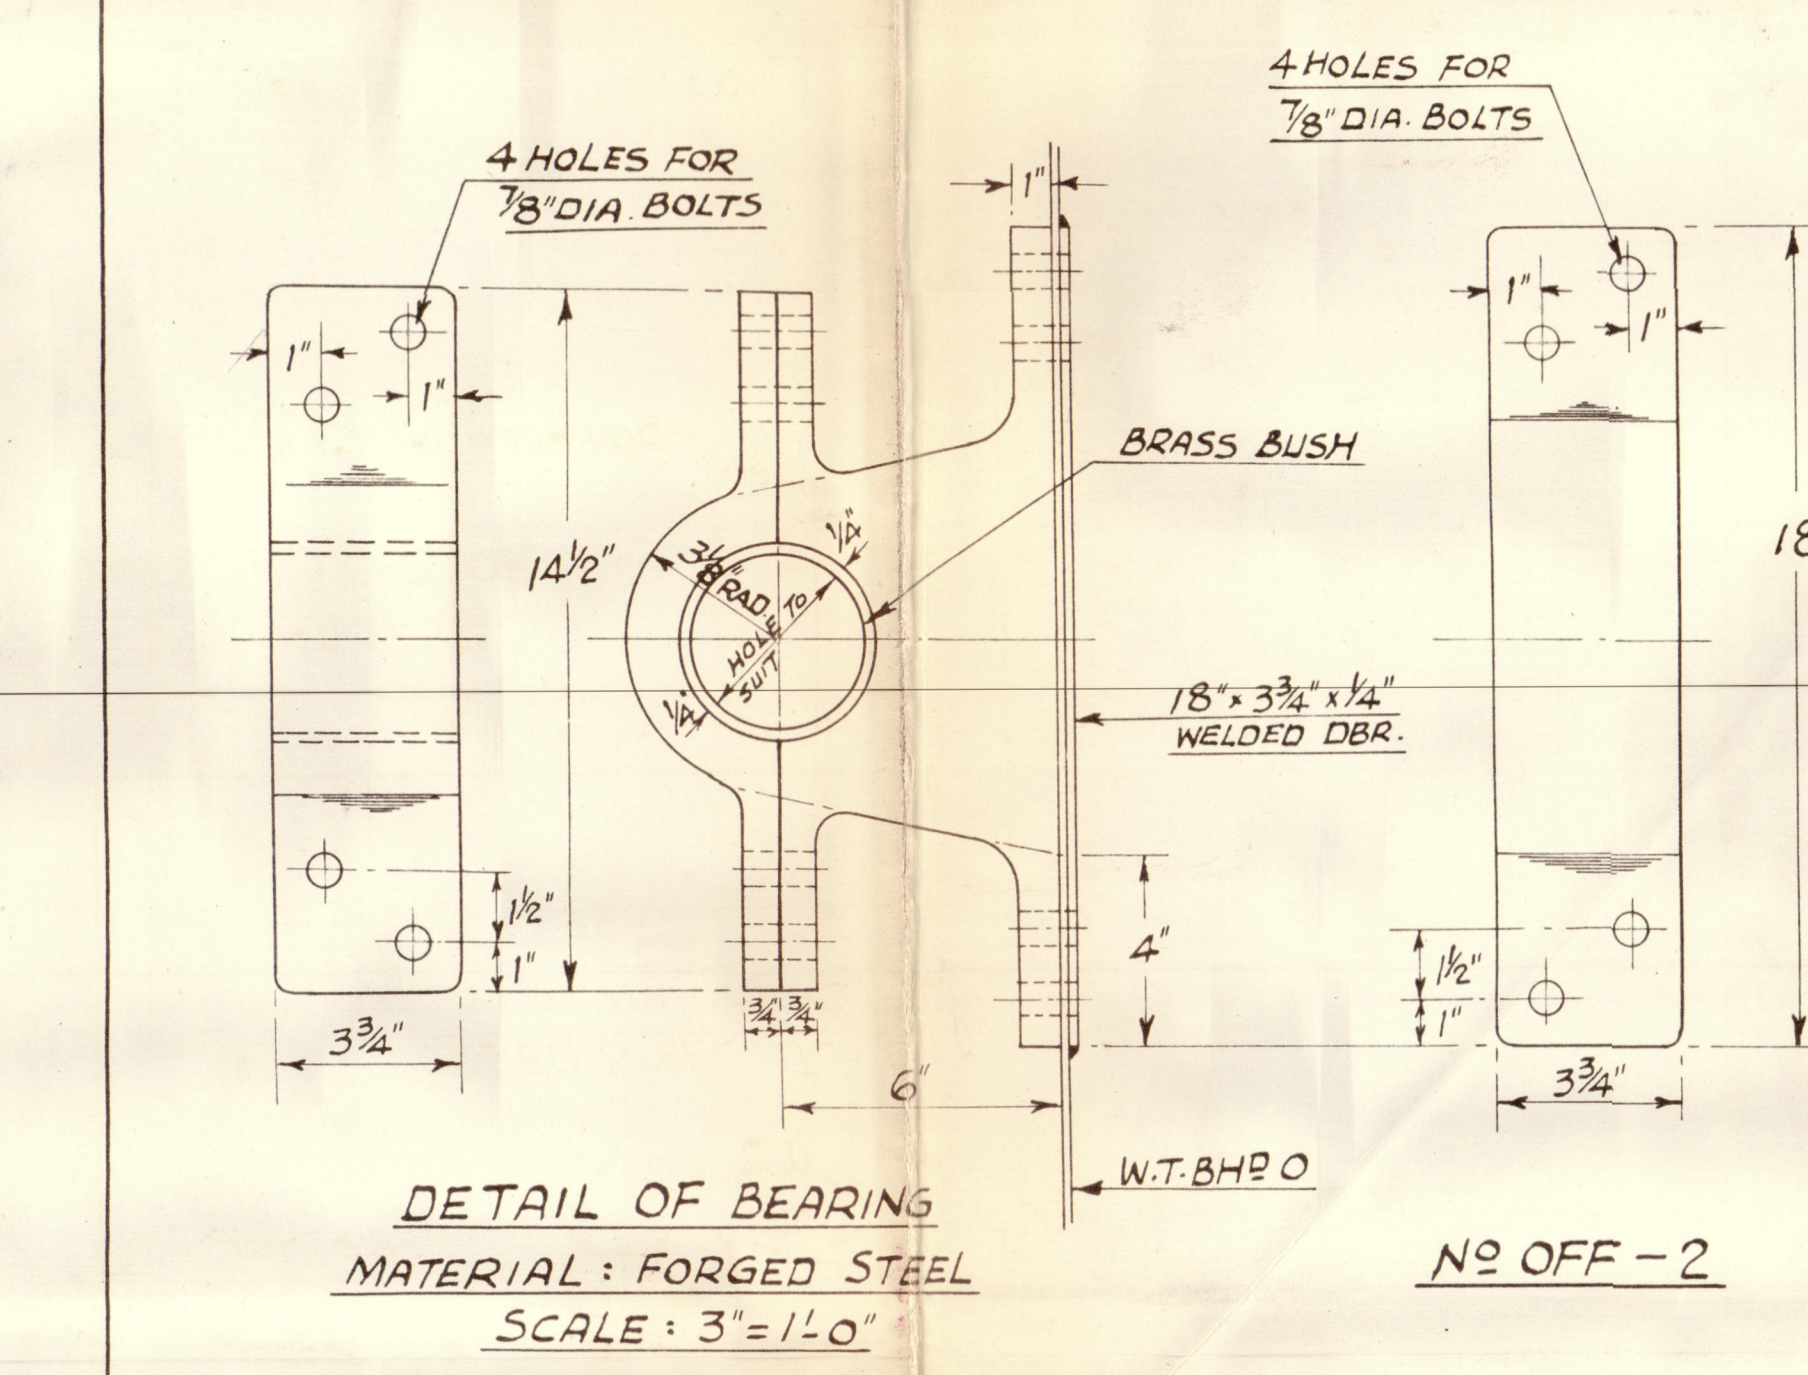

DEGEI II  
YARD No 168

HONG KONG TRANSPORTATION COMPANY LTD  
HONG KONG

TWIN SCREW PASSENGER  
AND CARGO VESSEL

DETAIL OF SKEG  
AND RUDDER FITTINGS

SCALE AS MARKED	
DRAWN BY	<i>Y. H. K. H. K.</i>
APPROVED	H.K.T. 467 A
DATE	10.6.1957


M/M 9795

DEGEI II

DETAILS OF SKEG & RUDDER FITTINGS.

RECORDS DEPT.,  
LONDON

RECORDS DEPT.,  
LONDON

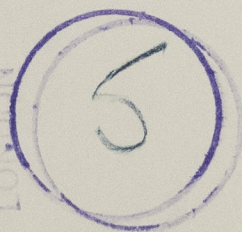

© 2021

Lloyd's Register  
Foundation

009789-009795-0229