


9/4/56.

TO CLASS LLOYDS  "A" FOR HARBOUR SERVICE  
AT RIO DE JANEIRO.

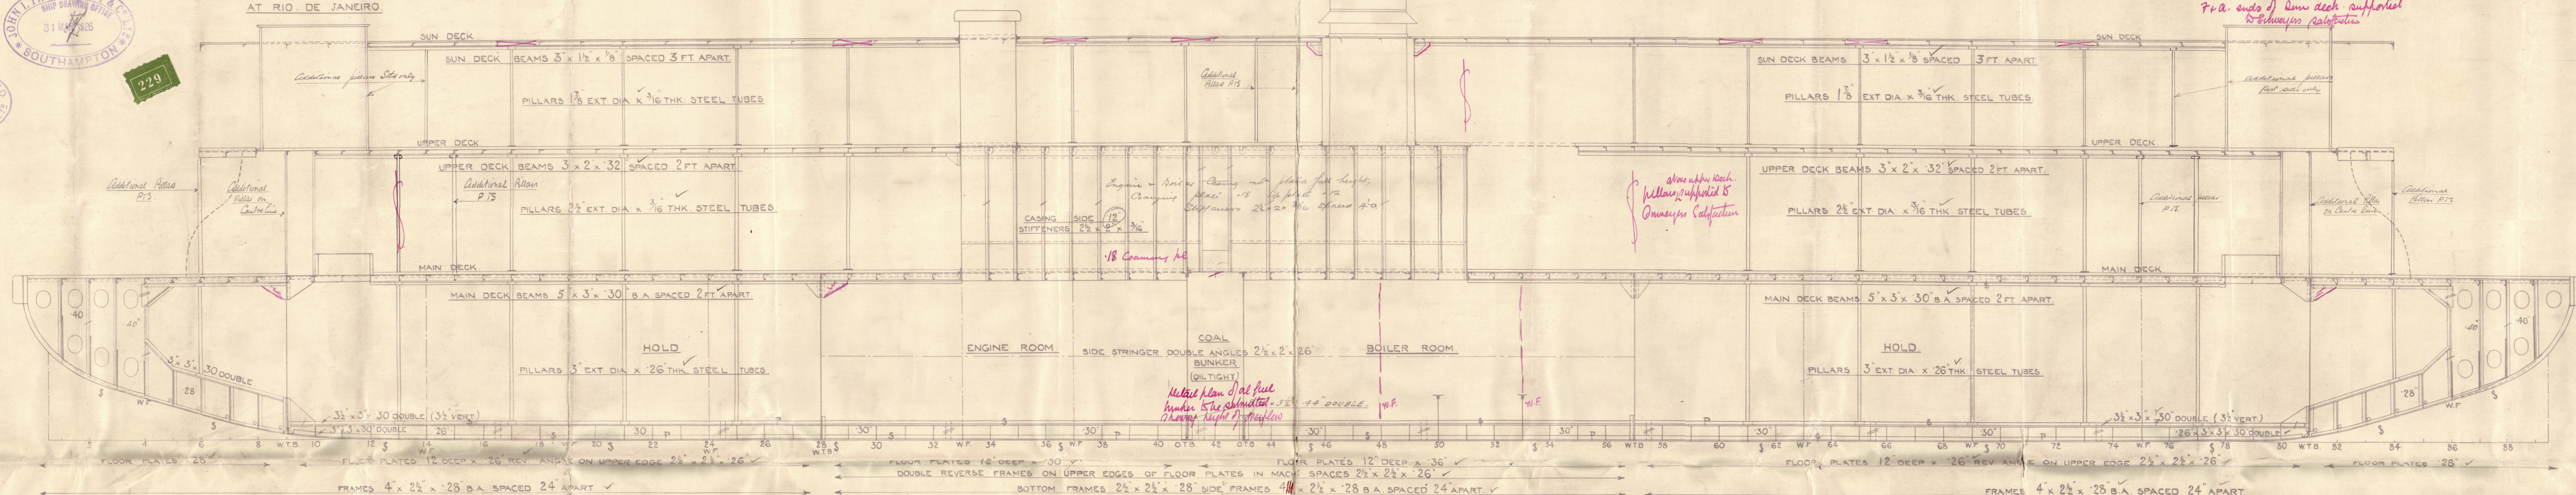



detail plan of all fuel  
tanks & the submitted  
showing height of the fuel


Section 35 of the Rules has been complied with so far as applicable.  
Flash point of oil fuel. Above 150°F.

detail arrangements of webs strengthening  
in way of propeller brass be submitted.

stinger has doubled in  
vol. of oil fuel bunker.

O.T. BOUNDARY ANGLES  
 $3\frac{1}{2}^\circ + 3\frac{1}{2}^\circ + 44^\circ$  DOUBLE ✓

9.4.11.



Double ended ferry steamer

"IMBURY"

Messrs. John I. Thornycroft & Co. Ltd.

Southampton.

N<sup>o</sup> 1060

PROFILE AND DECK PLAN.

Approved plan.

Isola p. 111



© 2020

Lloyd's Register  
Foundation

009805-009814-0120



Thornycroft 1060

P. 12. Plan.



© 2020

Lloyd's Register  
Foundation