




TWIN SCREW DOUBLE ENDED FERRY STEAMER.
MIDSHIP SECTION.

LENGTH ON WATERLINE	177' - 10"
BREADTH M ^{LD}	33' - 0"
OVER SPONSONS (EXTREME)	43' - 0"
DEPTH M ^{LD} AT D ^K CENTRES	11' - 11"
AT SPONSON SIDE	11' - 4"

SCALE $\frac{1}{2}'' = 1 \text{ FT}$

TO CLASS LLOYDS ~~IN~~ "A" FOR HARBOUR SERVICE
AT RIO DE JANEIRO

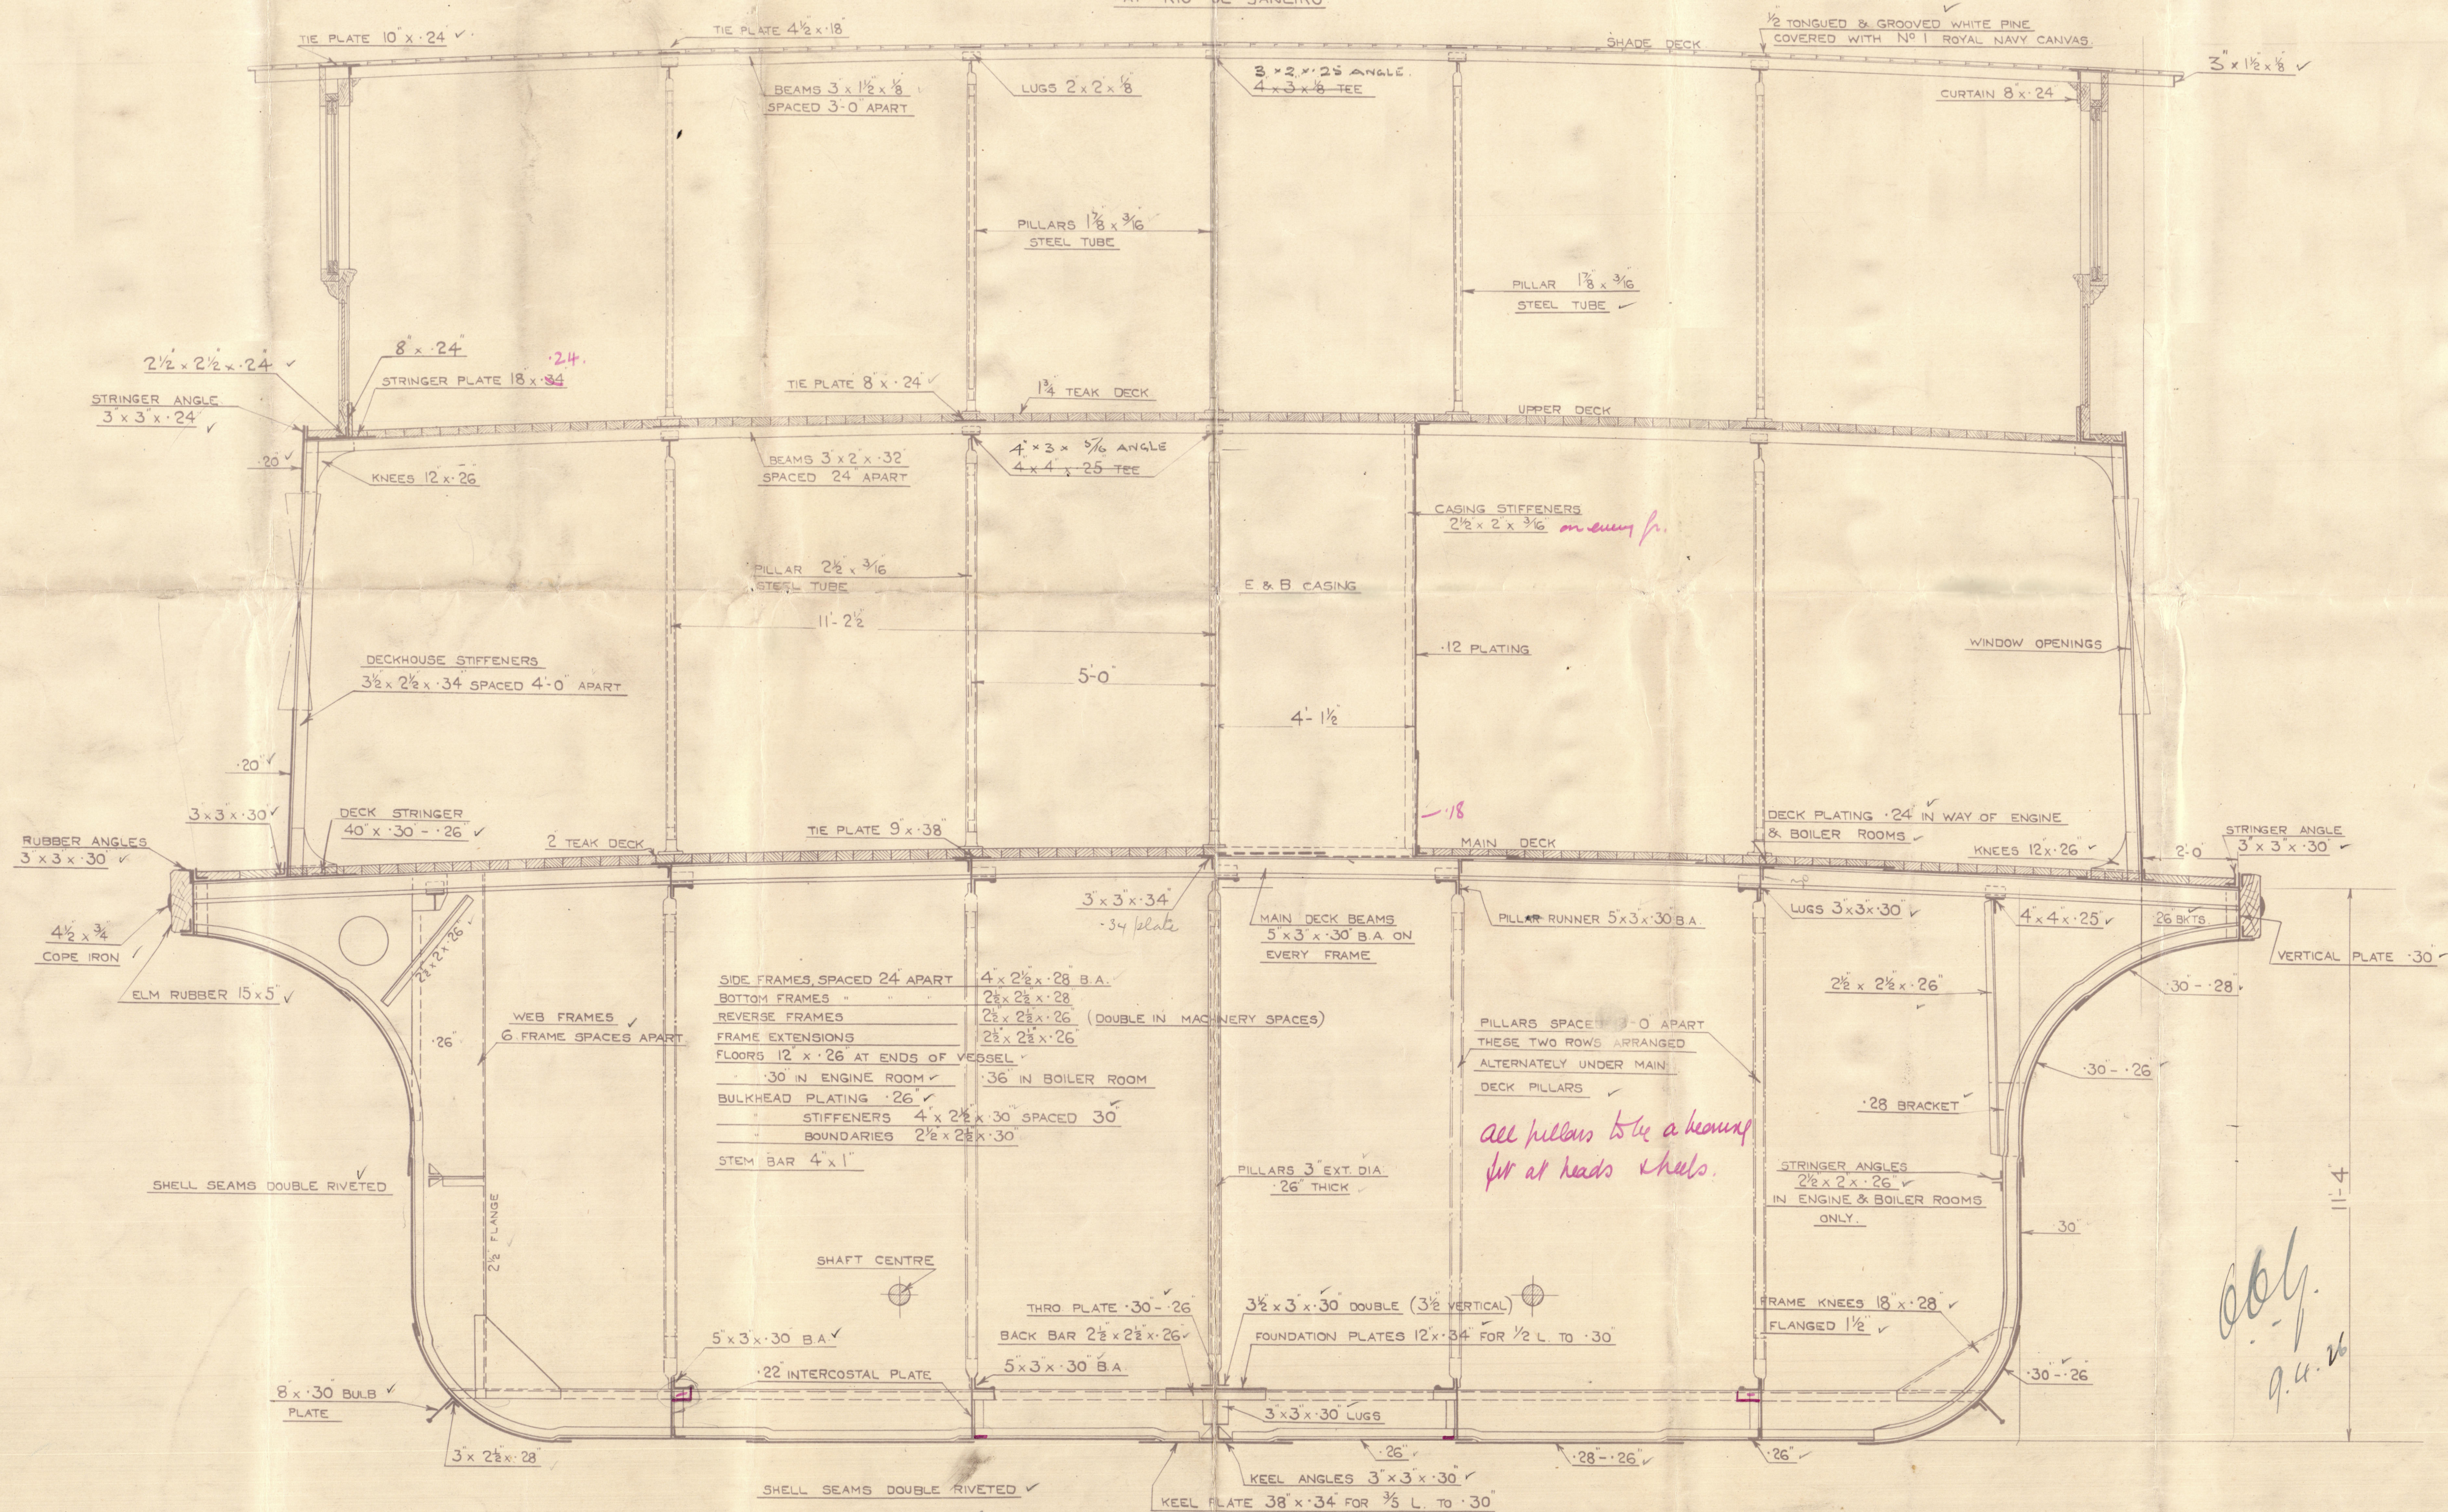

1060.

257 / 26

Double ENDED Ferry Steamer

"IMBLHY"

Messrs. John I. Thornycroft & Co. Ltd.

N^o 1060.

MIDSHIP SECTION.

Approved Copy.

Mid Section



© 2020

Lloyd's Register
Foundation

009805-009814-0121