


RUDDER STERN POST AND STEM

SHIP N^o 128

SHIP DRAWING N^o 1744

SCALES 1" = 3' = 1 FOOT.


NOTE: - LLOYDS SURVEYOR TO BE INFORMED WHEN WORK IS PUT IN HAND.

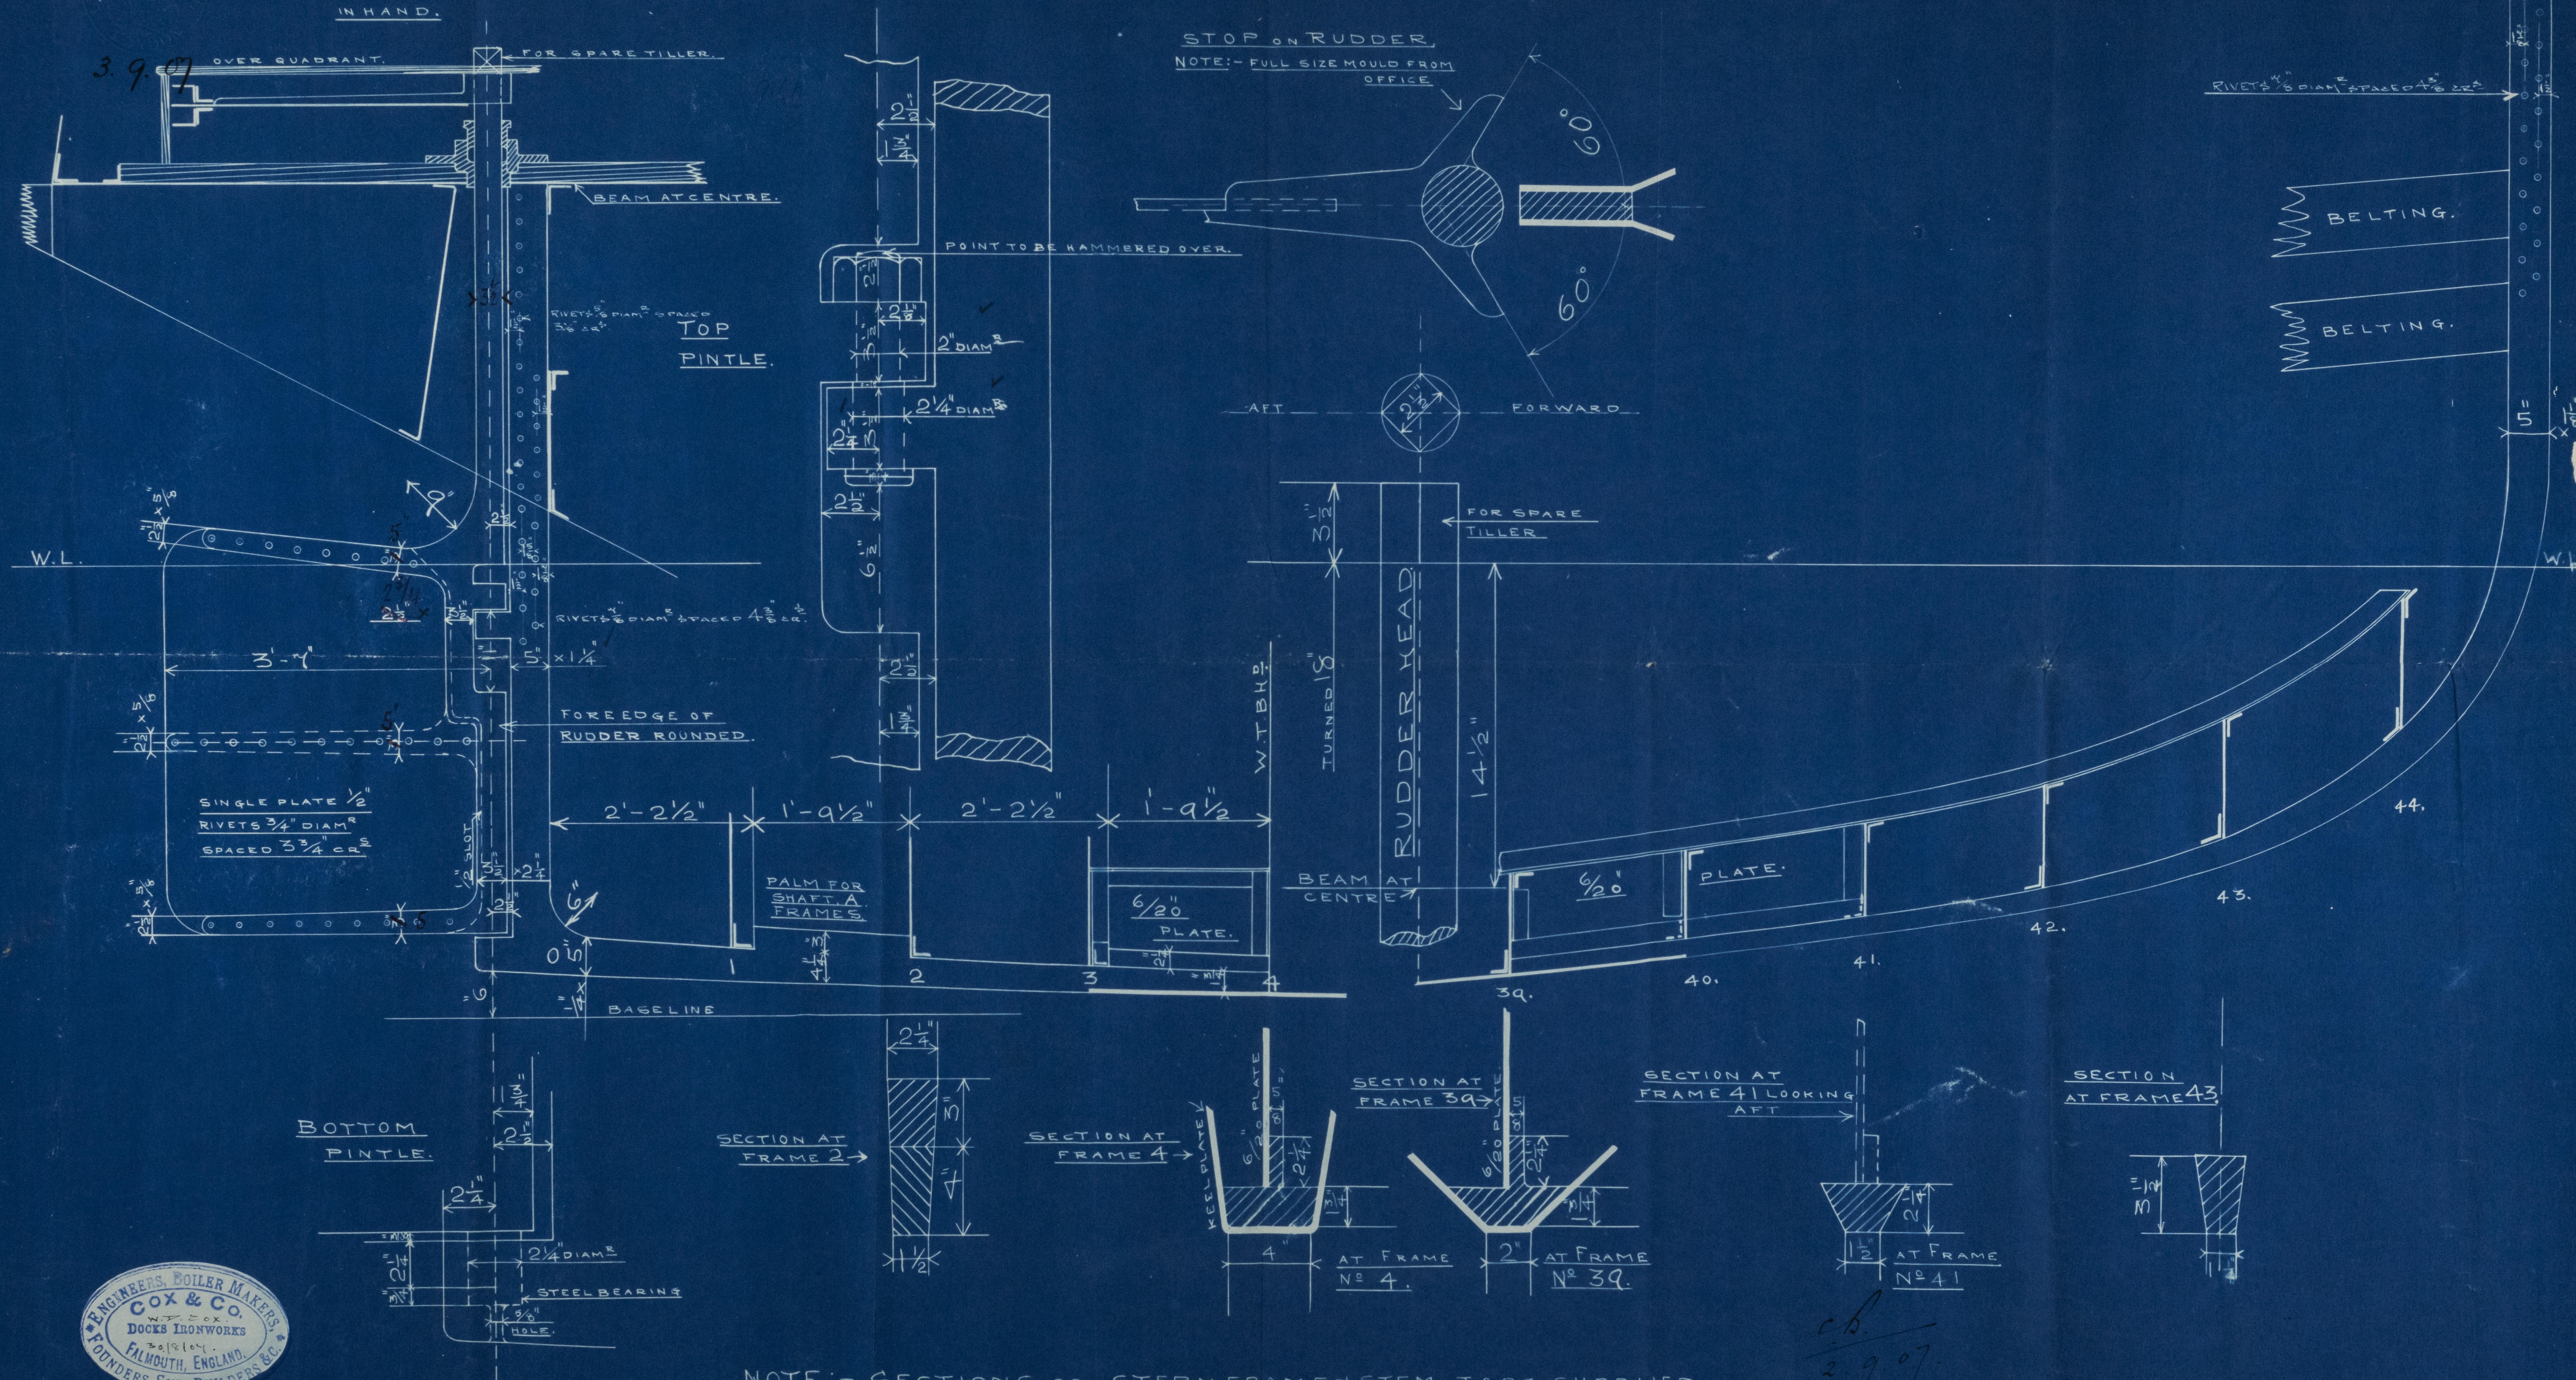

NOTE: - SECTIONS OF STERN FRAME & STEM TO BE SUPPLIED BLACKSMITH FROM LOFT. MOULD OF KEEL SON SUPPLIED FROM LOFT.



S.S. No 128
Box 70 Falmouth

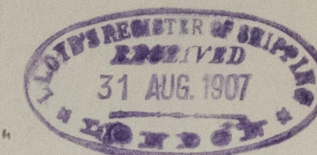

Inew
Fal 5076



009805-009814-0267

