

MIDSHIP SECTION.

PRINCIPAL MEASUREMENTS.

LENGTH 16'-0" 90'-0"
 BREADTH 11'-0" 22'-6"
 DEPTH 3'-0" 8'-6"

SHIP NO. 128.

SCALE 1" = 1'-0"

EQUIPMENT.

1 ANCHOR 5 CWTs EX STOCK.

30 FATHOMS 3/4 INCH STUD LINK CHAIN


2 - 15 " LENGTHS 5 INCH 3 STRAND MANILLA

2 - 15 " " 3 " MANILLA

2 - 15 " " 2 " "


4 - 8 " " 5 " 3 STRAND MANILLA

ONE COIL 1 INCH HEAVING LINE.


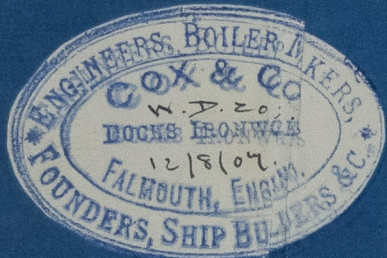
TO CLASSIFYDS A FOR
FERRY PURPOSESB.O.F.T. STEM 5 FOR
RIVERS.

11.85
 8.96
 18.00
 38.81

3206

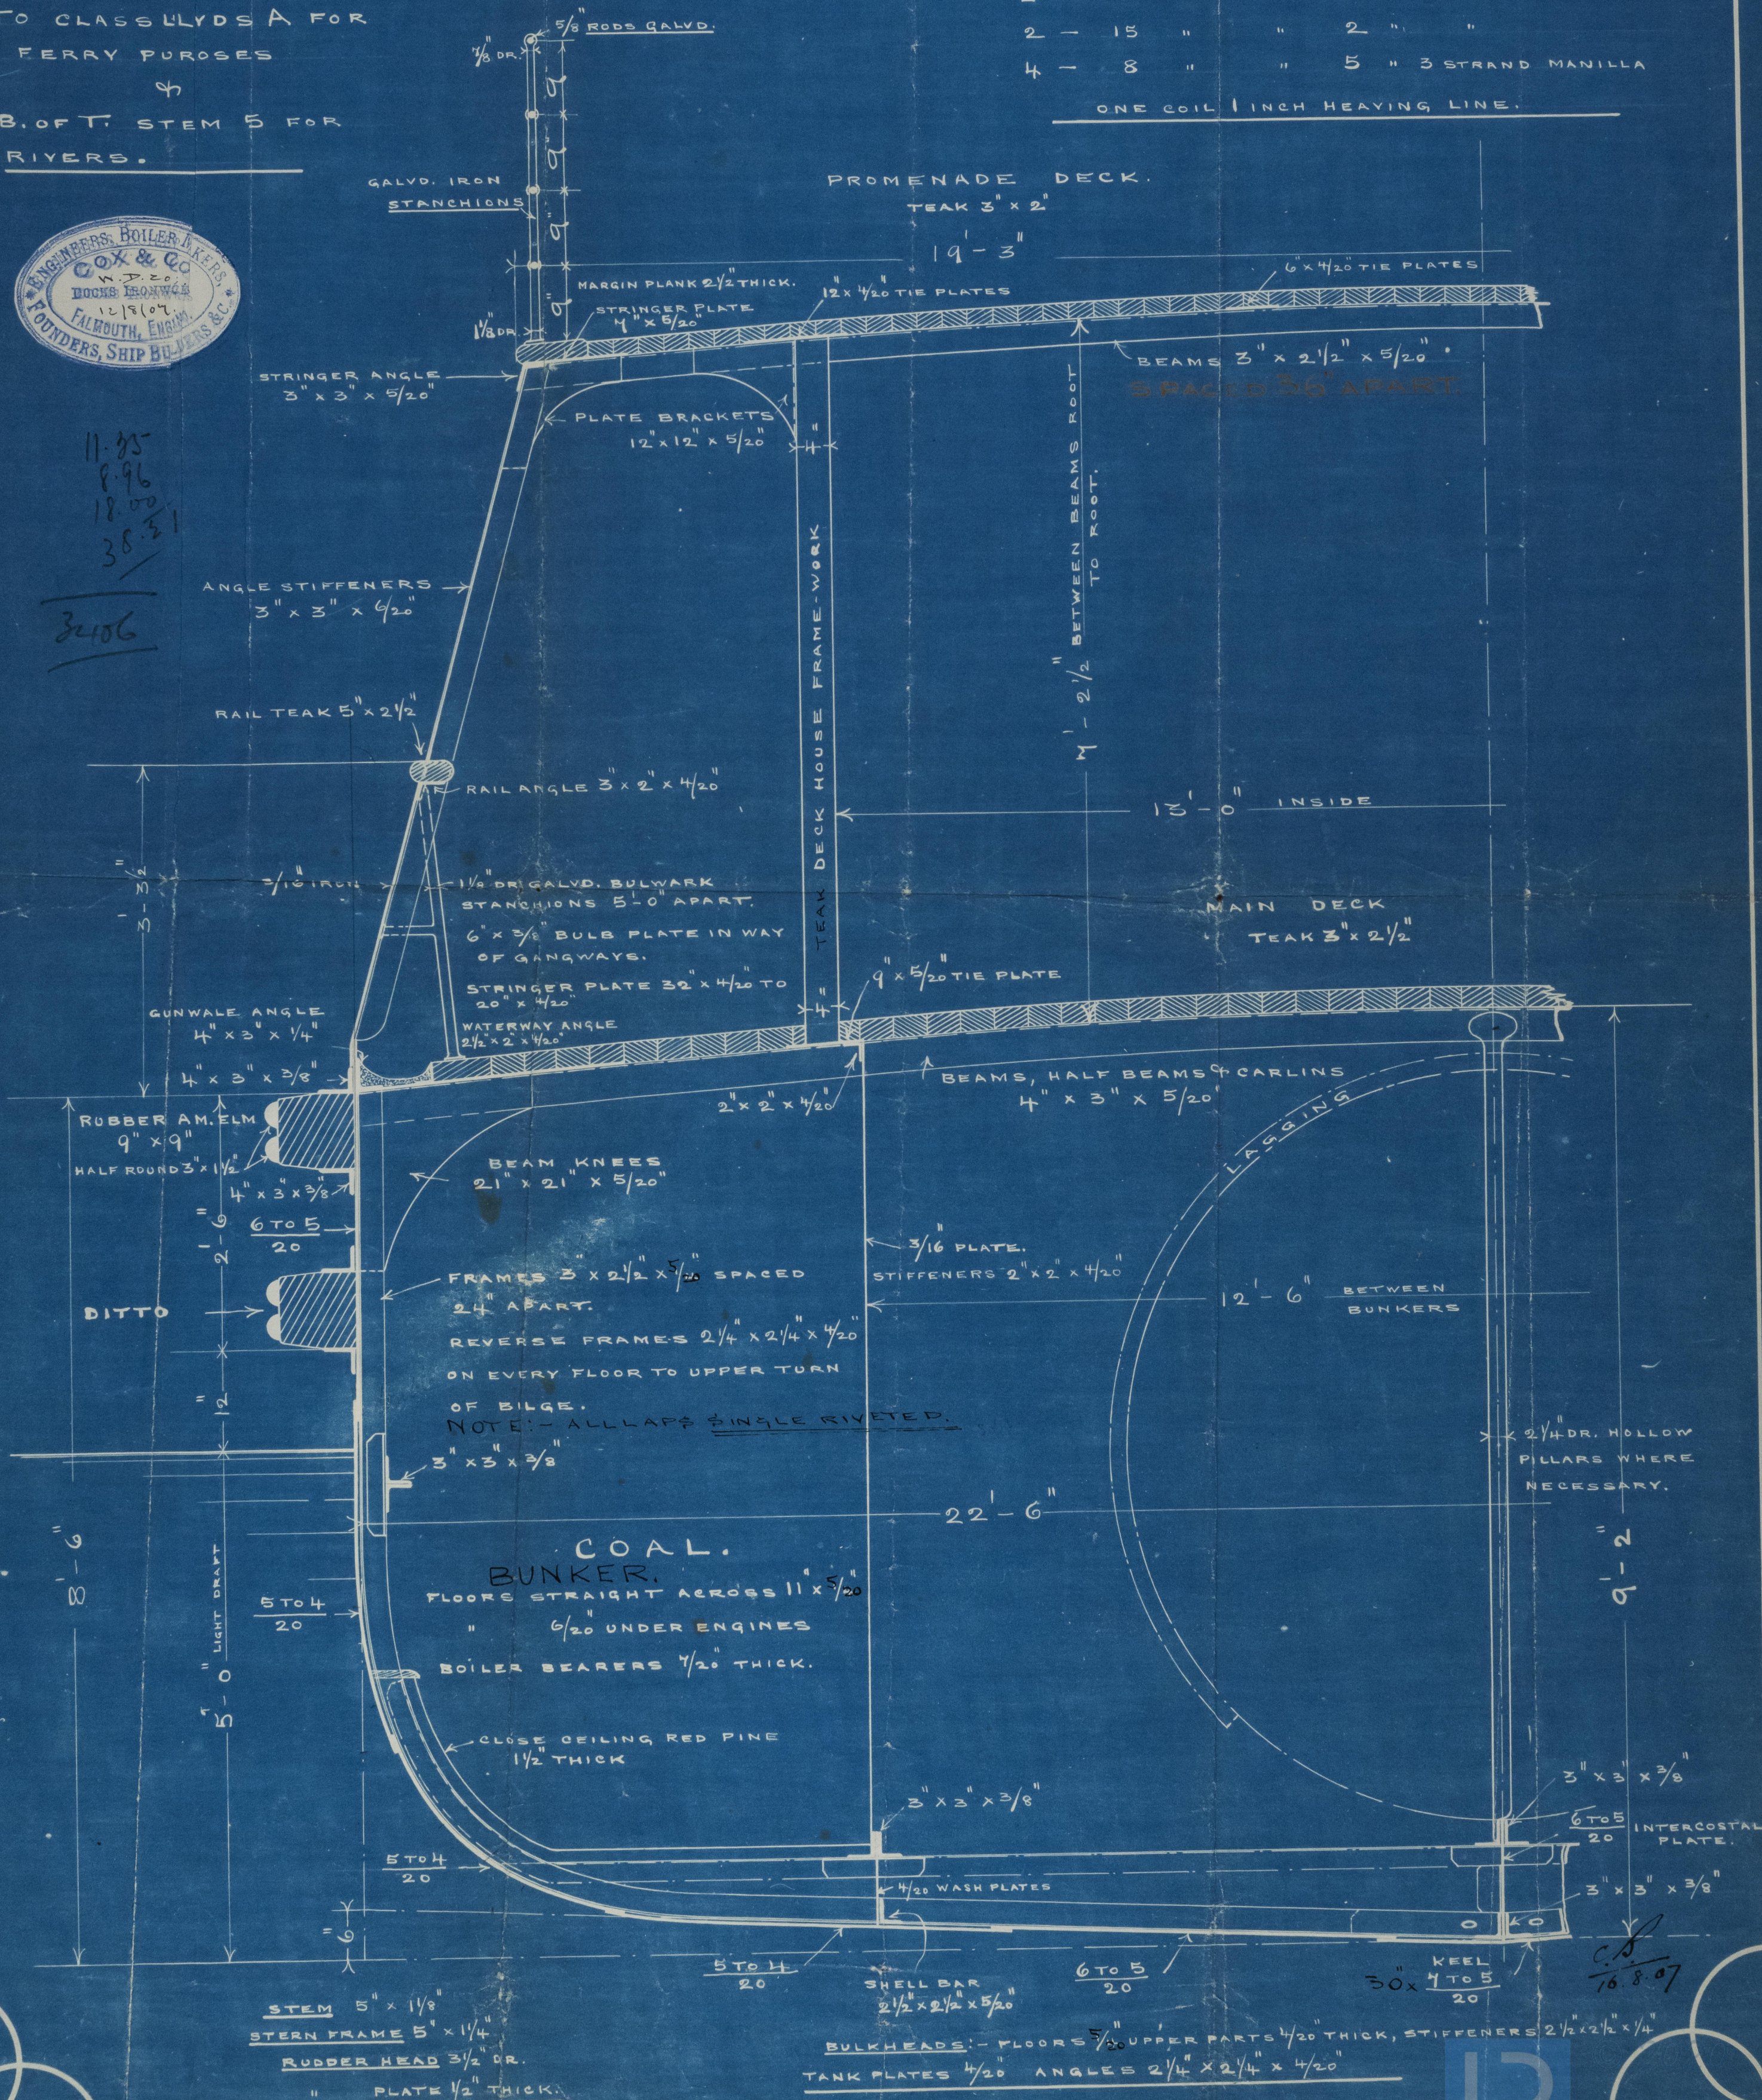


Cox No 128

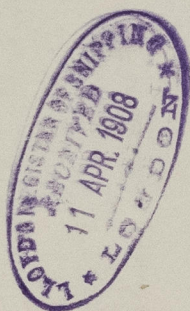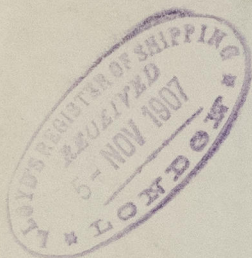

Cox No 128
Falmouth

Kew

Fal 5016

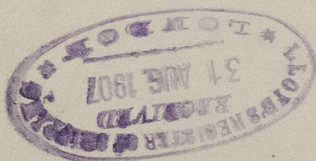

© 2020

Lloyd's Register
Foundation

009805-009814-0268