
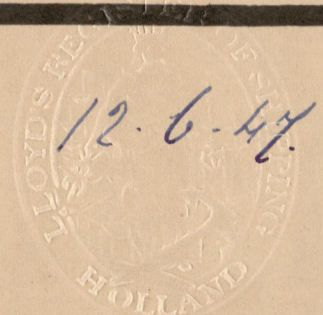


12.6.47.

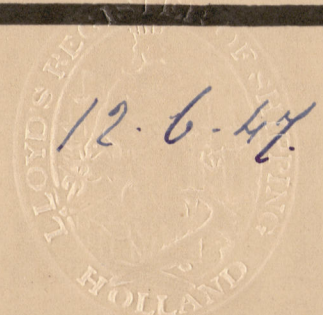

Q.L.
12-6-47.

PROFILE AND DECKPLAN

DATE 10/6/47	SCALE 1:50	NR 78103
--------------	------------	----------

09895-00149









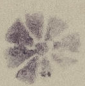M.S. "CONFID" 
(EX. G.L.)

PROFILE & DECKS

3

009888-009895-0049

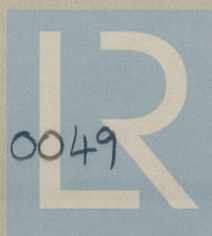

© 2021

Lloyd's Register
Foundation