




W.
NEWFOUNDLAND 17.

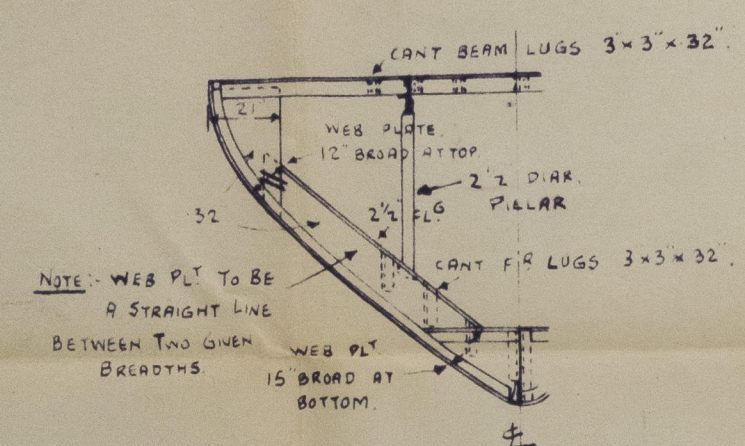


1/2 SECTION AT FLOOR C - STARBOARD SIDE - LOOKING AFT.
SCALE - 1/4" = 1 FOOT

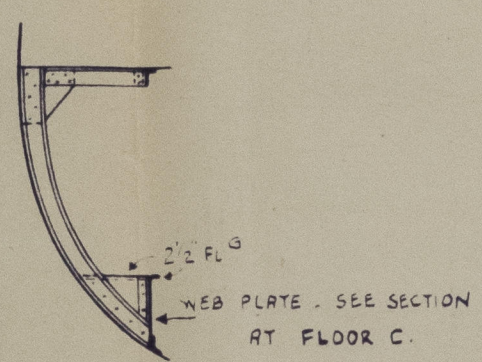

CANT FR NO 2 (EXPANDED) PORT SHOWN.
STARBOARD SIMILAR - SCALE - 1/4" = 1 FOOT.

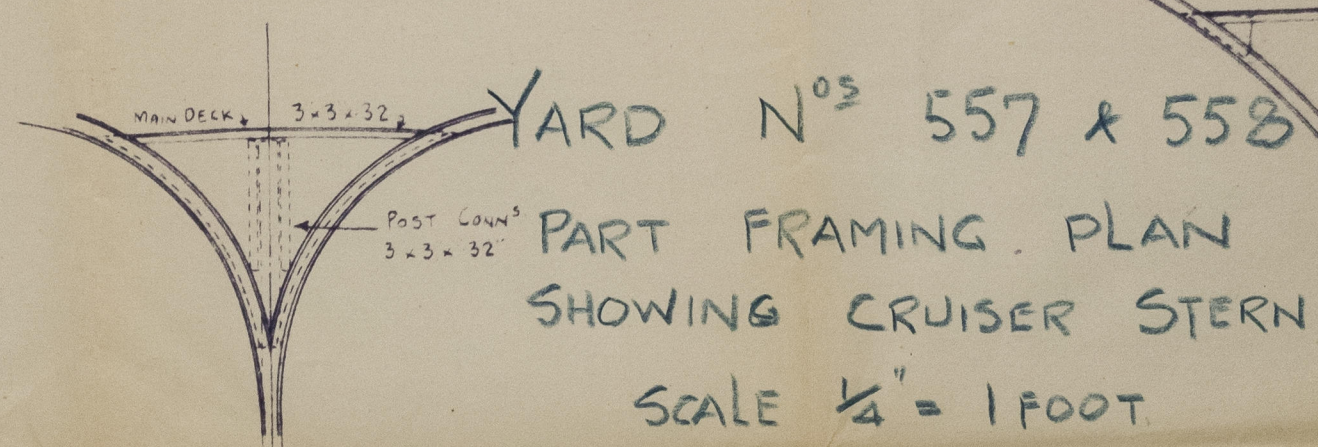


FRAME NO 3 LOOKING AFT
SCALE - 1/4" = 1 FOOT.

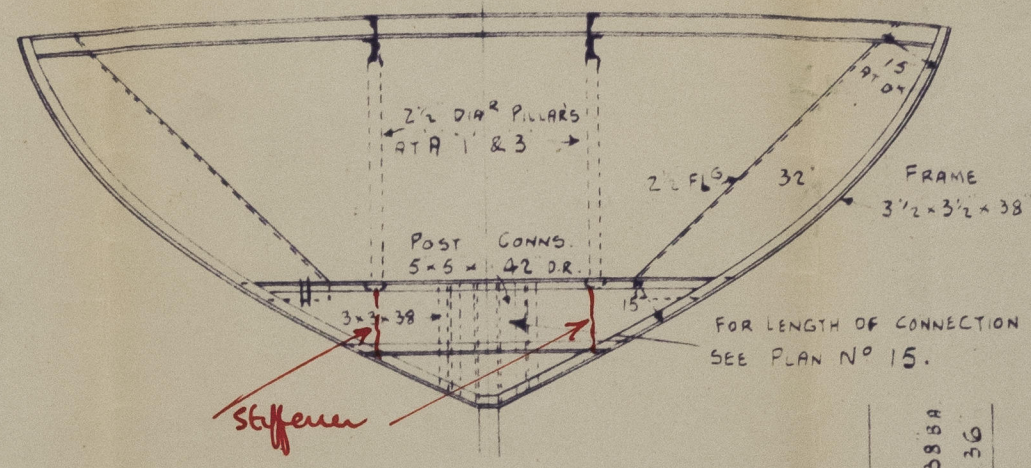

SECTION AT FRAME 0 LOOKING AFT.
SCALE - 1/4" = 1 FOOT.

1/2 SECTION AT FR NO 2 - STARBOARD
SCALE - 1/4" = 1 FOOT

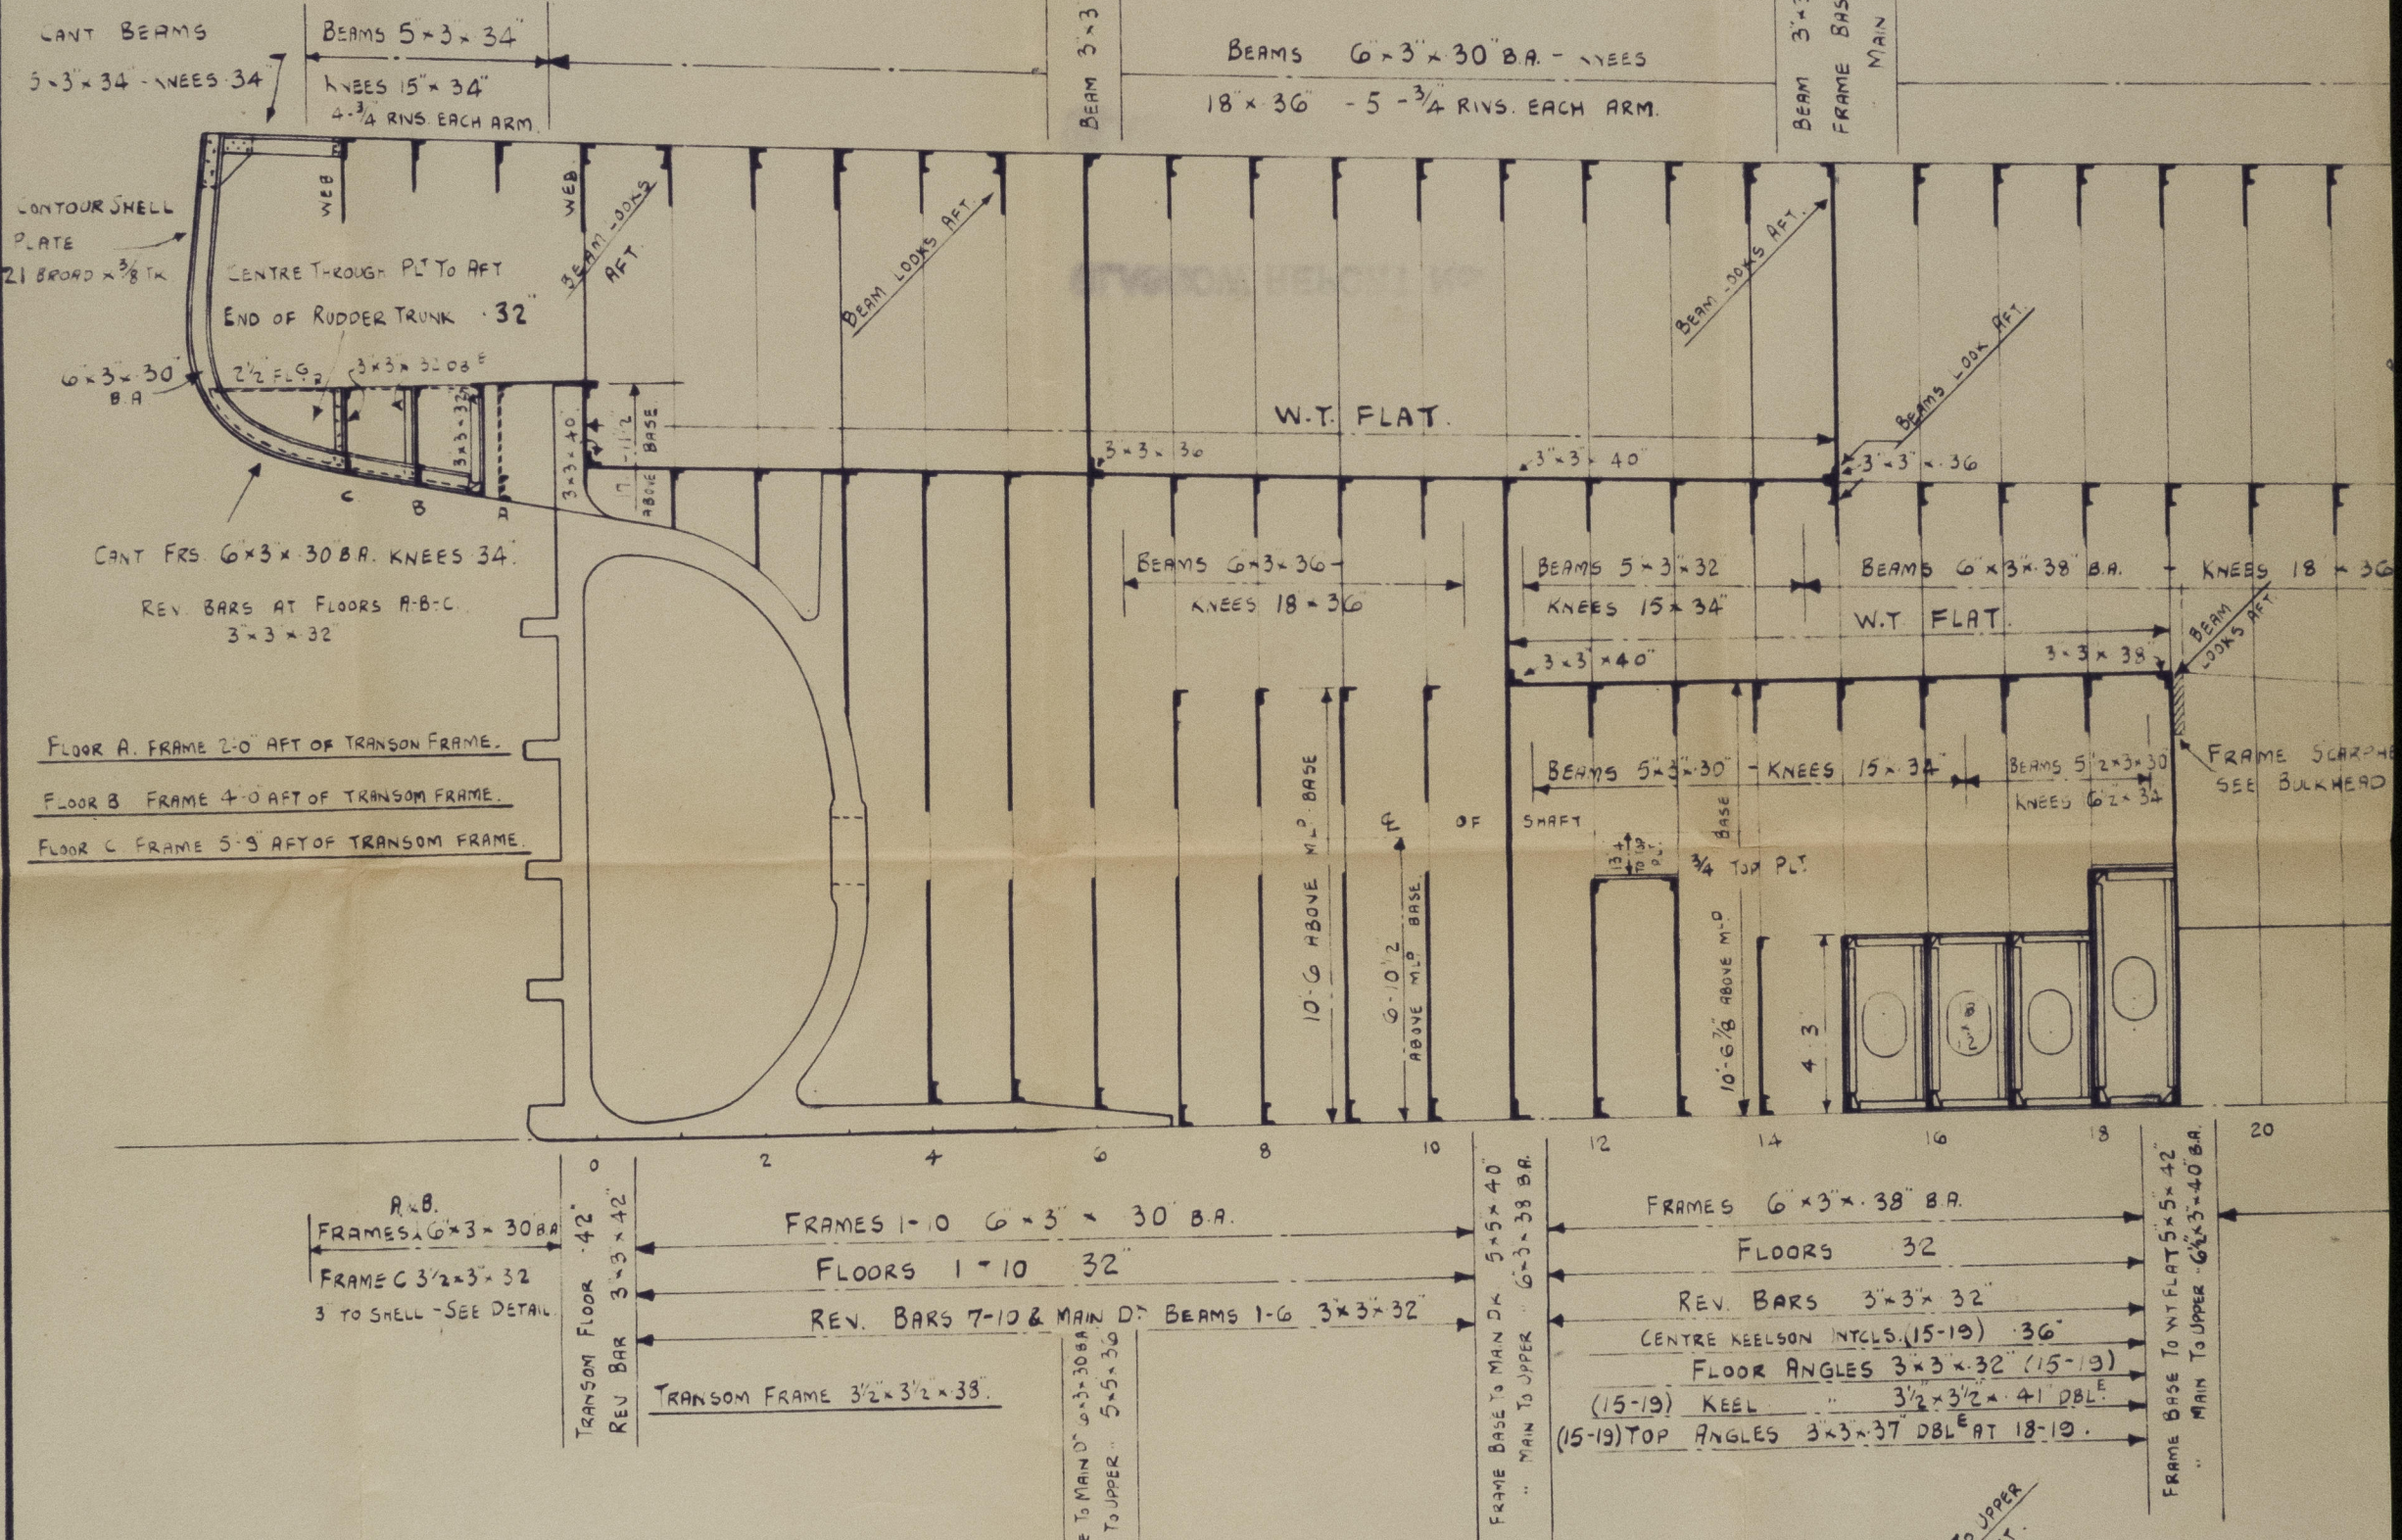


Approved for Bureau Stern Only

APPROVED
LLOYD'S REGISTER OF SHIPPING

6.6.39

DATE 6.6.39

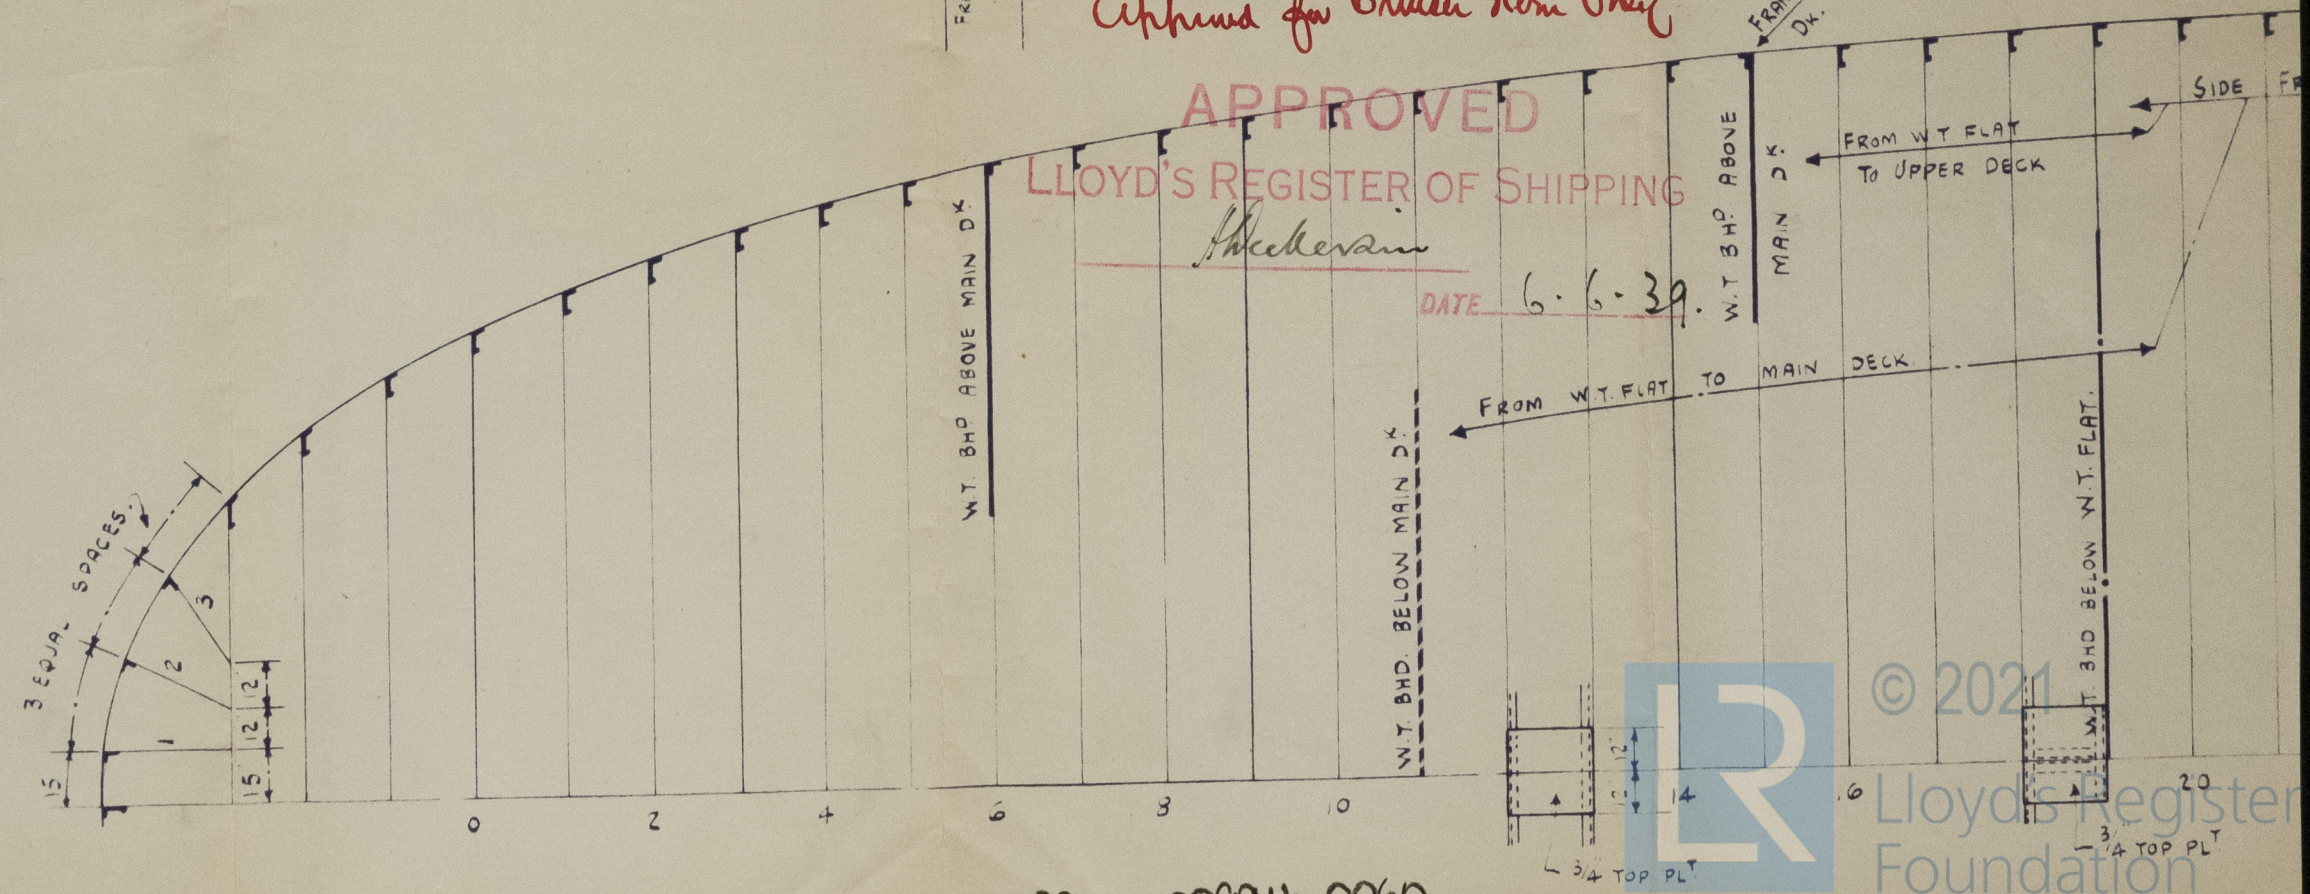

009904-009911-0060

✓ Glasgow.

Fleming & Ferguson Ltd.

Nos. 557 & 8.

CRUISER STERN.


557 Baccalieu *

GLASGOW REPORT No 62223

558 Bungeo

GLASGOW REPORT No 62483.

M/M. 9905

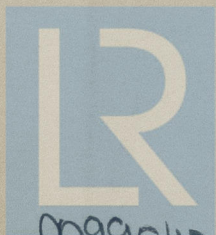

© 2021

Lloyd's Register
Foundation

009904-009911-0060