



STRENGTHENED FOR NAVIGATION IN ICE.

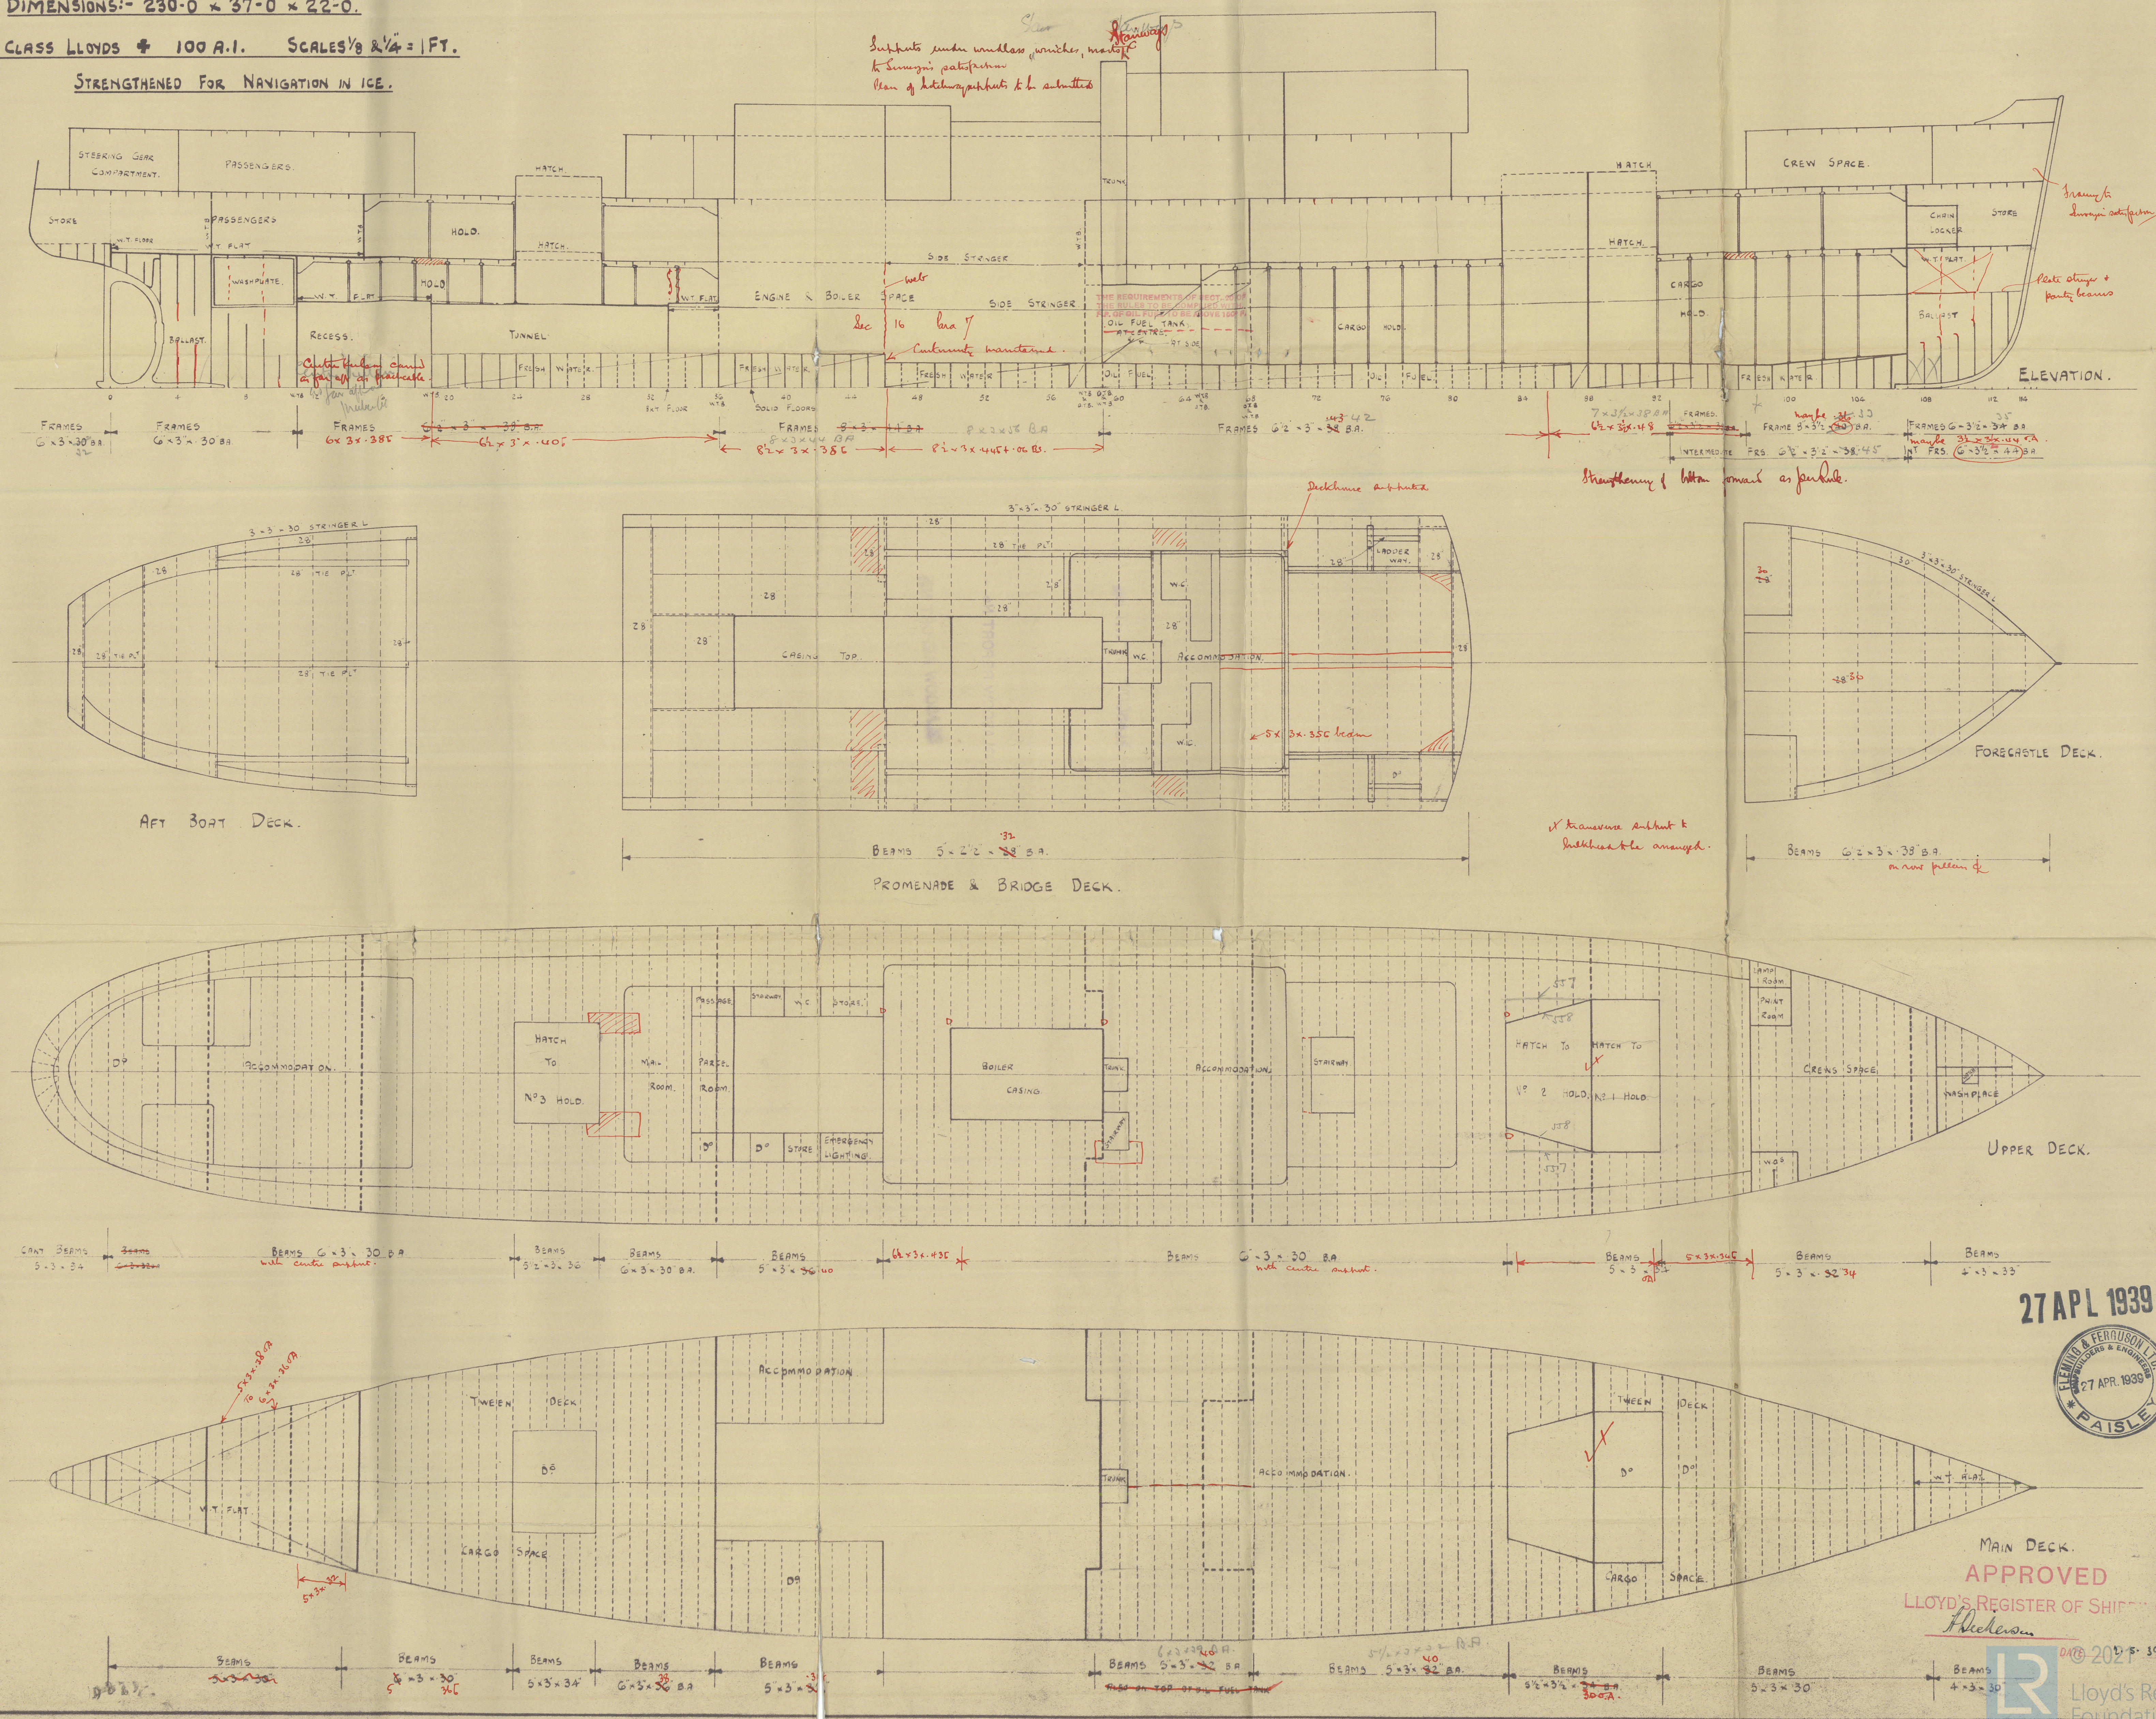

27 APR 1939

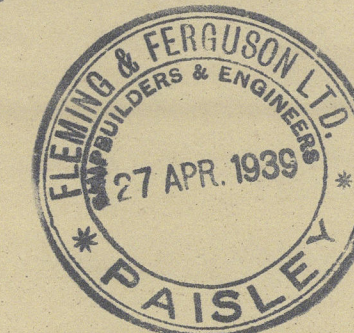

MAIN DECK.
APPROVED
LLOYD'S REGISTER OF SHIPING
H. Petersen

DATE 2021.5.39

Lloyd's Register
Foundation

Glasgow Freeboard Report- 62065

557 "Baccalieu"
GLASGOW REPORT No 62223

"Burgeon" - No 558
GLASGOW REPORT No 62354.

4th.
"Burgeon" 558
GLASGOW REPORT No 62483.

009904-009911-0062



© 2021

Lloyd's Register
Foundation