


PRINCIPAL PARTICULARS
 LENGTH O.A. 259'-0"
 LENGTH B.P. 251'-6"
 BREADTH MLO AT UPPER DECK 43'-10"
 BREADTH MLO AT BASE 43'-0"
 DEPTH MLO 10'-0"

10 JAN 1948


3600 TON OCEAN TANKERS

GENERAL ARRANGEMENT



SCALE: 1/8" = 1'-0"

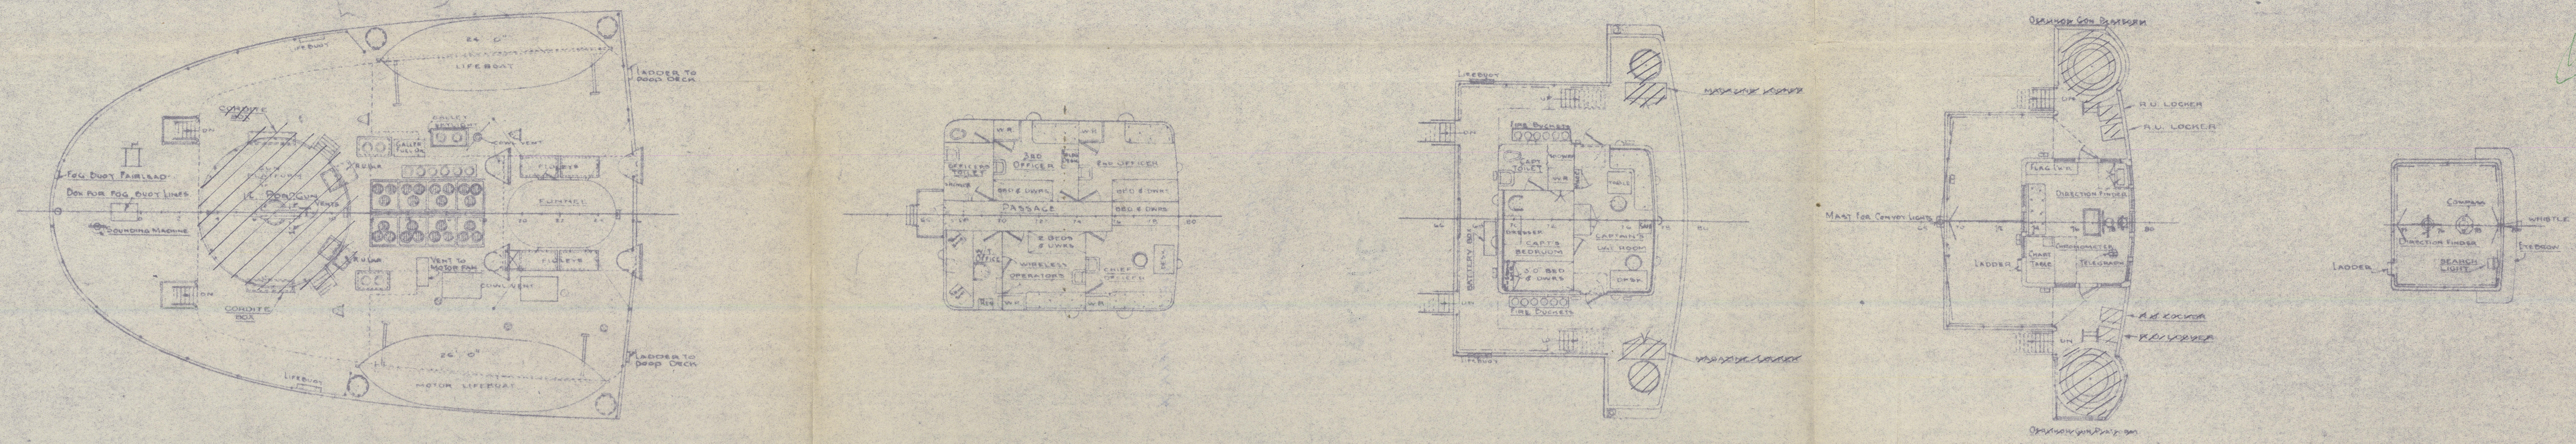

BOAT DECK MIDSHIP DECKHOUSE BRIDGE NAVIGATION BRIDGE WHEELHOUSE TOP

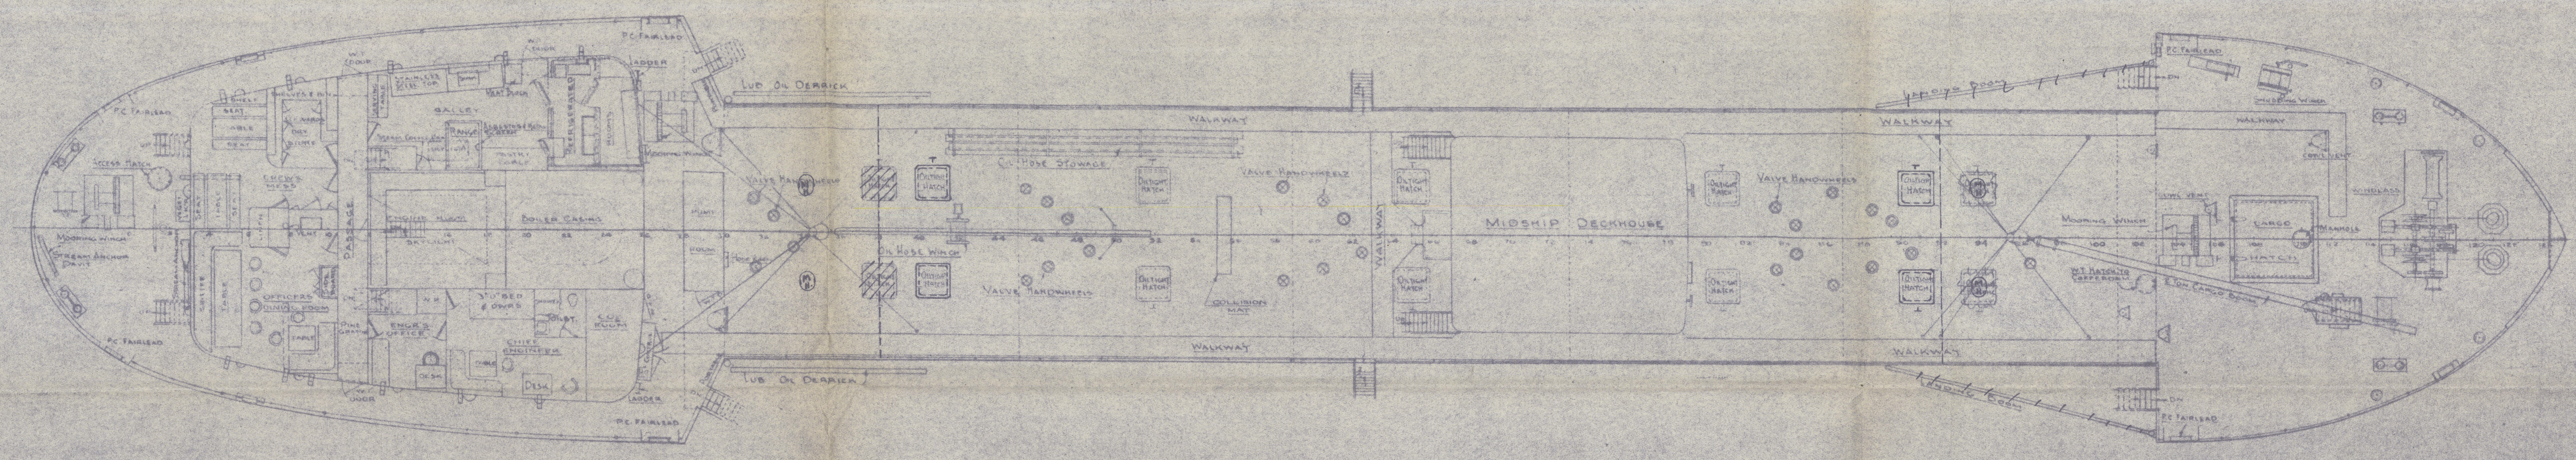

POOP DECK TRUNK TOP FORECASTLE DECK

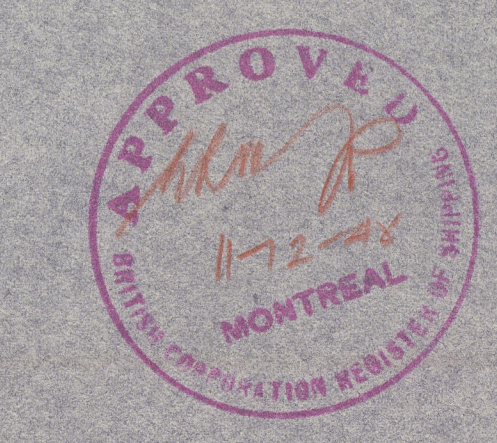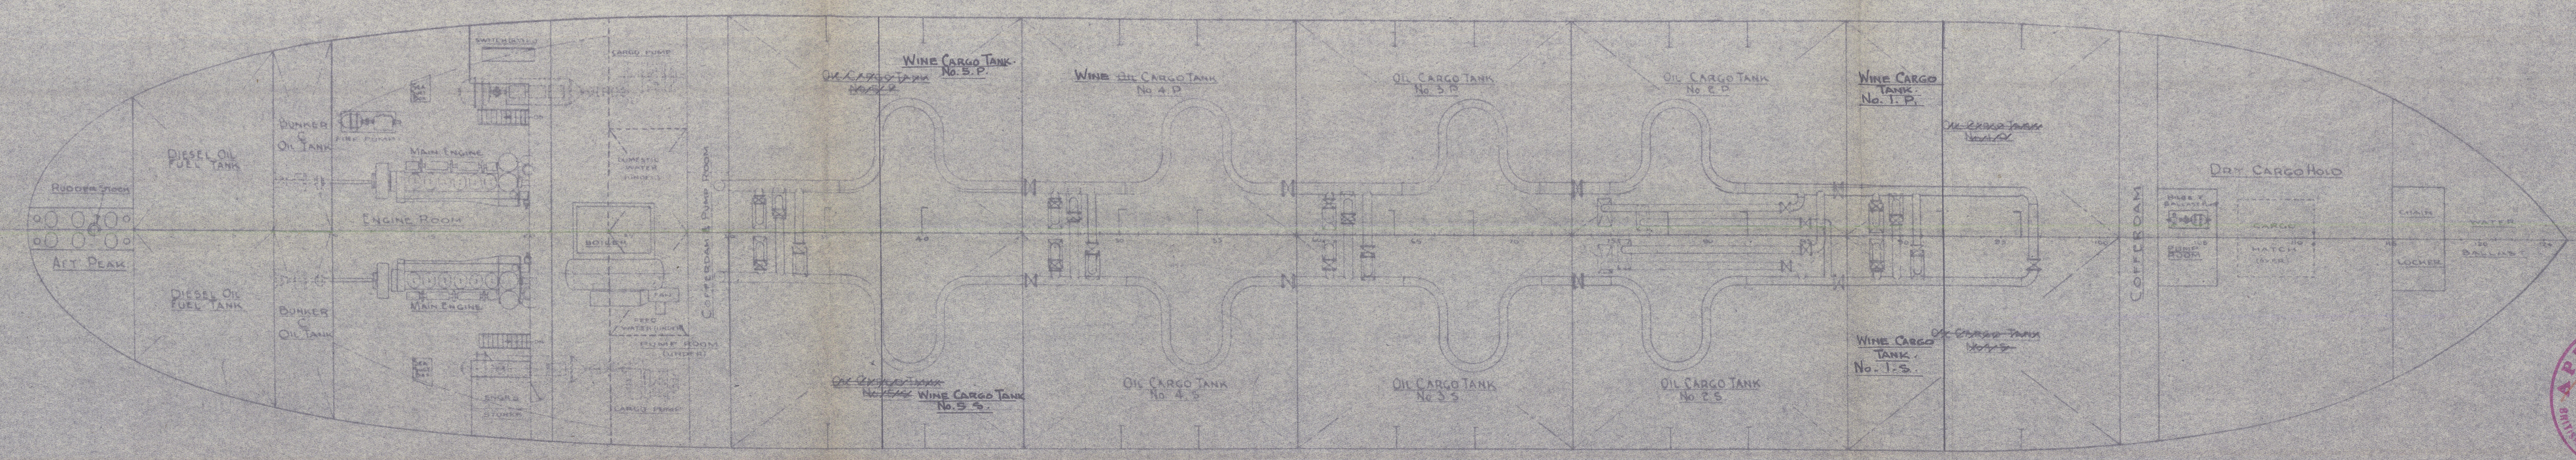

SHEET NO. 2

DESIGNED BY
 GERMAN & MILNE
 NAVAL ARCHITECTS - MONTREAL, P.Q.
 MARINE INDUSTRIES LTD.
 1172-48
 Lloyd's Register
 Foundation

DRG No. 609E

009904-009911-0131

General Arrangement (Decks)

Ocean Tanker

10 JAN 1946

Bag

0137

59A

General Arrgt - Decks.

Canadian Ocean Tankers
Montreal 18.1.46

SPRUCEBRANCH EX OTTERBURN PARK

NIPAWAN PARK X.

FIRBRANCH -
EX
MILLICAN PARK

D/S 731



© 2021

Lloyd's Register
Foundation

009904-009911-0137